
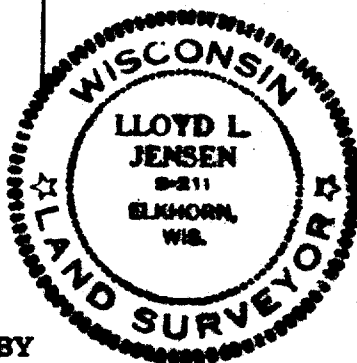


PLAT OF SURVEY

OF

LOTS 135, 137, & 139 CEDAR POINT PARK SUBDIVISION LOCATED IN THE VILLAGE OF MILLIKEN BAY, WALWORTH COUNTY, WISCONSIN.

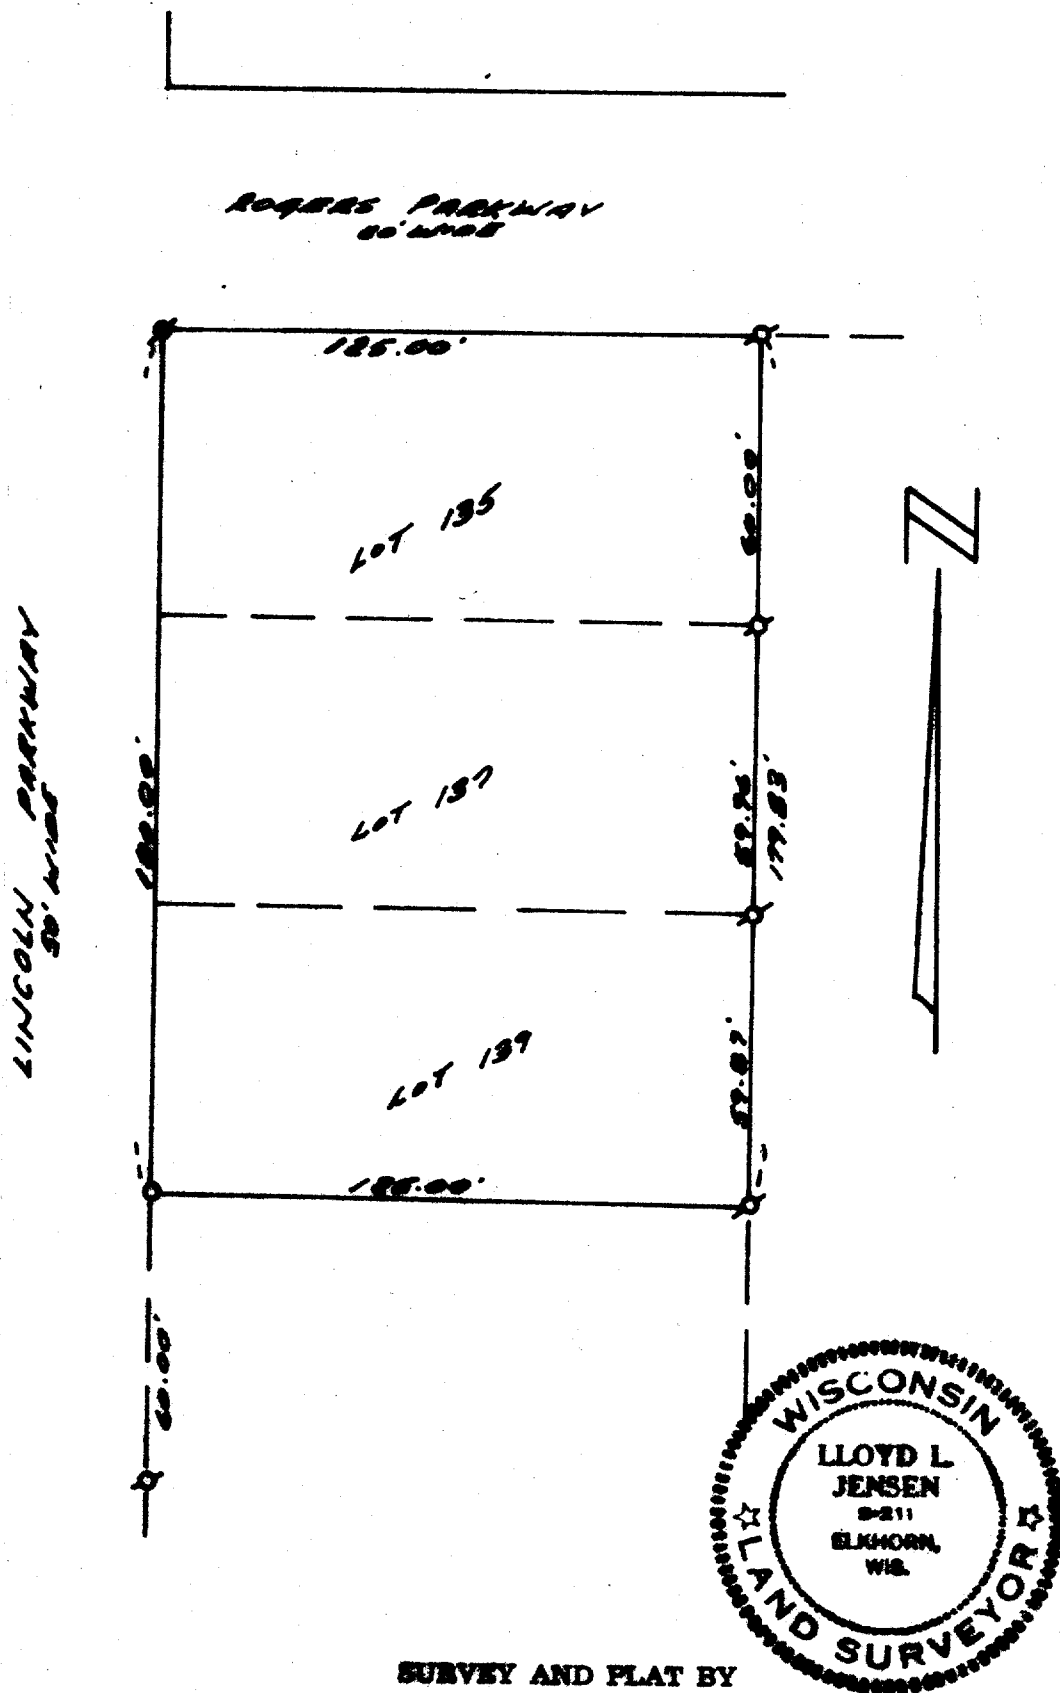

SURVEY AND PLAT BY

JENSEN & JOHNSON, INC.

CIVIL ENGINEERS AND SURVEYORS

Elkhorn, Wisconsin

LEGEND

O — Iron Pipe SET

M — Concrete Monument FOUND

Scale 1" = 40'

B — IRON PIPE FOUND

WE CERTIFY: That we have surveyed the above described property and that the plat shown herein is an accurate survey and a true representation thereof and correctly shows the exterior boundary lines and all divisions of said property.

Done at Elkhorn, Wis. this 11th day of May 1978

Lloyd L. Jensen
LLOYD L. JENSEN,

Wisconsin Registered Land Surveyor, No. 2-211

11-224 J, I