

LAND-MARK SURVEYING

Mark L. Miritz  
Wisconsin Registered Land Surveyor S-2582

N9330 Knuteson Drive  
Whitewater, WI 53190  
Phone:(262)495-3284  
FAX : (262) 495-8421  
LAND-MARKSURVEYING.COM



PLAT OF SURVEY

LOT 63 OF BAY VIEW SUBDIVISION,  
LOCATED IN THE SOUTHEAST 1/4 OF  
SECTION 1, TOWN 1 NORTH, RANGE  
16 EAST, VILLAGE OF WILLIAMS BAY,  
WALWORTH COUNTY, WISCONSIN.


ORDERED BY: SHARI RAULAND MOHR

THE RAULAND AGENCY  
118 KENOSHA STREET  
WALWORTH, WI 53184

SITE ADDRESS: 89 HIGHLAND STREET

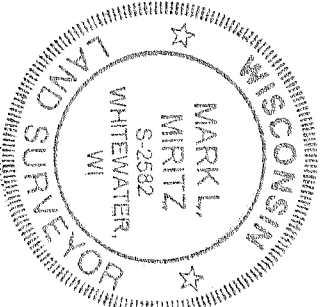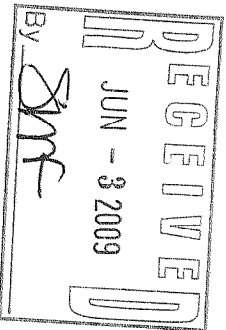

THE WEST LINE OF LOT 63  
WAS ASSUMED TO BEAR NORTH

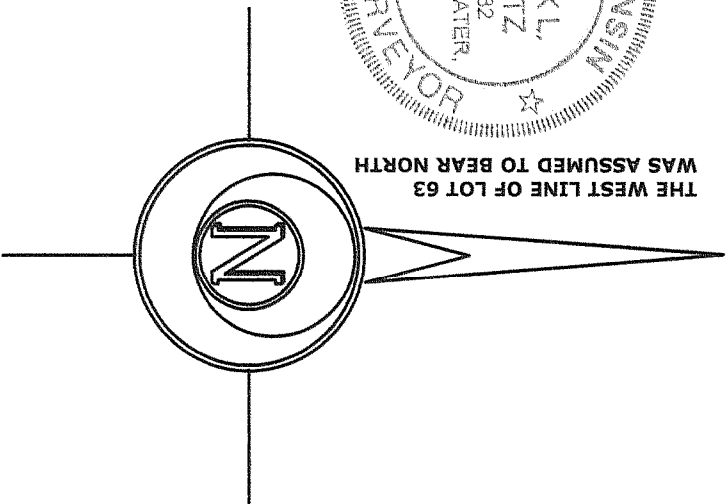

LEGEND

- FOUND IRON PIPE
- RECORDED AS DIMENSION
- EXISTING FENCE

SCALE: 1" = 20 FEET

"I hereby certify that the above described property has been surveyed by me or under my direction and that the above map is a true representation thereof and shows the size and location of the property, its exterior boundaries, the location of all visible structures and dimensions of all principal buildings thereon, boundary fences, apparent easements, roadways and visible encroachments, if any."

"This survey is made for the use of the present owners of the property, and also those who purchase, mortgage, or guarantee the title thereto within one year from date hereof."

*Mark L. Miritz*  
MARK L. MIRITZ  
WISCONSIN REGISTERED  
LAND SURVEYOR S-2582

DATE: APRIL 30, 2009 JOB NO. 09.405

HIGHLAND STREET

50' WIDE

LOT 62

LOT 63  
9,586 SQ. FT.

LOT 66

S 88°30'18" W 50.03'

N 00°17'21" E 55.66'

N 88°45'30" E 159.95' (160')

S 87°37'21" W 159.80' (160')

N 87°43'35" E 159.93' (160')

S 00°08'04" W 59.87' (60')

N 00°01'42" E 58.82' (58.22')

UNIMPROVED ALLEY 16' WIDE

SHARED GRAVEL PARKING AREA (60')

NORTH 60.16'

S 00°12'47" W 59.96' (60')

FENCE IS 0.3' N OF LINE

FENCE IS 0.6' SOUTH OF LINE

SATELLITE DISH POST ON LINE

BRICK CHIMNEY

COVERED PORCH

RESIDENCE

DECK

DECK

DECK

SHED

WBV - 35

011-22162