


PREPARED FOR
GAETANO LOLLINO
1838 N. 78th CT.
ELMWOOD PARK IL. 60707


KROTT SURVEYING INC.
N3705 WILLOW BEND LANE
LAKE GENEVA WI. 53147
PHONE # (262)248-3697
FAX # (262)249-0639

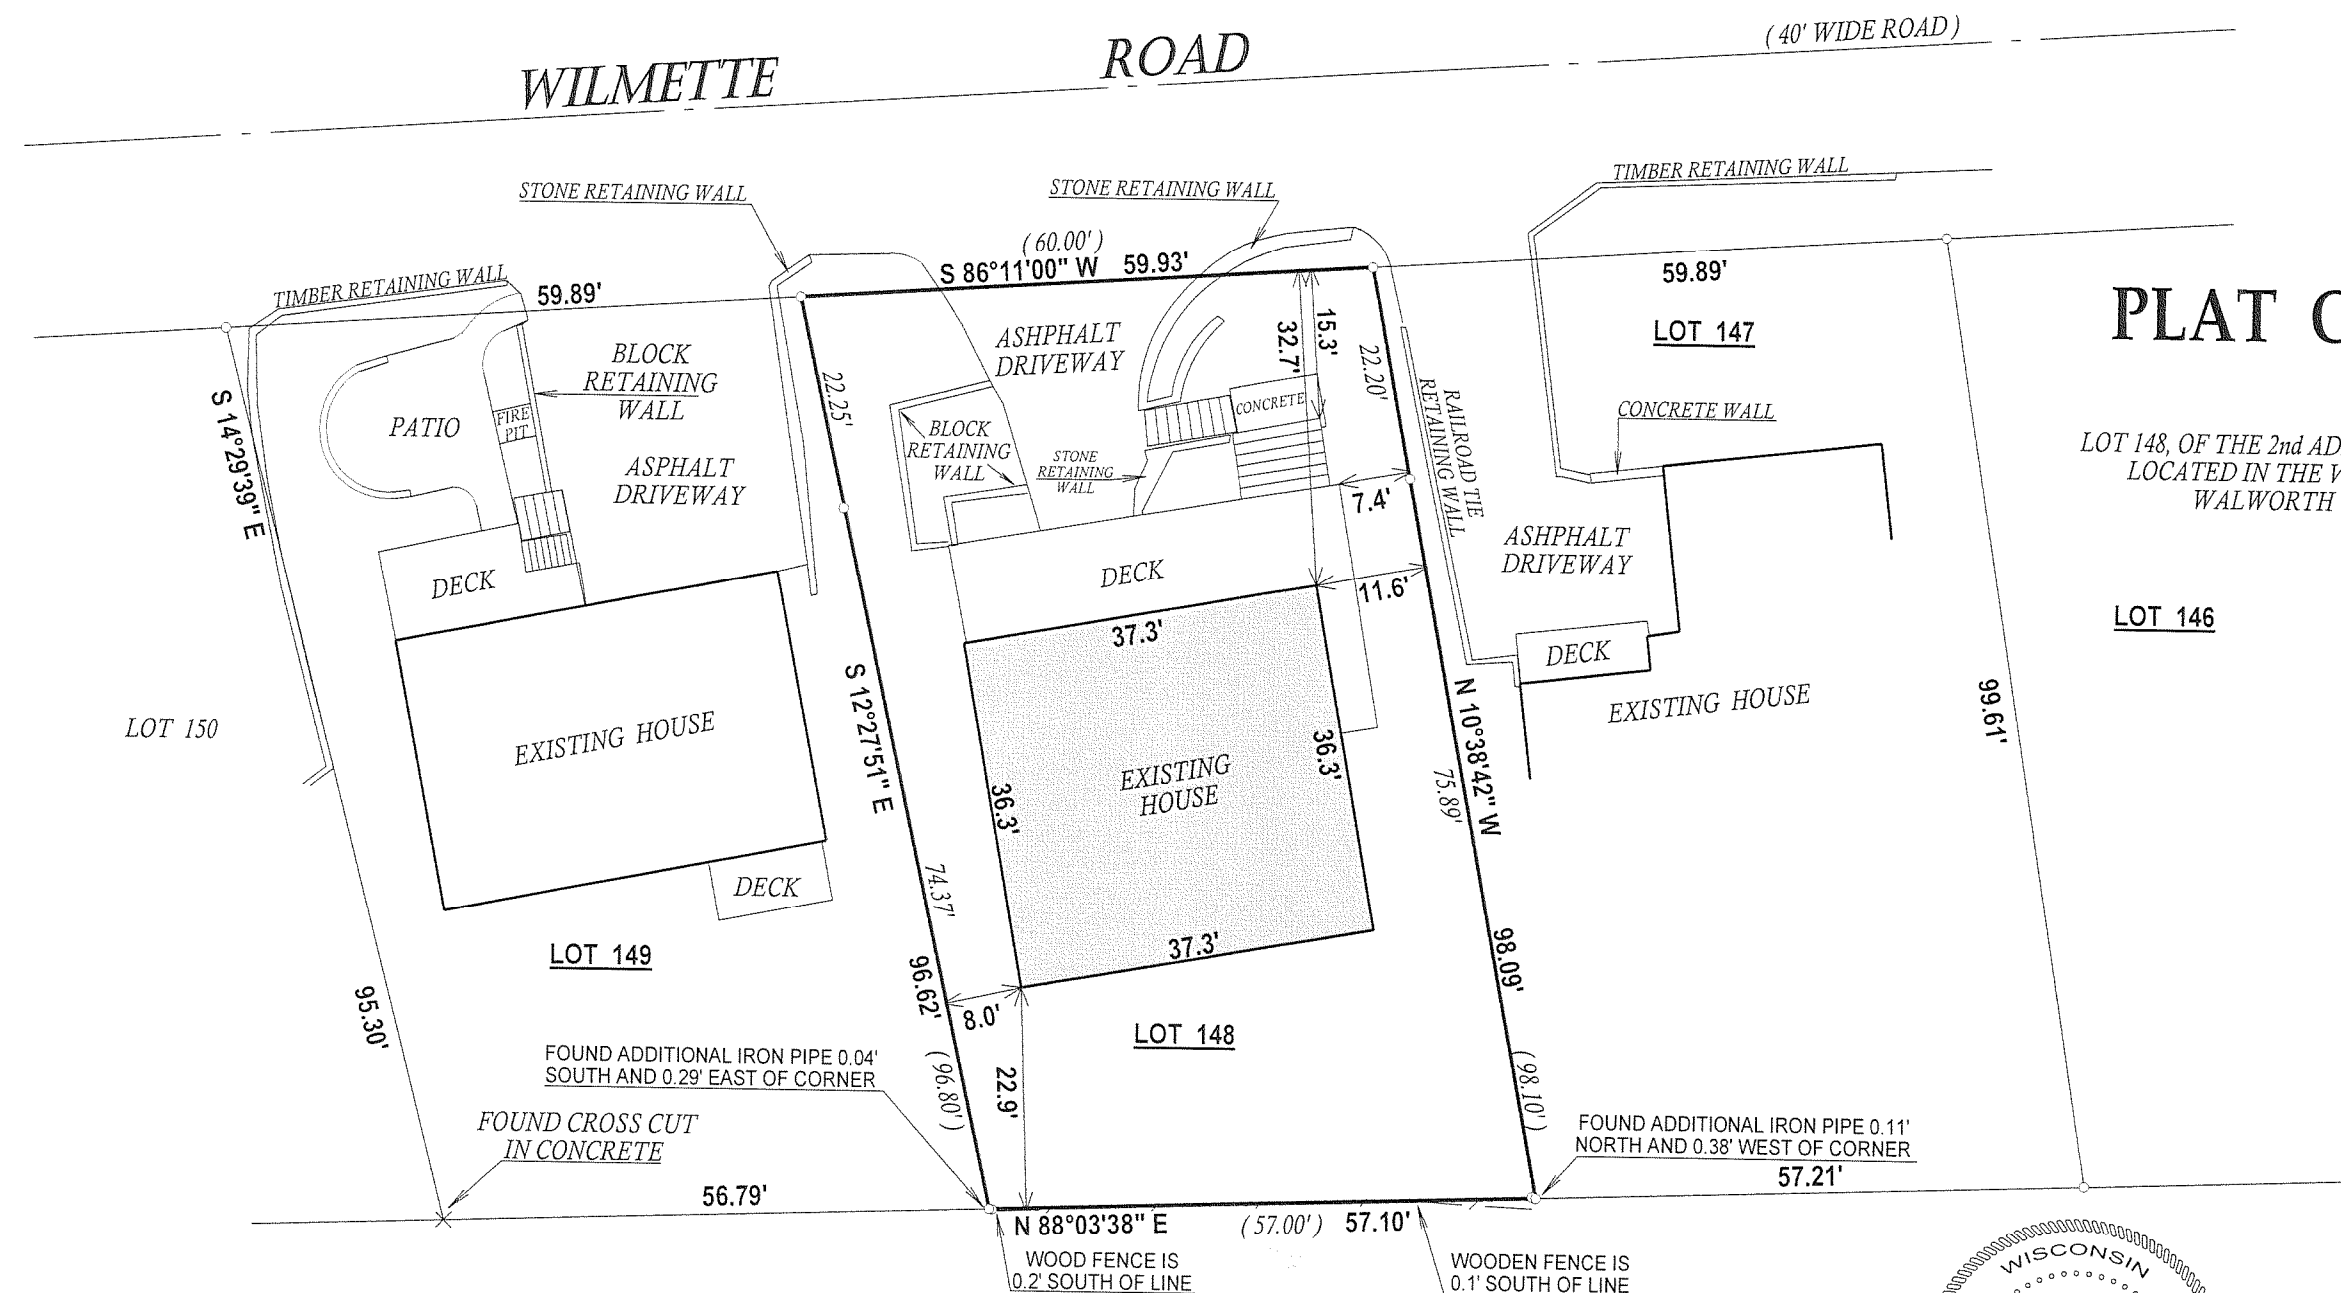

PLAT OF SURVEY

- OF -

LOT 148, OF THE 2nd ADDITION TO CEDAR POINT PARK,
LOCATED IN THE VILLAGE OF WILLIAMS BAY,
WALWORTH COUNTY, WISCONSIN.

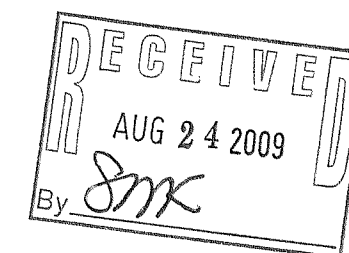

LEGEND

○ FOUND IRON PIPE

(XX) RECORDED AS


TAX ID # WCP200044

JOB # 02-194UD1

NOTE : BEARINGS ARE ASSUMED.


I have surveyed the above-described property and the above map is a true representation thereof and shows the size and location of the property, its exterior boundaries, the location and dimensions of all structures thereon, fences apparent easements and roadways and visible encroachments, if any.

This survey is made for the exclusive use of the present owners of the property, and also those who purchase, mortgage, or insure the title thereto within one (1) year from date hereof; and as to them I warrant the accuracy of said survey map.

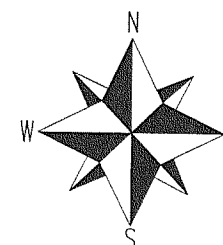

SCALE 1" = 20'

0 20 40 60

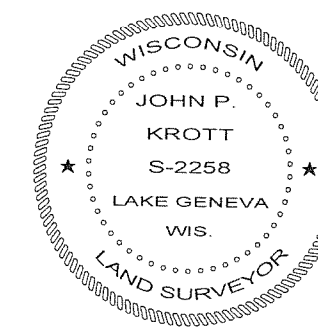

John P. Krott

JOHN KROTT S - 2258
Wisconsin Registered Land Surveyor
(original if signed in red)

DATE OF LAST REVISION AUGUST 19th, 2009.
DATED THIS 30th DAY OF APRIL 2009.

011-2277