



PLAT OF SURVEY

OF

LOTS 2 & 3 BLOCK 8 WILLIAMS 1ST ADDITION,
EXCEPT THE WEST 47.63 FEET, LOCATED IN
THE VILLAGE OF WILLIAMS BAY, WALKWORTH
COUNTY, WISCONSIN.



OLIVE ST.

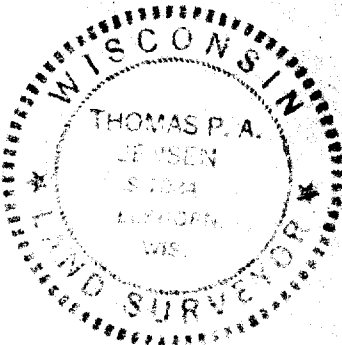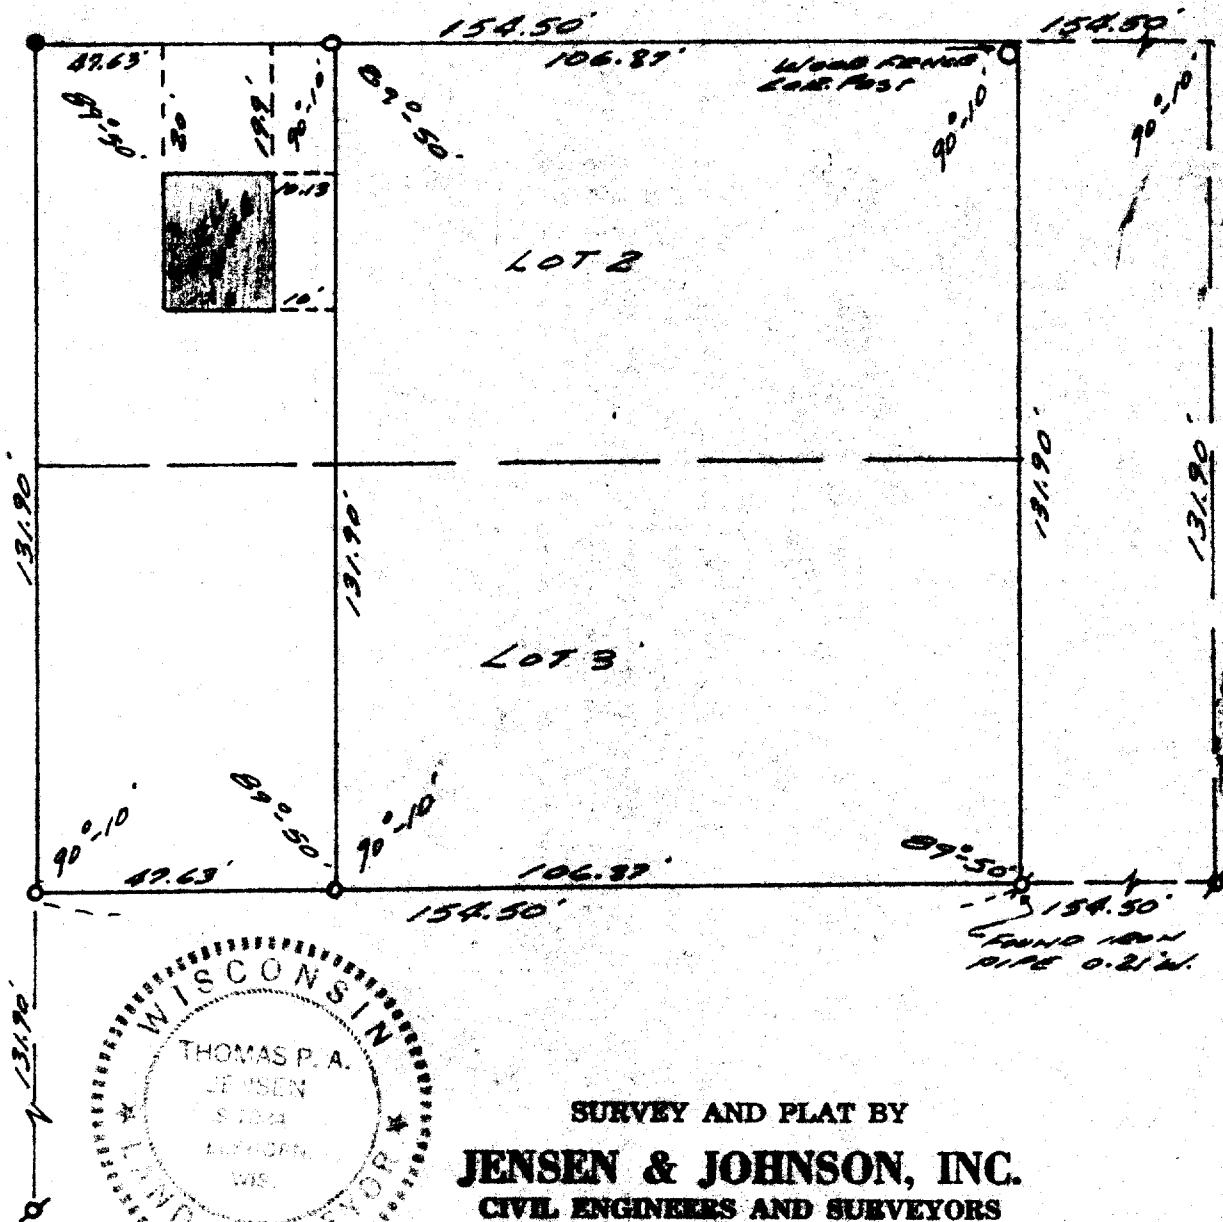

SURVEY AND PLAT BY
JENSEN & JOHNSON, INC.
CIVIL ENGINEERS AND SURVEYORS
Elkhorn, Wisconsin

LEGEND

- — Iron Pipe SET
- — Concrete Monument FOUND
- Scale 1" = 30
- ⊗ — IRON PIPE FOUND

WE CERTIFY: That we have surveyed the above described property and that the plat shown hereon is an accurate survey and a true representation thereof and correctly shows the exterior boundary lines and all divisions of said property.

Date OCT. 1998

Thomas P. A. Jensen

Wisconsin Registered Land Surveyor, No. 5-1004