


PLAT OF SURVEY

OF

LOT 14 BLOCK 17 OF
WILLIAMS 2ND ADDITION,
VILLAGE OF WILLIAMS BAY,
WALWORTH COUNTY,
WISCONSIN, EXCEPT THE
SOUTH 2.5'

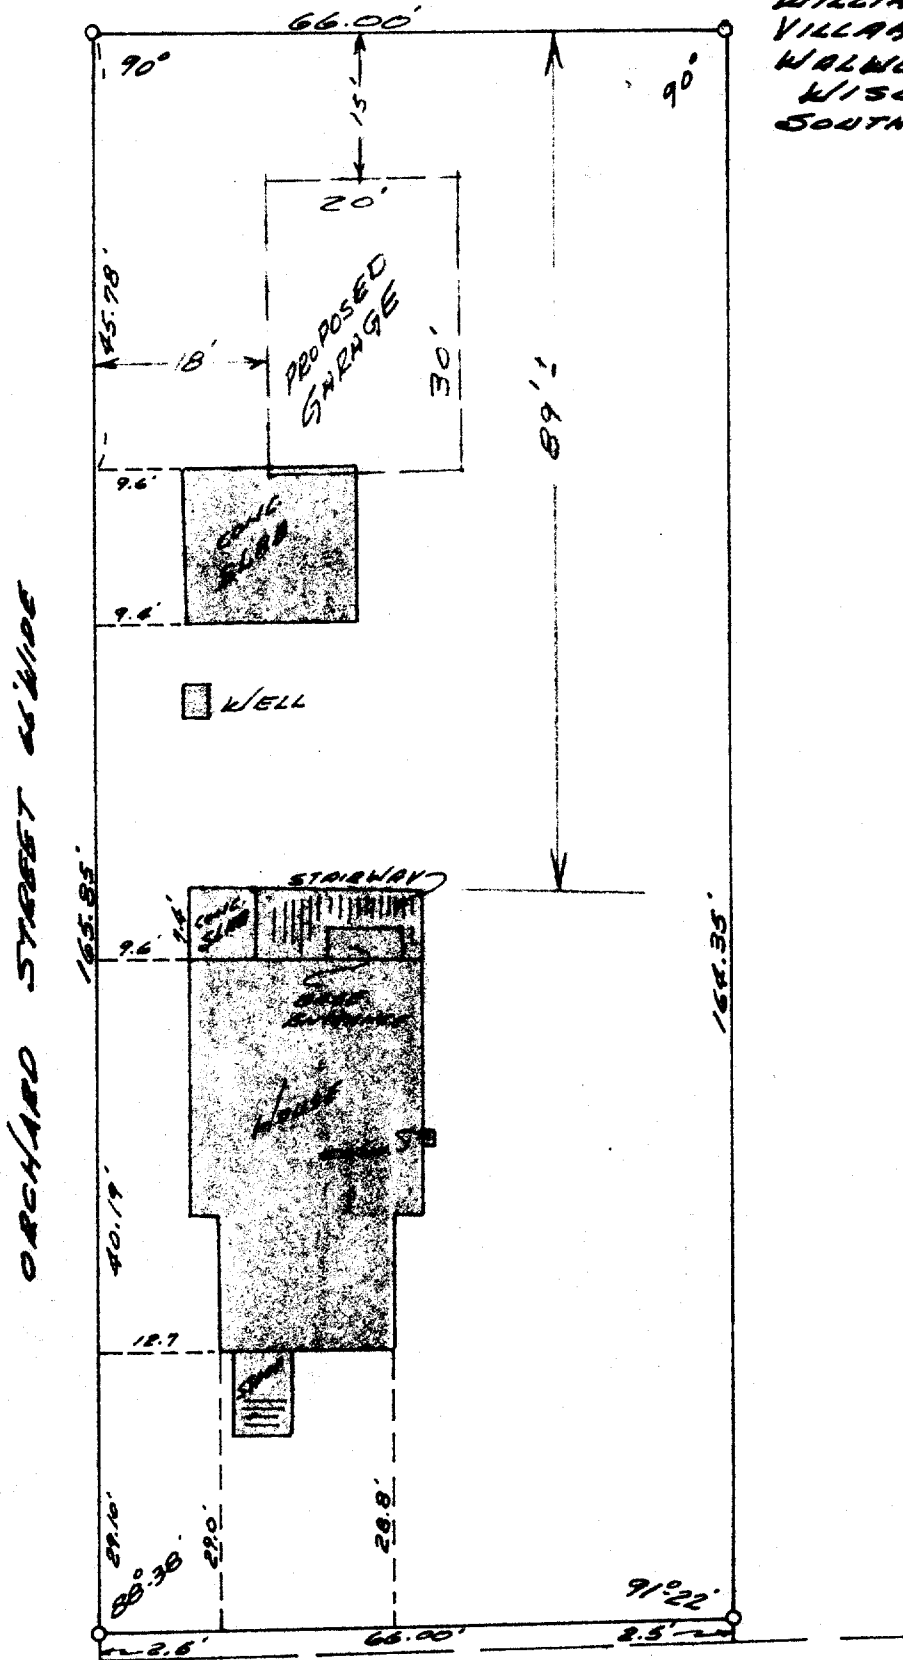

GENEVA STREET

SURVEY AND PLAT BY

JENSEN & JOHNSON, INC.

CIVIL ENGINEERS AND SURVEYORS

Elkhorn, Wisconsin

LEGEND

○ — Iron Pipe FOUND

● — Concrete Monument

Scale 1" = 20'

WE CERTIFY: That we have surveyed the above described property and that the plat shown hereon is an accurate survey and a true representation thereof and correctly shows the exterior boundary lines and all divisions of said property.

Date APRIL 15, 1971

Lloyd L. Jensen
LLOYD L. JENSEN,

Wisconsin Registered Land Surveyor, No. S-211