
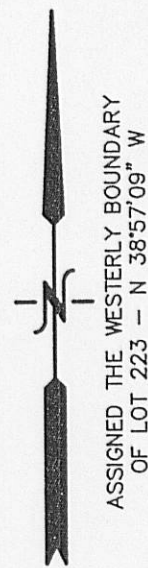


FEB 10 2010

2/10/2010 X:\Projects\8066\DCAD\SURVEY

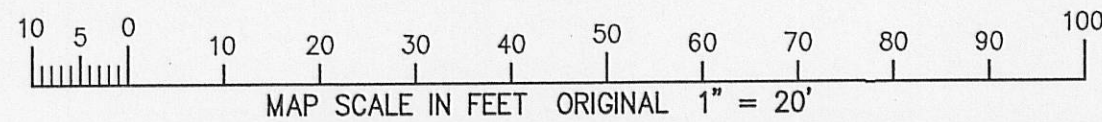

PLAT OF SURVEY

LOT 223 OF CEDAR POINT PARK SUBDIVISION

LOCATED IN PART OF THE NE 1/4 OF THE SE 1/4 OF SECTION 6,
TOWN 1 NORTH, RANGE 17 EAST, VILLAGE OF WILLIAMS BAY,
WALWORTH COUNTY, WISCONSIN

LINCOLN PARKWAY
150' WIDE R.O.W.

LOT 222

LOT 220

LOT 221
CLARENCE G. THOMPSON
MURIEL THOMPSON
628 WASHINGTON PKWY
WILLIAMS BAY, WI 53191

LOT 223
8,976 SQ. FT.
(0.21 ACRES)

LOT 224 & PART OF LOT 229
LEE SCOTT CARLSON
CYNTHIA A. CARLSON
2328 INDIAN RIDGE
GLENVIEW, IL 60025

EXISTING
RESIDENCE

EXISTING
RESIDENCE


FOUND IRON PIPE STAKE
0.1' WESTERLY OF
PROPERTY LINE

EXISTING
RESIDENCE

FOUND IRON PIPE STAKE
0.1' WESTERLY OF
PROPERTY LINE

WASHINGTON PARKWAY
150' WIDE R.O.W.

- LEGEND
- = FOUND IRON PIPE STAKE
 - = FOUND IRON REBAR STAKE
 - = FOUND IRON PIN IN CONCRETE MONUMENT
 - = LIGHT POLE LOCATED
 - △ = ANTENNA LOCATED
 - {xxx} = RECORDED AS

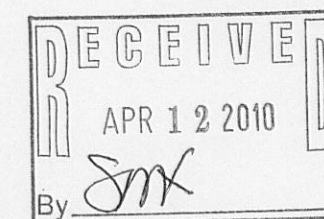


NOTE: COPIES OF THIS MAP TO WHICH THE FOLLOWING CERTIFICATE WILL APPLY SHOW THE SURVEYOR'S ORIGINAL SEAL AND SIGNATURE IN RED INK. COPIES BY ANY OTHER MEANS MAY HAVE ALTERATIONS WHICH DO NOT REPRESENT THE SURVEYOR'S WORK PRODUCT.

I HEREBY CERTIFY THAT THE ABOVE DESCRIBED PROPERTY HAS BEEN SURVEYED UNDER MY DIRECTION AND THAT THE ABOVE MAP IS A TRUE REPRESENTATION THEREOF AND SHOWS THE SIZE AND LOCATION OF THE PROPERTY AND ITS EXTERIOR BOUNDARIES. THIS SURVEY IS MADE FOR THE USE OF THE PRESENT OWNERS OF THE PROPERTY, AND ALSO THOSE WHO PURCHASE, MORTGAGE, OR GUARANTEE THE TITLE THERETO WITHIN ONE YEAR FROM THE DATE HEREOF.



DATED: 2/10/2010

PETER S. GORDON R.L.S. 2101

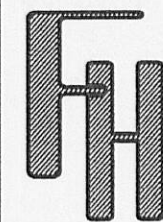

PLAT OF SURVEY

WORK ORDERED BY -
RICHARD VANEGGEREN
304 S BELMONT AVE
ARLINGTON HEIGHTS, IL 60005

FARRIS, HANSEN & ASSOCIATES, INC.
ENGINEERING - ARCHITECTURE - SURVEYING
7 RIDGWAY COURT P.O. BOX 437
ELKHORN, WISCONSIN 53121
OFFICE: (262) 723-2098 FAX: (262) 723-5886

REVISIONS

PROJECT NO.
8066
DATE:
02/10/2010
SHEET NO.
1 OF 1

WCP - 108

011-2306