


PLAT OF SURVEY


OF

LOT 21, SUMMER HAVEN SUBDIVISION, VILLAGE OF
WILLIAMS BAY, WALWORTH COUNTY, WISCONSIN

LIECHTY DRIVE

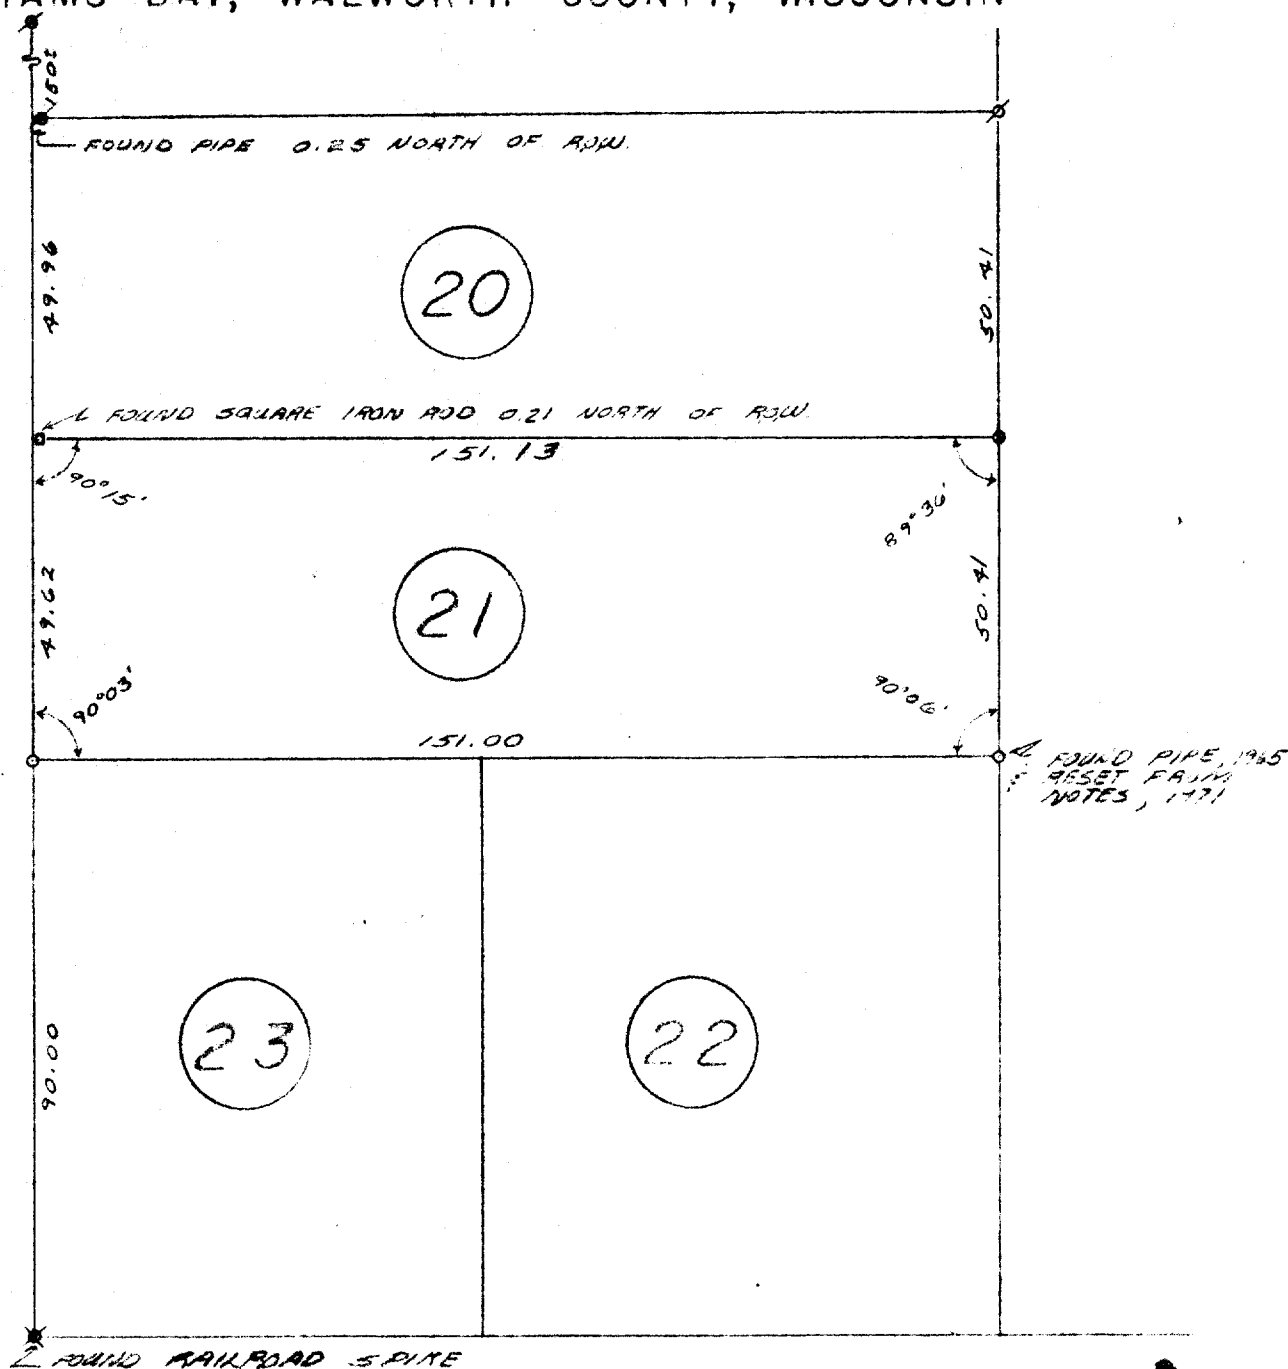

WALWORTH AVENUE

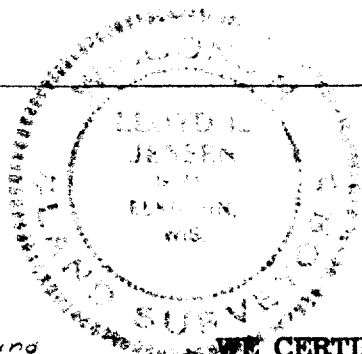

SURVEY AND PLAT BY
JENSEN & JOHNSON, INC.
CIVIL ENGINEERS AND SURVEYORS

Elkhorn, Wisconsin

LEGEND

- Ø — Iron Pipe Found
- — Concrete Monument
- Scale 1" = 30'
- o — Iron Pipe Set

WE CERTIFY: That we have surveyed the above described property and that the plat shown hereon is an accurate survey and a true representation thereof and correctly shows the exterior boundary lines and all divisions of said property.

Date Aug. 1971

Lloyd L. Jensen
LLOYD L. JENSEN,

Wisconsin Registered Land Surveyor, No. S-211