
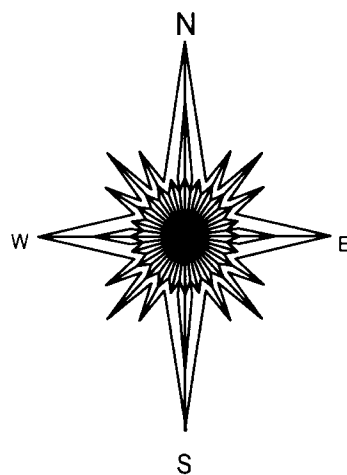


PLAT OF SURVEY

- OF -

LOT 173 CEDAR POINT PARK, A SUBDIVISION LOCATED IN THE SE 1/4 OF SECTION 6,
TOWN 1 NORTH, RANGE 17 EAST OF THE FOURTH PRINCIPAL MERIDIAN, VILLAGE
OF WILLIAMS BAY, WALWORTH COUNTY, WISCONSIN.

*PATHFINDER SURVEYING INC.
(formerly)
J.K. SURVEYING INC.
P.O BOX 322
LAKE GENEVA, WI. 53147
WWW.PATHFINDERSURVEYING.NET
262-248-8303*

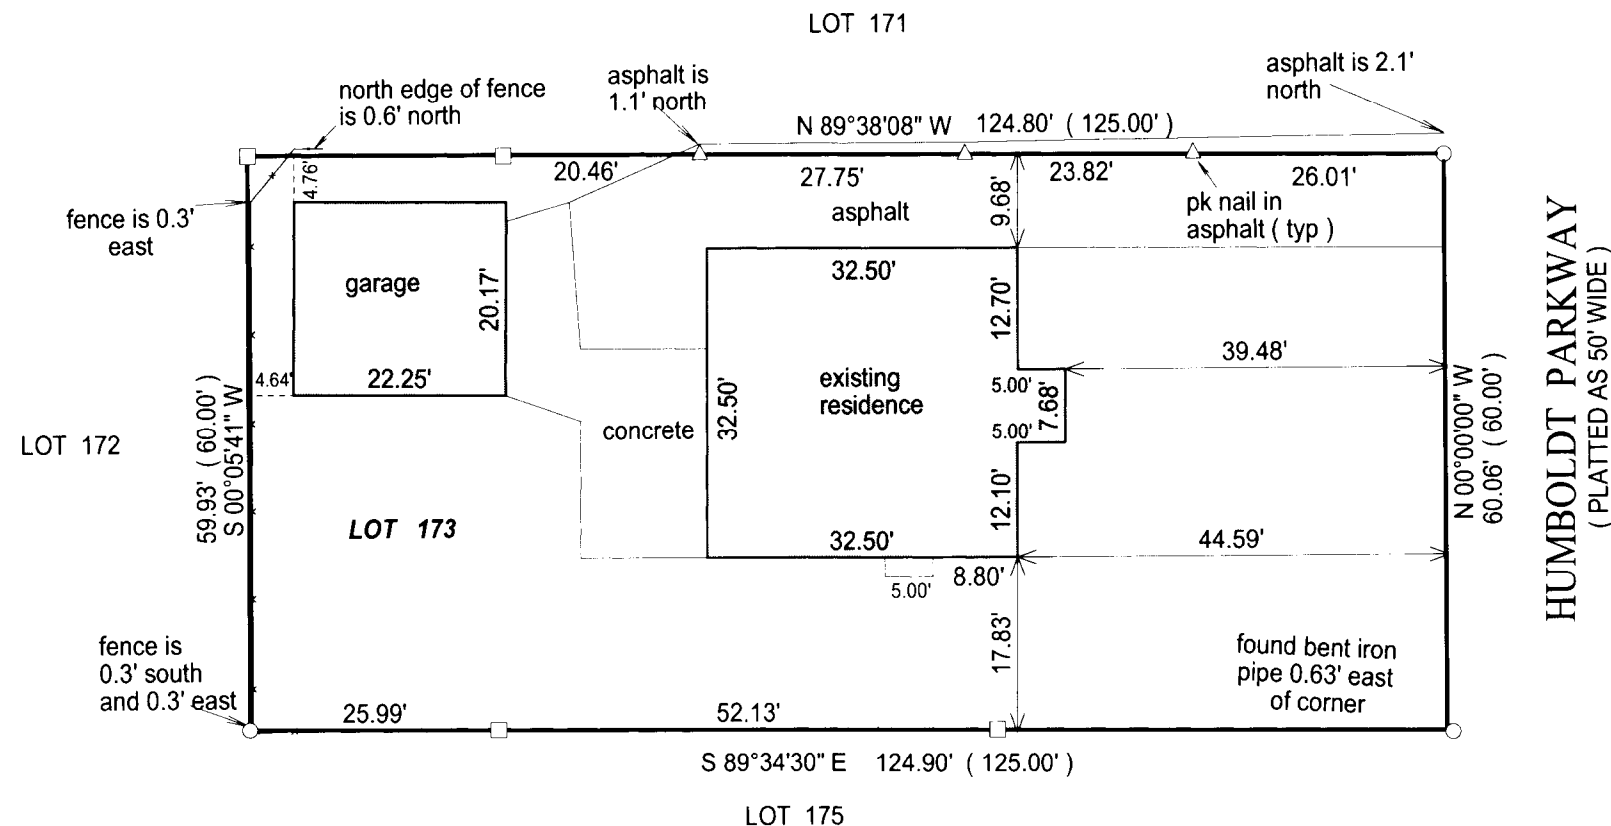

SCALE 1" = 20'

JOB # 10-130

TAX ID #

WCP 00146


Age Group	I am not a person	I am a person	I am a person	I am a person	I am a person
20	~10%	~90%	~10%	~90%	~10%
0	~10%	~90%	~10%	~90%	~10%
20	~10%	~90%	~10%	~90%	~10%
40	~10%	~90%	~10%	~90%	~10%

BASIS OF BEARING OF THIS PLAT: THE WEST LINE
OF HUMBOLDT PARKWAY WAS ASSUMED TO
BEAR NORTH / SOUTH.

"I hereby certify that I have surveyed the above described property and that the above map is a true representation of its exterior boundary and shows the size and location of all visible structures, apparent easements and encroachments if any."

This survey is made for the present owners of the property, and those who purchase, mortgage, or guarantee the title thereto, within one year from the date hereof.

DATED THIS 31ST DAY OF AUGUST 2010

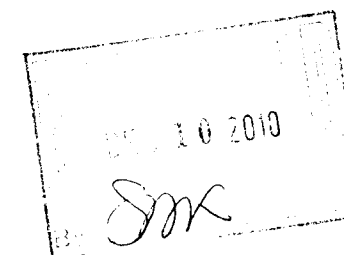

JEFFREY L KIMPS S-2436
Wisconsin Registered Land Surveyor
(original if signed in red)

011-2345