
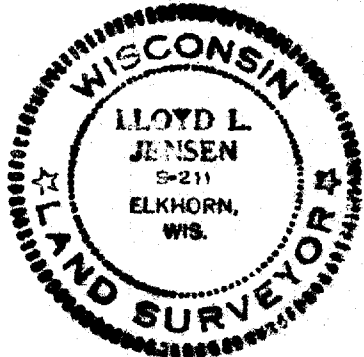


PLAT OF SURVEY

OF

LOTS 237 AND 236, AND THE NORTH
2.50 FEET OF LOT 235, THIRD
ADDITION TO CEDAR POINT PARK,
VILLAGE OF WILLIAMS BAY, WALWORTH
COUNTY, WISCONSIN.

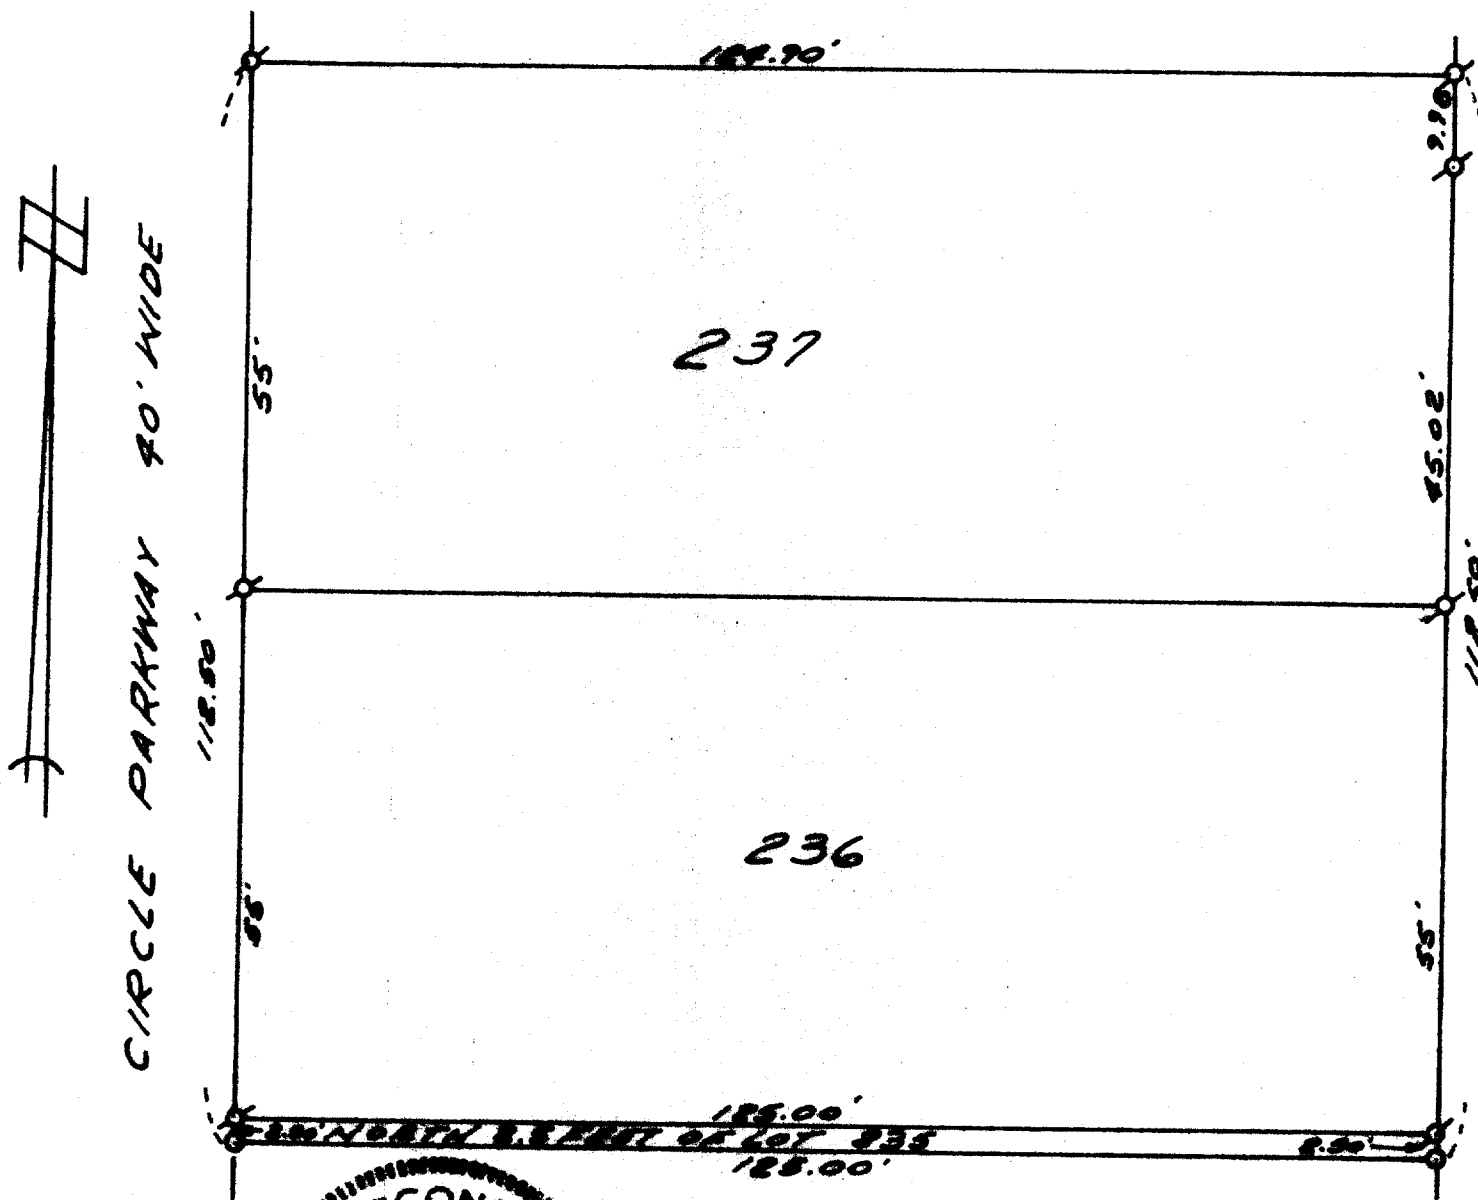

SURVEY AND PLAT BY
JENSEN & JOHNSON, INC.
CIVIL ENGINEERS AND SURVEYORS

Elkhorn, Wisconsin

LEGEND

○ — Iron Pipe 5/8"

● — Concrete Monument

Scale 1" = 20'

△ — IRON PIPE FOUND

WE CERTIFY: That we have surveyed the above described property and that the plat shown herein is an accurate survey and a true representation thereof and correctly shows the exterior boundary lines and all divisions of said property.

Date 1931 1932

Lloyd L. Jensen
LLOYD L. JENSEN,

Wisconsin Registered Land Surveyor, No. S-211

WCP3-32.31

11-234J