


**HAROLD H. KOLS**

REGISTERED PROFESSIONAL LAND SURVEYOR  
LAKE GENEVA, WISCONSIN




N

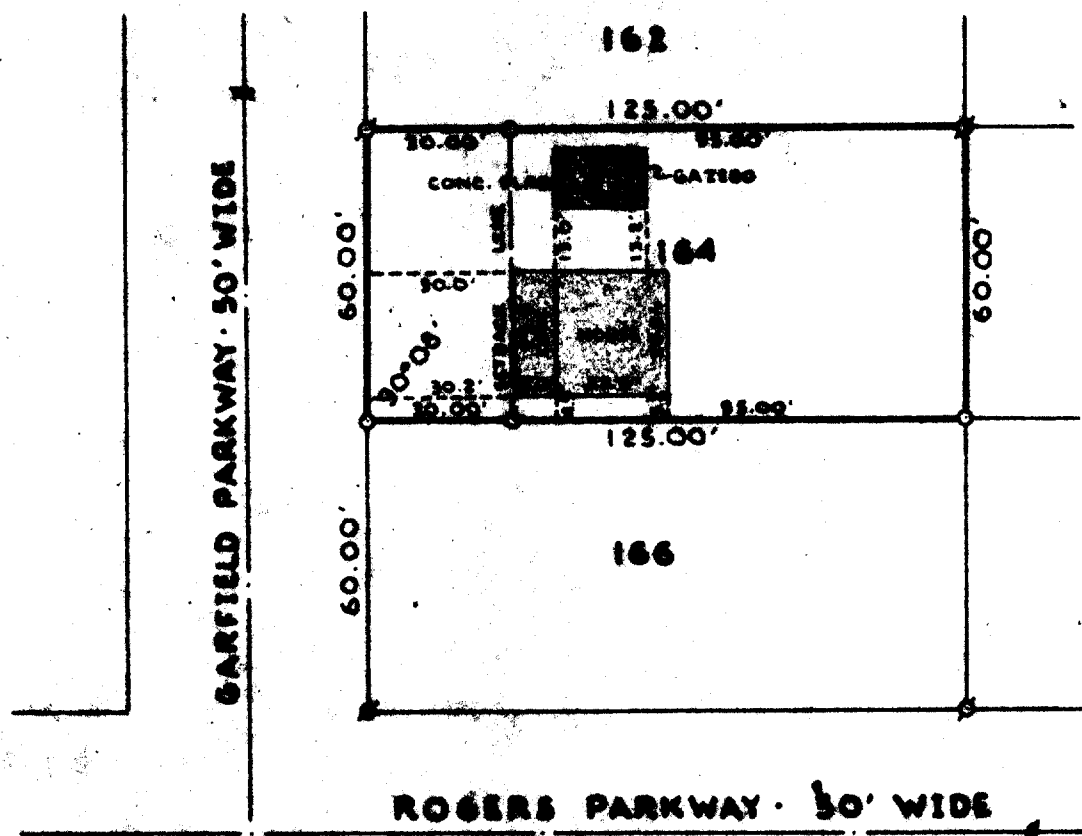

SCALE: 1"=40'

**LEGEND**

- ⊕ - IRON PIPE FOUND
- - IRON PIPE PLACED
- - CONCRETE MONUMENT FOUND
- x - SPRUCE

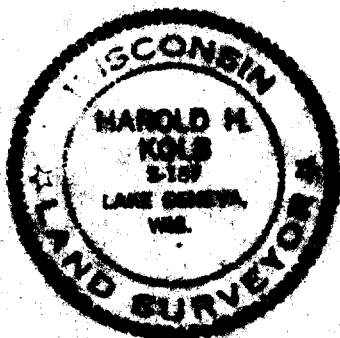

**PLAT OF SURVEY OF**

**Lot 164, Cedar Point Park, Village  
of Williams Bay, Walworth County,  
Wisconsin.**

I, HAROLD H. KOLS, DO HEREBY CERTIFY THAT I HAVE SURVEYED THE PROPERTY HEREON DESCRIBED ACCORDING TO THE OFFICIAL RECORDS, AND THAT THE PLAT HEREON IS A CORRECT REPRESENTATION OF THE LOT LINES.

*Harold H. Kols*

HAROLD H. KOLS  
WISCONSIN REGISTERED LAND SURVEYOR, S-187  
DATE MAY 1, 1973