
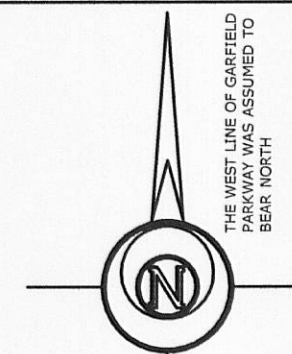


Wisconsin Registered Land Surveyor S-2582

LAND-MARKSURVEYING.COM

**LOT 170, CEDAR POINT PARK, LOCATED
IN THE VILLAGE OF WILLIAMS BAY,
WALWORTH COUNTY, WISCONSIN.**

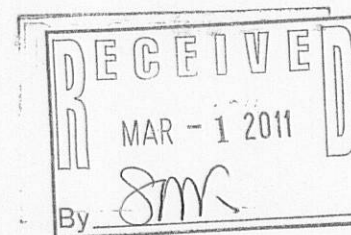

THE WEST LINE OF GARFIELD PARKWAY WAS ASSUMED TO

CENTERLINE GARFIELD PARKWAY
(50' WIDE)

LOT 168

(125)
S 89°49'55" E 124.99'

FOUND IRON ROD IS
N 64°51'14" W 0.07
FROM CORNER

TOP OF ROD
ELEV = 94.22'

GRAVEL DRIVE

BRICK WALK

COVERED PORCH

EXISTING FOUNDATION

FIRST FLOOR ELEV ASSUMED 100.0'

ROOF RIDGE ELEV = 116.1'

ROOF EAVE ELEV = 107.93'

LOT 170

7,495 SQ. FT.

57.85'
S 00°00'38" W 59.85'

LOT 171

LEGEND

SPOT ELEVATIONS

	FOUND IRON PIPE
	FOUND IRON ROD
(x x)	RECORDED AS DIMENSION

SCALE: 1" = 10 FEET

"I hereby certify that the above described property has been surveyed by me or under my direction and that the above map is a true representation thereof and shows the size and location of the property, its exterior boundaries, the location of all visible structures and dimensions of all principal buildings thereon, boundary fences, apparent easements, roadways and visible encroachments, if any."

"This survey is made for the use of the present owners of the property, and also those who purchase, mortgage, or guarantee the title thereto within one year from date hereof."

Mark L. Miritz
MARK L. MIRITZ
WISCONSIN REGISTERED
LAND SURVEYOR S-2582

DATE: AUGUST 13, 2010 JOB NO. 10.802

LOT 172

N 89°56'12" W 124.98'
(125')

TOP OF ROD
ELEV = 92.97

FOUND ADDITIONAL PIPE
N 65°44'28" W 0.40'
FROM CORNER

WCP-143

011-2350