

PREPARED FOR:
BOB PARKER
P.O. BOX 687
WILLIAMS BAY, WI
53191

PLAT OF SURVEY

-OF-

LOT 41 OF LACKEY BROTHERS SUBDIVISION, ALSO KNOWN AS
OAKWOOD ESTATES, IN THE VILLAGE OF WILLIAMS BAY,
WALWORTH COUNTY, WISCONSIN.

KROTT SURVEYING INC.
N3705 WILLOW BEND LANE
LAKE GENEVA WI. 53147
PHONE # (262)248-3697
FAX # (262)249-0639

LEGEND

===== EDGE OF PAVEMENT

○ FOUND IRON PIPE




● FOUND CONCRETE MONUMENT

(xx) RECORDED AS

JOB #11-028 TAX ID # WLB00040


I have surveyed the above-described property and the above map is a true representation thereof and shows the size and location of the property, its exterior boundaries, the location and dimensions of all structures thereon, fences apparent easements and roadways and visible encroachments, if any.

This survey is made for the exclusive use of the present owners of the property, and also those who purchase, mortgage, or insure the title thereto within one (1) year from date hereof, and as to them I warrant the accuracy of said survey map.

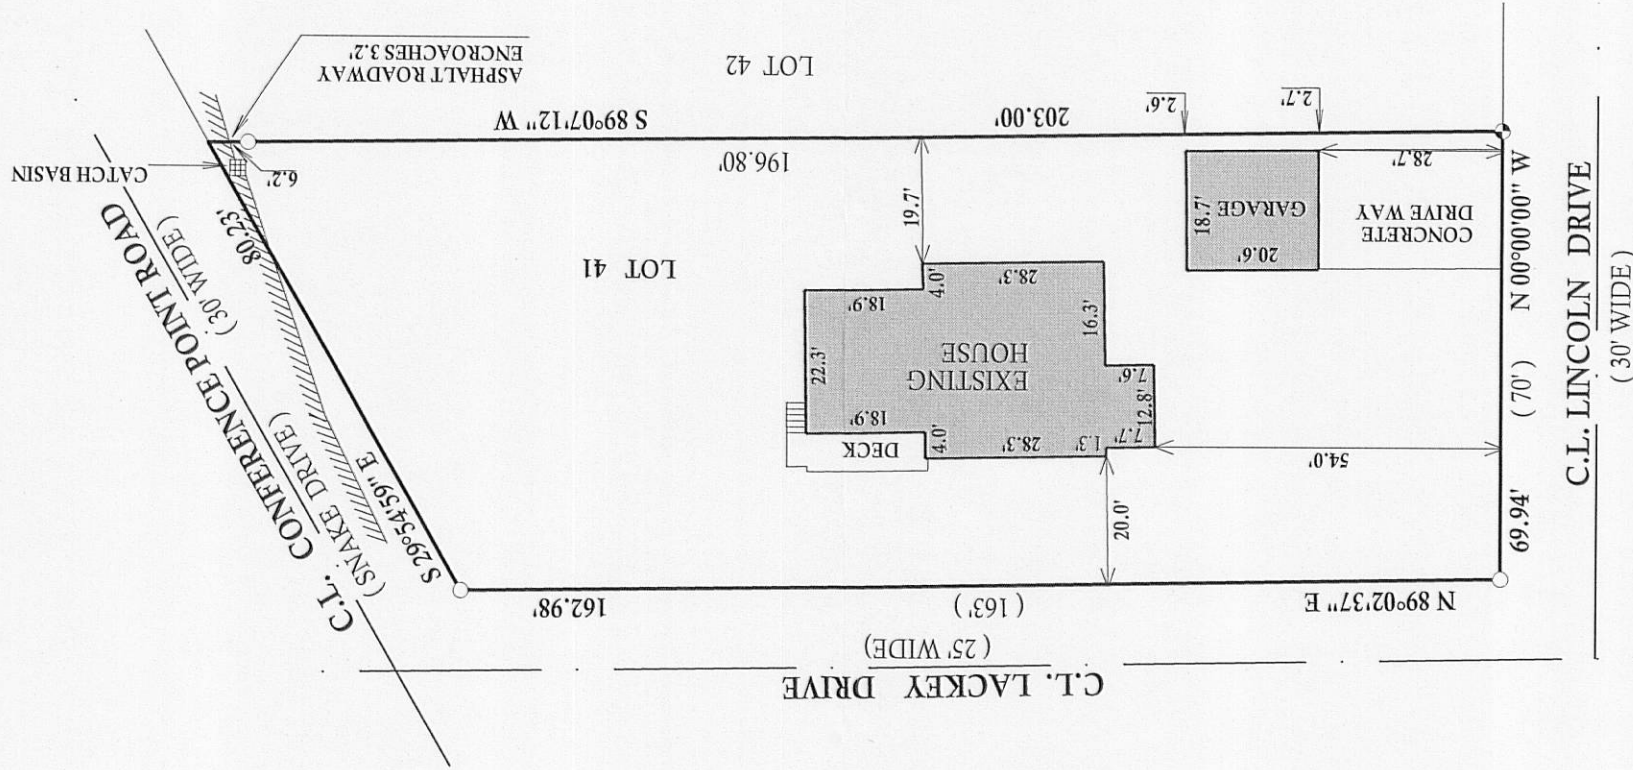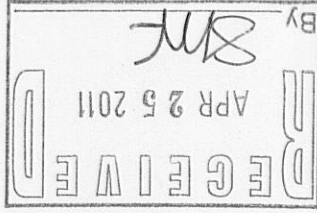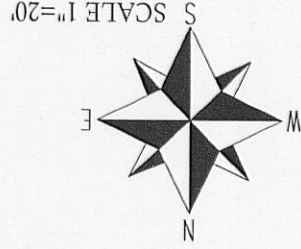

DATED THIS 3rd, DAY OF MARCH, 2011

John P. Krott
JOHN P. KROTT S - 22558
Wisconsin Registered Land Surveyor
(original if signed in red)

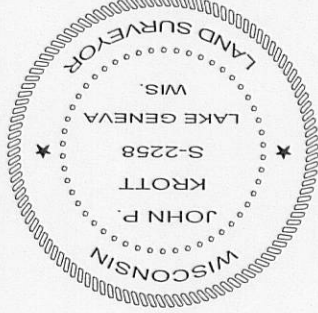

011-9829