

PREPARED FOR  
LINDA TONGE  
KEEFE REAL ESTATE, INC.  
751 GENEVA PARKWAY  
LAKE GENEVA, WI 53147




PLAT OF SURVEY

-OF-


KROTT SURVEYING INC.

N3705 WILLOW BEND LANE  
LAKE GENEVA WI. 53147  
PHONE # (262)248-3697  
FAX # (262)249-0639

LOT 3, EXCEPT THE NORTH 10 FEET THEREOF AND THE WEST 37 FEET  
OF LOT 2, EXCEPT THE NORTH 10 FEET THEREOF, IN MADISON'S  
ADDITION TO WILLIAMS BAY, BEING A PART OF THE NORTHEAST 1/4  
OF SECTION 1, IN TOWNSHIP 1 NORTH, RANGE 16 EAST, IN THE VILLAGE  
OF WILLIAMS BAY, WALWORTH COUNTY, WISCONSIN.

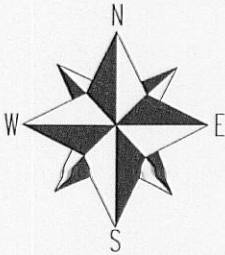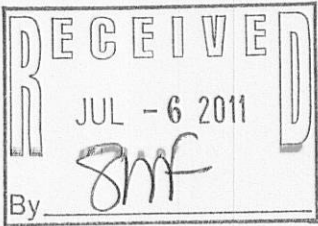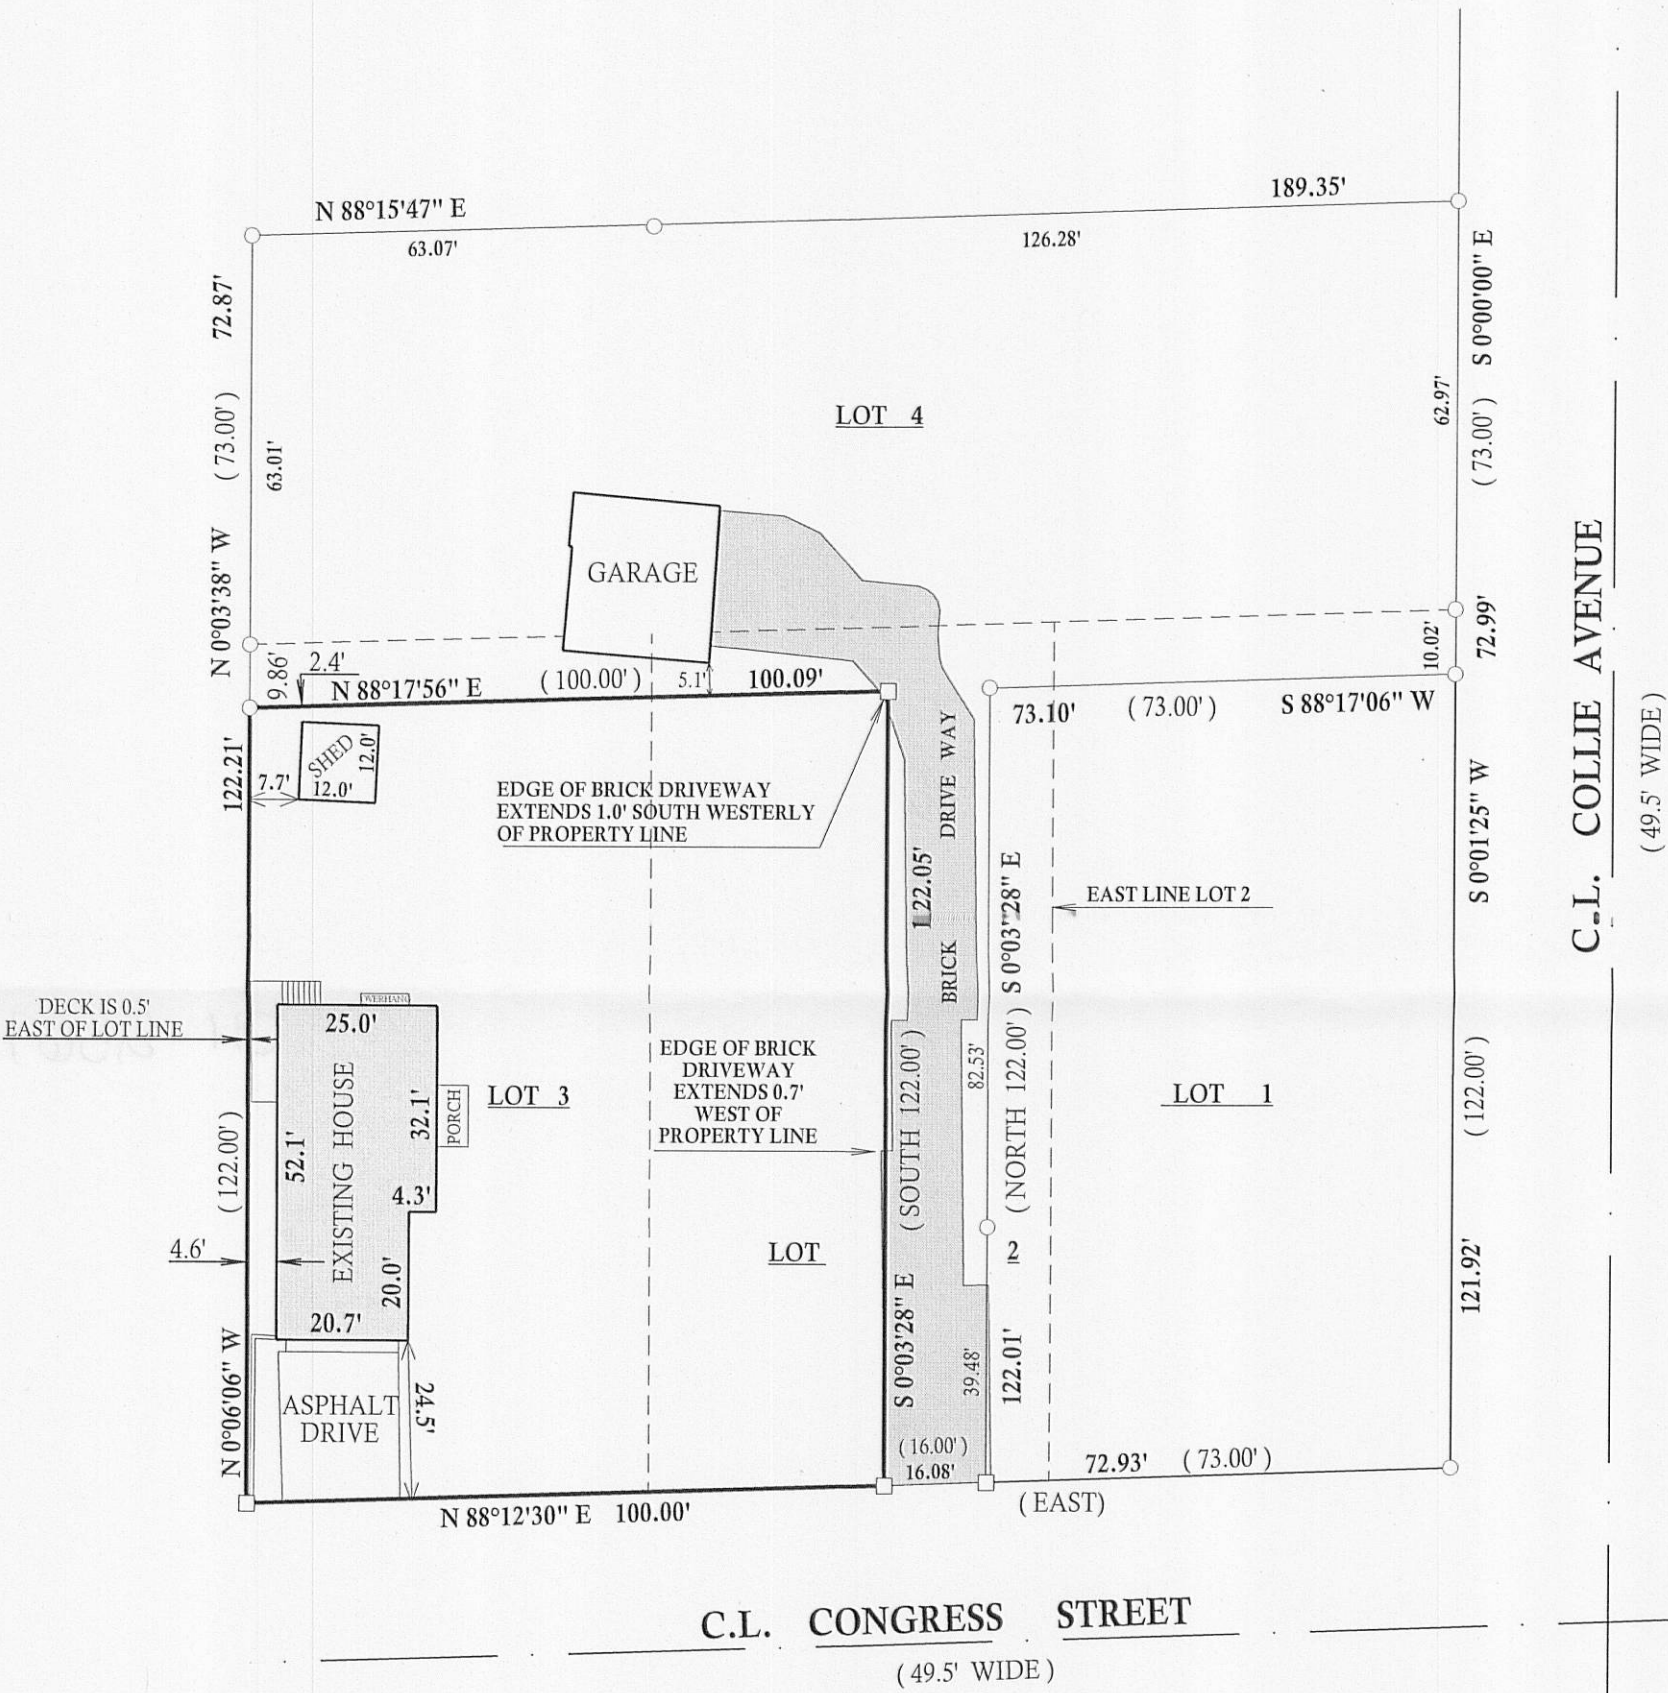

SCALE 1"=30'

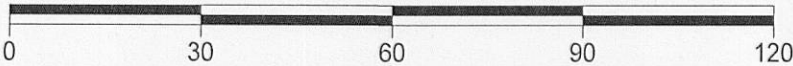

I have surveyed the above-described property and the above map is a true representation thereof and shows the size and location of the property, its exterior boundaries, the location and dimensions of all structures thereon, fences apparent easements and roadways and visible encroachments, if any.

This survey is made for the exclusive use of the present owners of the property, and also those who purchase, mortgage, or insure the title thereto within one (1) year from date hereof; and as to them I warrant the accuracy of said survey map.

NOTE: BEARINGS ARE REFERENCED TO PREVIOUS SURVEYS OF RECORD



DATED THIS 17th, DAY OF MAY, 2011

*John P. Krott*

JOHN KROTT S - 2258  
Wisconsin Registered Land Surveyor  
(original if signed in red)

LEGEND

- FOUND IRON PIPE
- FOUND IRON BAR

(XX) RECORDED AS  
TAX ID # WMA00003  
JOB # 11-071

011-2367