


OF

Hand-drawn survey map of a rectangular lot. The lot is labeled "SOUTH 1/2 OF LOT 10". The lot is bounded by a road on the left and bottom. The road is labeled "E ROAD" and "30' WIDE". The lot dimensions are: top boundary 127.4', right boundary 151.00', bottom boundary 127.3' and 127.4', and left boundary 151.00'. The lot is divided into two sections by a line labeled "150.68". The top section is labeled "180.00" and "180.00" and "180.00" and "180.00". The bottom section is labeled "180.00" and "180.00" and "180.00" and "180.00". The lot is also labeled "92°-14'" at the top-right and bottom-left corners.

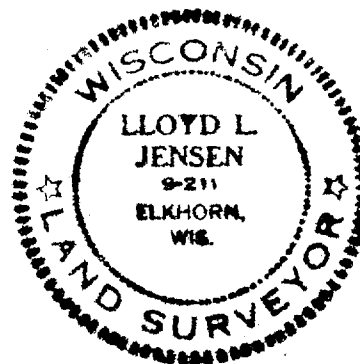

Elkhorn, Wisconsin

0 — Iron Pipe SET
● — Concrete Monument
Scale 1" = 30'
X — IRON PIPE FOUND

Date Oct. 1970

Lloyd L. Jensen
LLOYD L. JENSEN,

Wisconsin Registered Land Surveyor, No. S-211