



PREPARED FOR  
KATHERINE BAUMBACH  
SHOREWEST REALTORS  
623 MAIN STREET  
LAKE GENEVA WI. 53147

# PLAT OF SURVEY



-OF-

LOT 10, BETHEL BLOCK, A SUBDIVISION LOCATED IN THE NORTHEAST 1/4  
OF SECTION 1, TOWN 1 NORTH, RANGE 16 EAST, VILLAGE OF WILLIAMS BAY,  
WALWORTH COUNTY, WISCONSIN.


KROTT SURVEYING INC.  
N3705 WILLOW BEND LANE  
LAKE GENEVA WI. 53147  
PHONE # (262)248-3697  
FAX # (262)249-0639

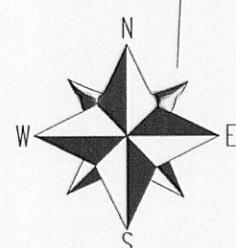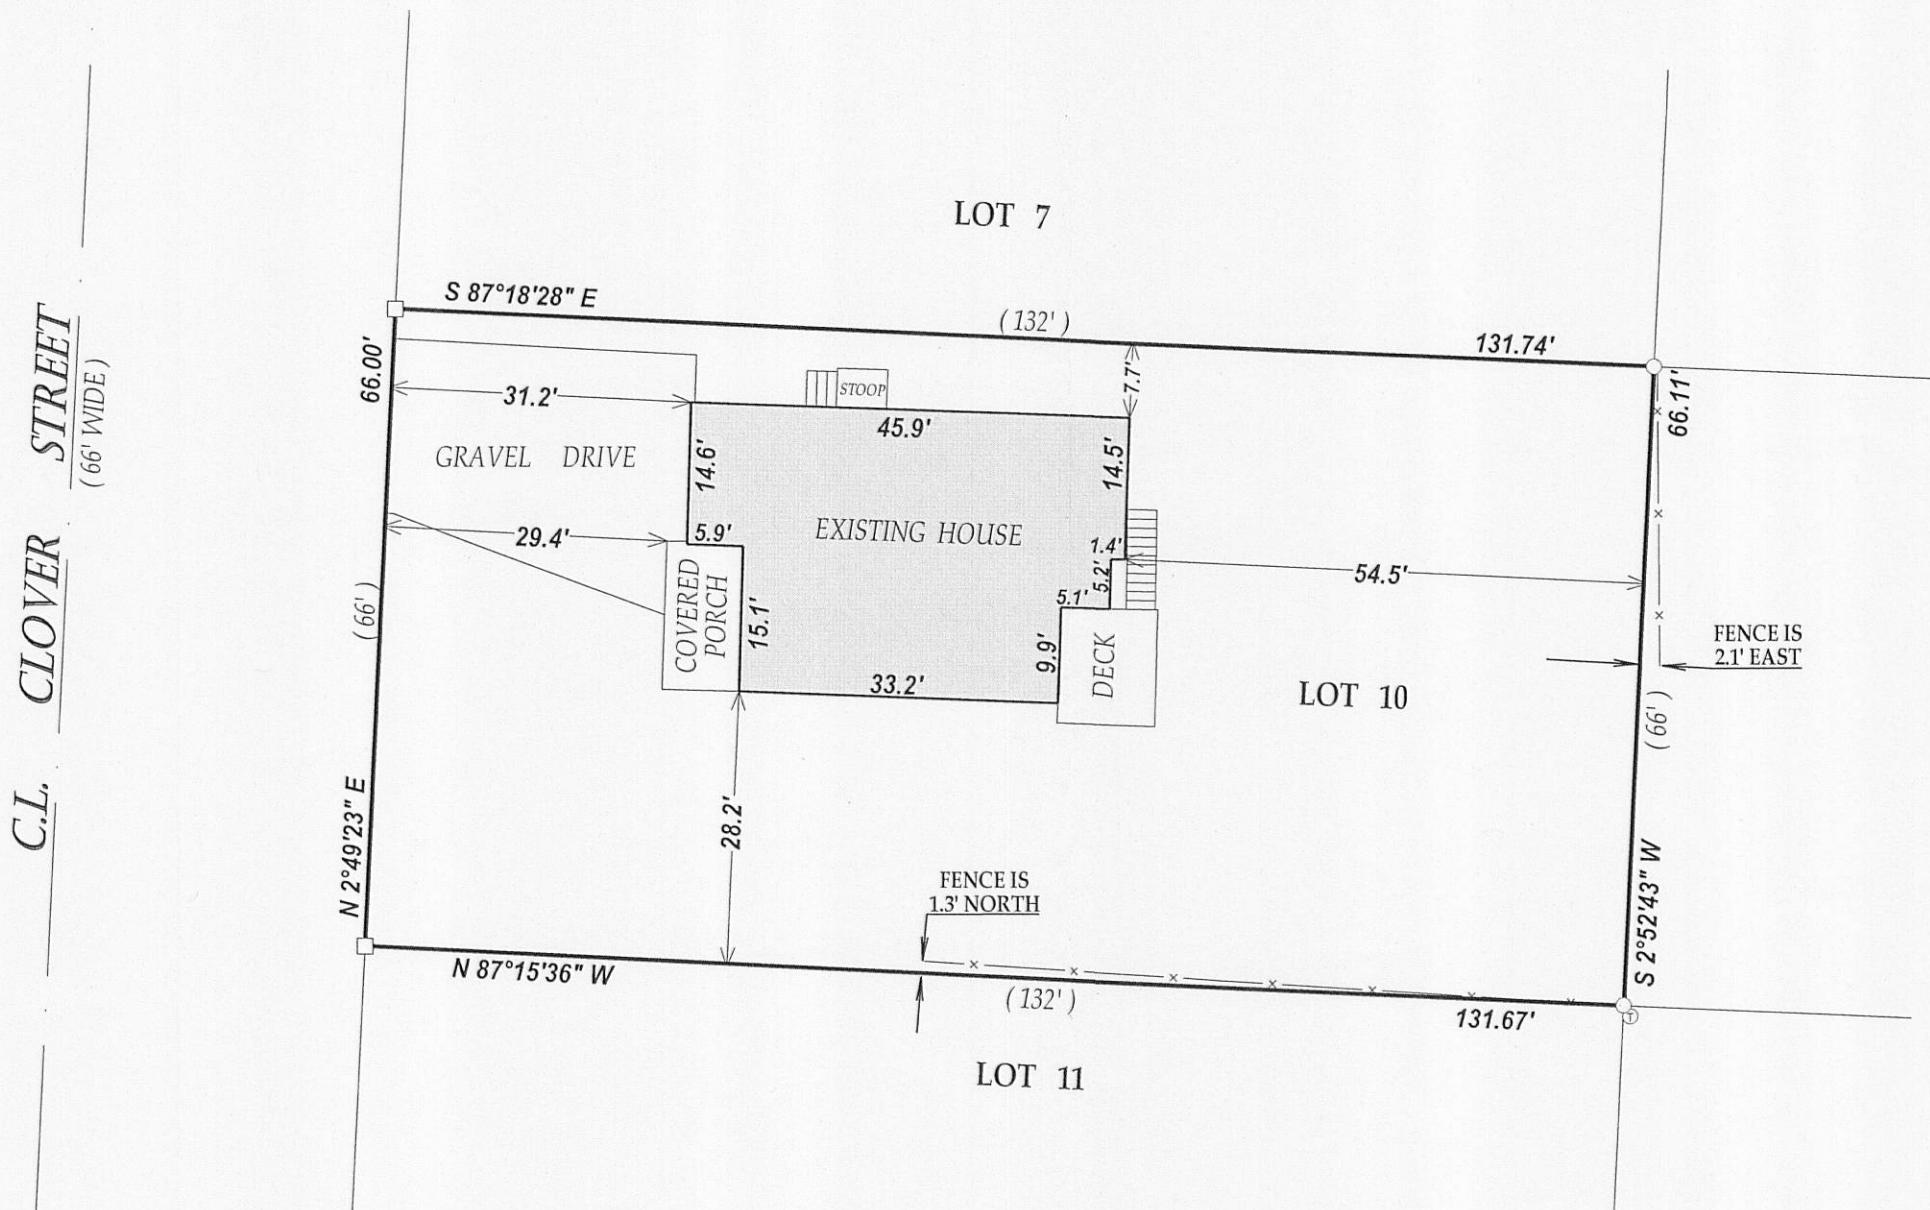

SCALE 1"=20'  
0 20 40 60

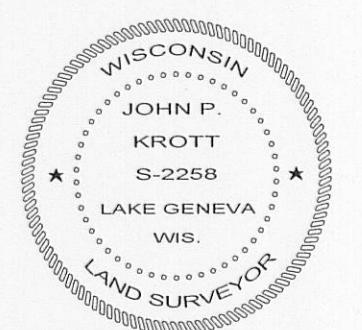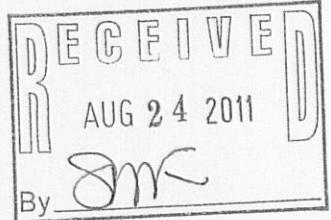

DATED THIS 21st DAY OF JULY 2011.

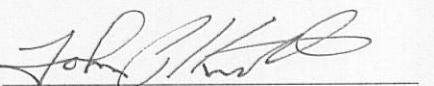  
JOHN KROTT S-2258  
Wisconsin Registered Land Surveyor  
(original if signed in red)

011-2376