
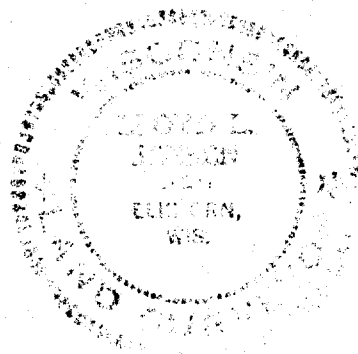


PLAT OF SURVEY

OF

LOT 16 BLOCK NO. 3 OF HARBOR
VIEW SUBDIVISION, SECTION 6
TIN RITE, WILLIAMS BAY, WISCONSIN.

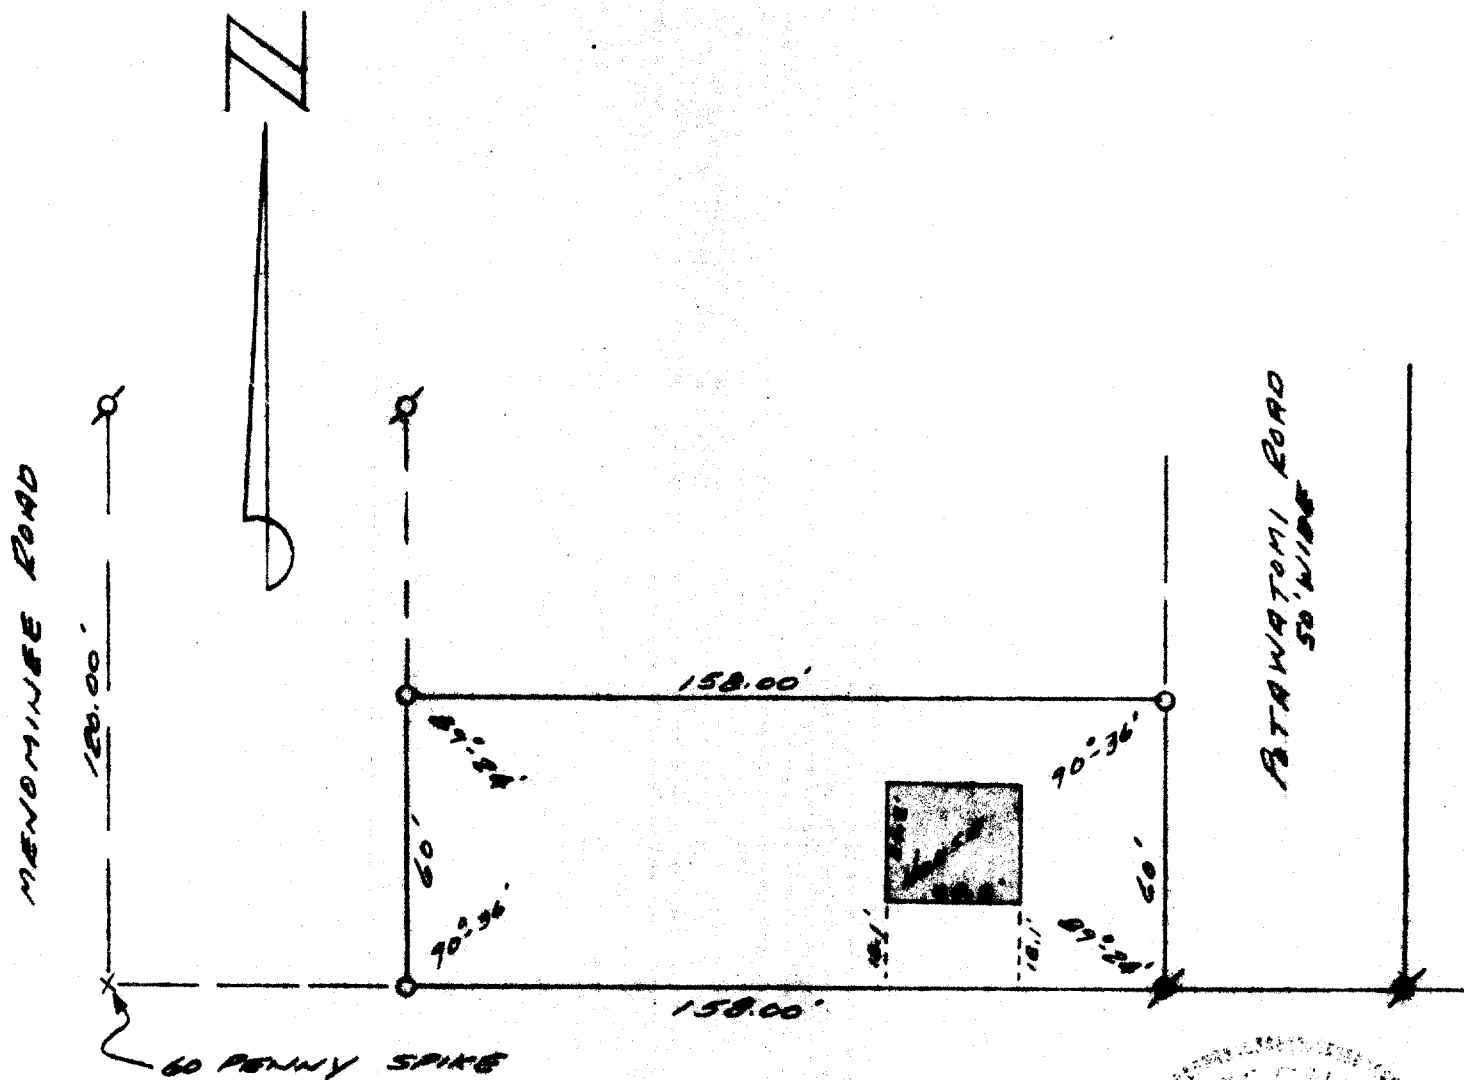

SURVEY AND PLAT BY
JENSEN & JOHNSON, INC.
CIVIL ENGINEERS AND SURVEYORS

Madison, Wisconsin

LEGEND

- — Iron Pipe
- ✕ — Concrete Monument
- Scale 1" = 40'

WE CERTIFY That we have surveyed the above described property and that the plat shown herein is an accurate survey and a true representation thereof and correctly shows the exterior boundary lines and all divisions of said property.

Date: March 1, 1934

Lloyd L. Jensen
LOYD L. JENSEN

Wisconsin Registered Land Surveyor, No. 2-312

W4V-45

11-2373