


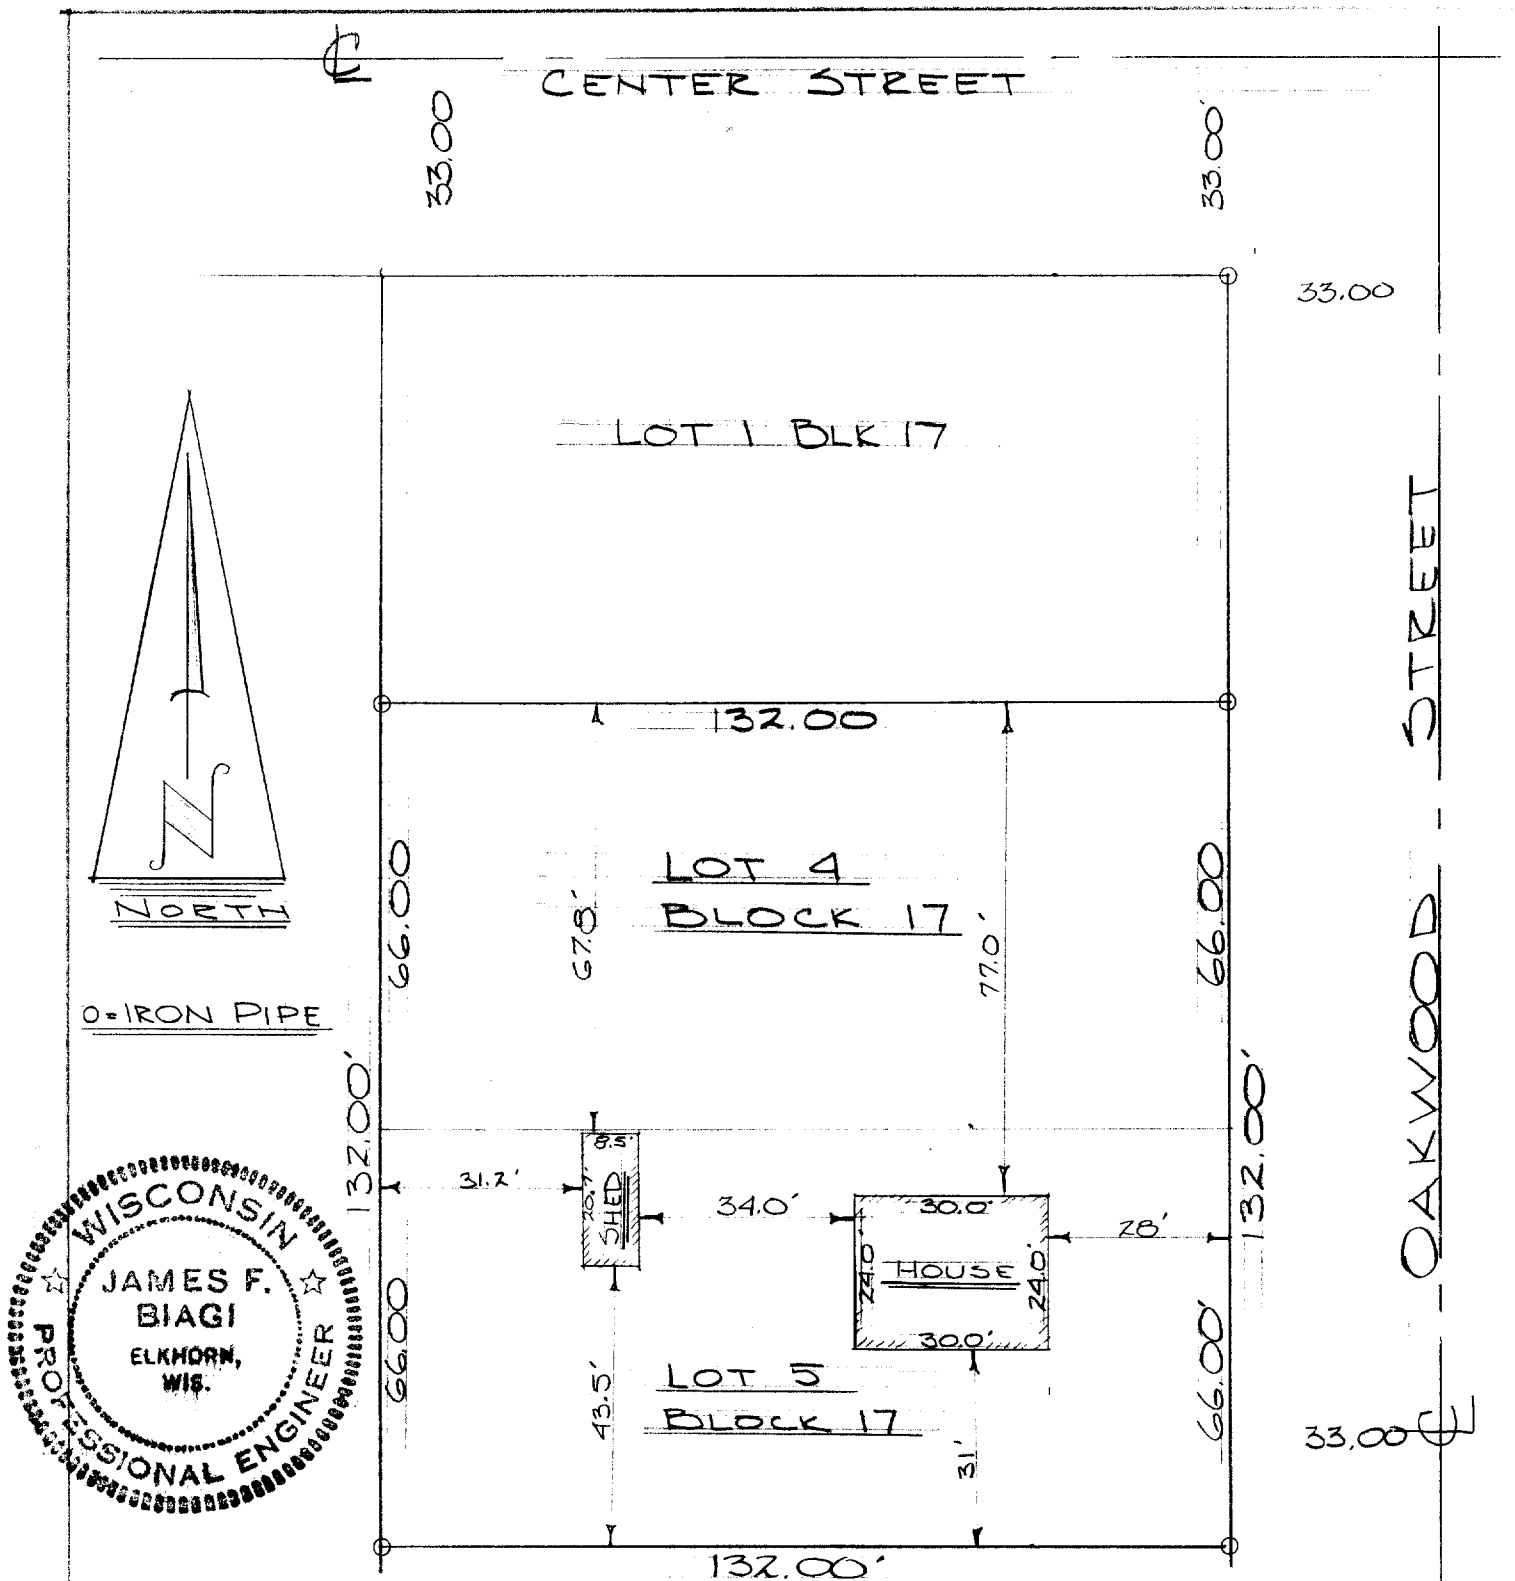

DESCRIPTION: Lots 4 and 5 of Block 17 of Williams Second Addition to the Village of Williams Bay, Walworth County, Wisconsin.

CERTIFICATE: I, James F. Biagi, surveyor, do hereby certify that I have surveyed the property hereon described and that the location of the improvements are as shown above.

James F. Biagi RLS 272