


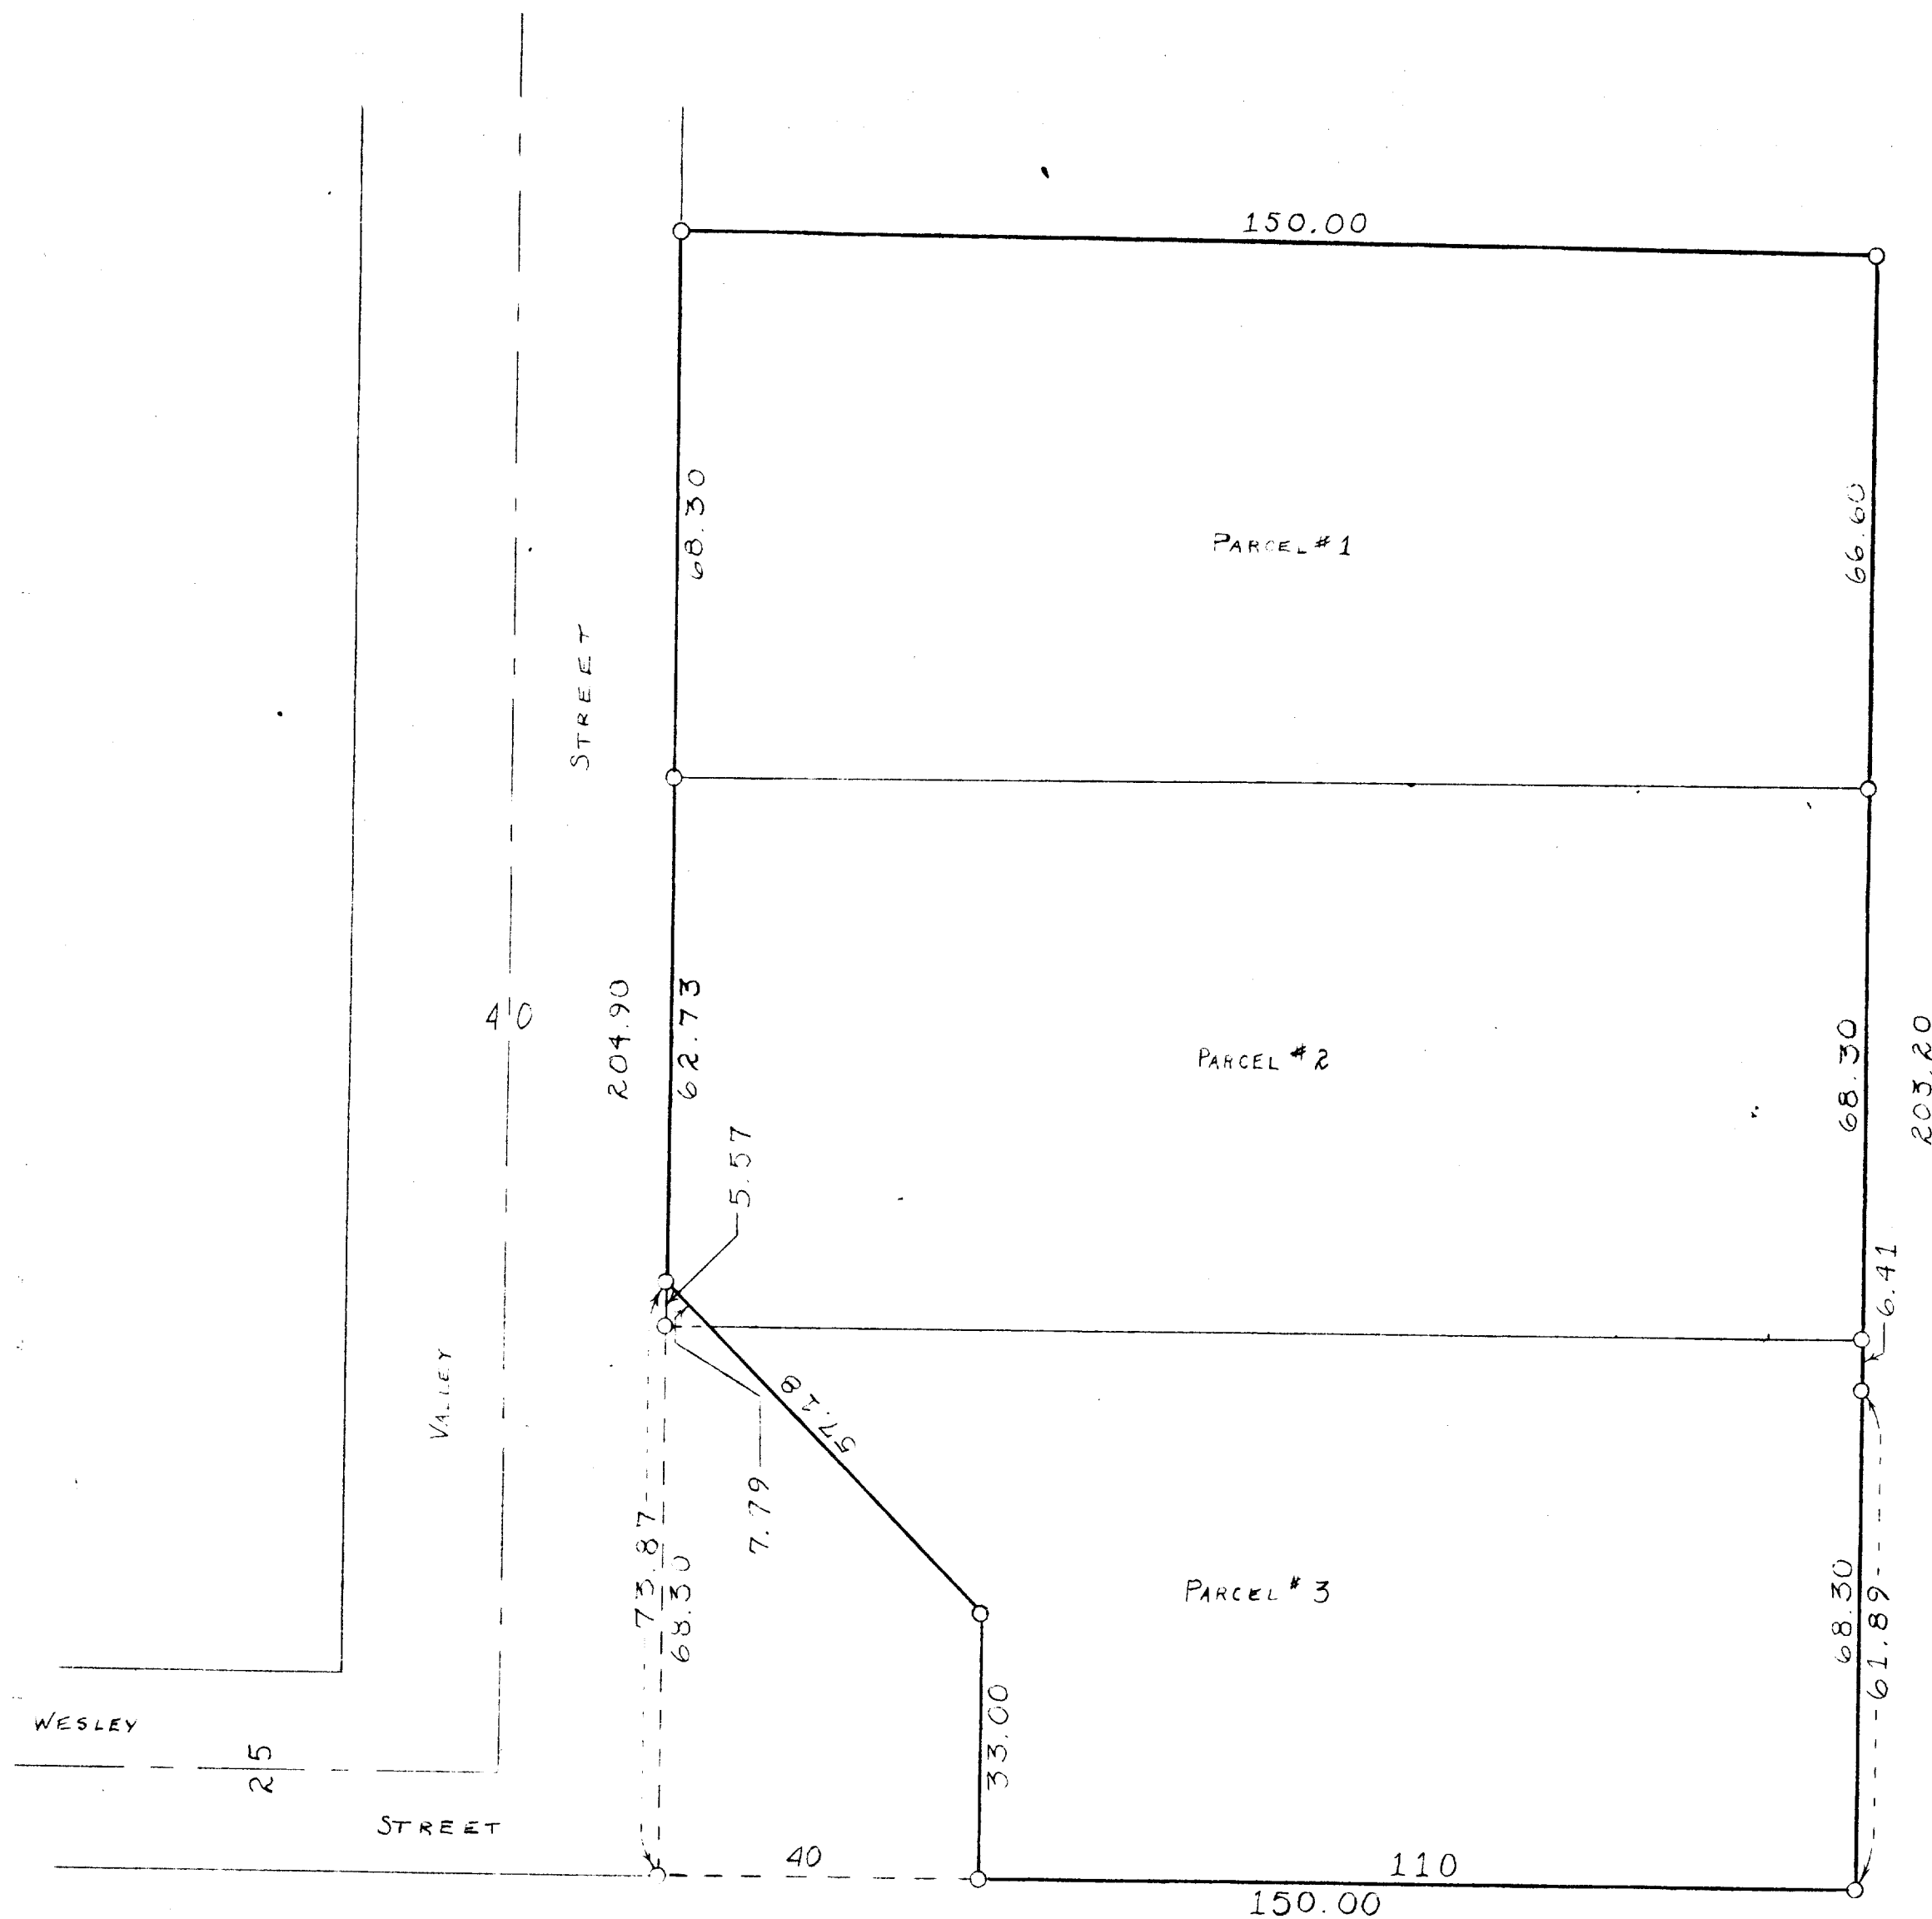

SCALE 1"=20'
O = IRON PIPE

PLAT OF SURVEY OF LOT 8 OF CARLSON'S ADDITION TO THE
VILLAGE OF WILLIAMS BAY, WALWORTH COUNTY, WISCONSIN
JULY 14, 1959

WCA-3

GEORGE T. DUNHAM, SURVEYOR
DELAWARE, WISCONSIN

11-24