



**REGISTERED PROFESSIONAL LAND SURVEYOR
LAKE GENEVA, WISCONSIN**

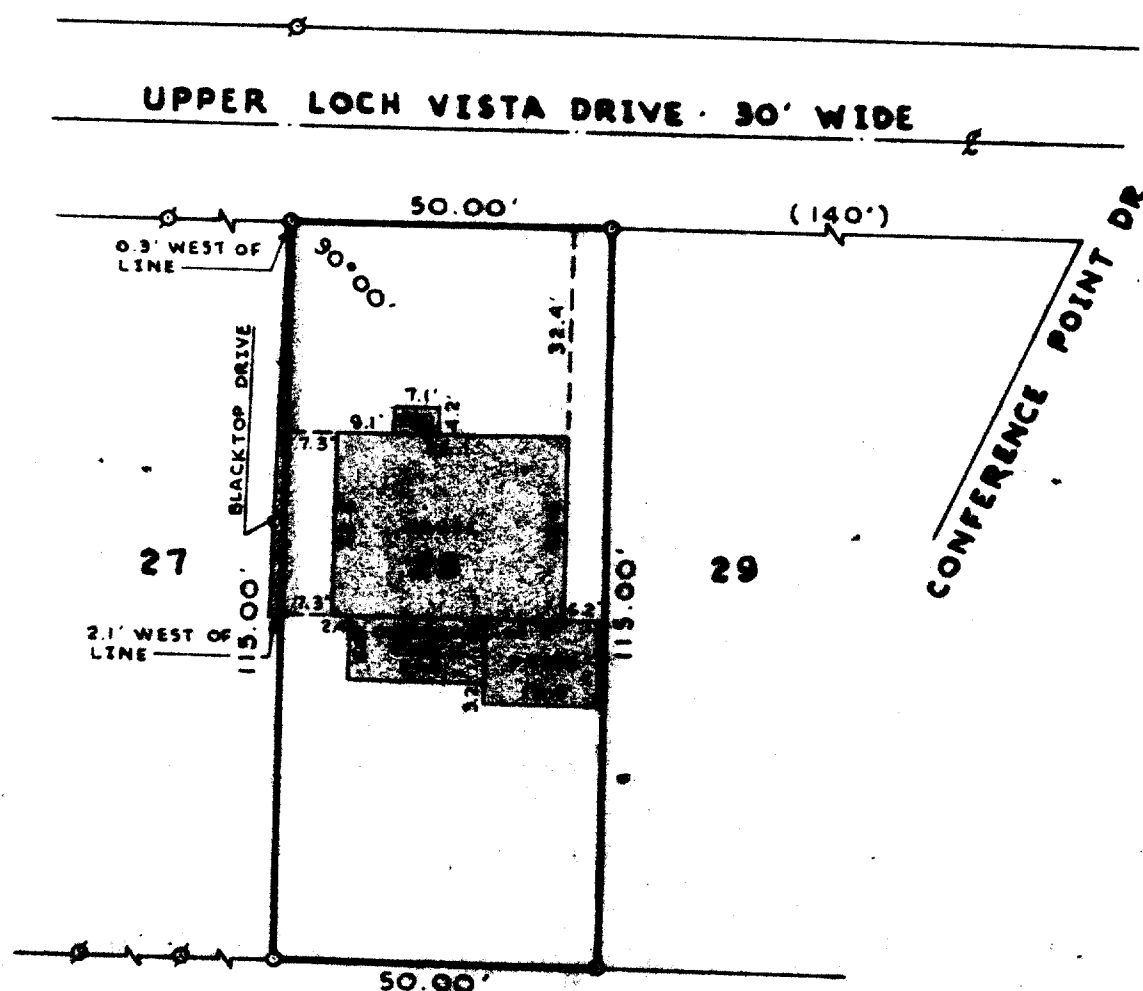

LEADS

- ◆ - IRON PIPE FOUND
- - IRON PIPE PLACED
- - CONCRETE MONUMENT
- ⊠ - SPIKE
- () - Platted As

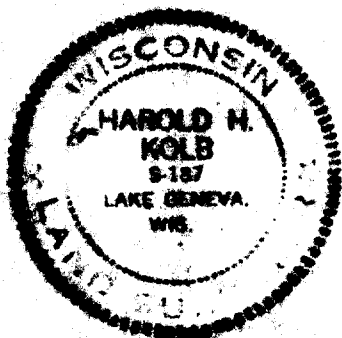

PLAT OF SURVEY OF

Lot 28, Loch Vista Club Subdivision
No. 1, Village of Williams Bay,
Walworth County, Wisconsin.

I, HAROLD N. TOLB, DO HEREBY CERTIFY THAT I HAVE SURVEYED THE PROPERTY HEREON DESCRIBED ACCORDING TO THE OFFICIAL RECORDS, AND THAT THE PLAT HEREON IS A CORRECT REPRESENTATION OF THE LOT LINES.

Harold R. Kels
 HAROLD R. KELS
 WISCONSIN REGISTERED LAND SURVEYOR, S-187
 DATE March 20, 1973