

Plat of Survey

of


Lot 107 of Baywood Heights Addition No. 2,

a subdivision located in the Northwest 1/4 of Section 1, Town 1 North,
Range 16 East, Village of Williams Bay, Walworth County, Wisconsin.



Surveyed for: **Keefe Real Estate, Inc.**
P.O. Box 460
Lake Geneva, Wisconsin. 53147

Survey Date: July 21, 2011.
Revisions:

Scale in Feet
1" = 20'
0' 10' 20' 40'

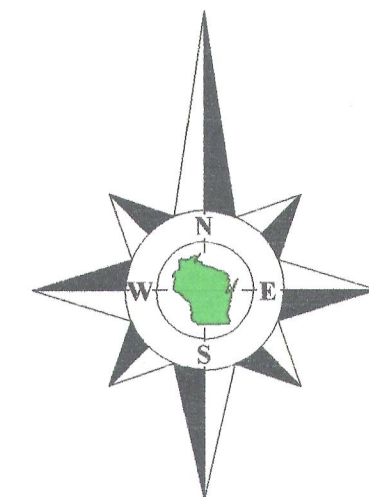

Bearings reference to the plat of
Baywood Heights Addition No. 2.

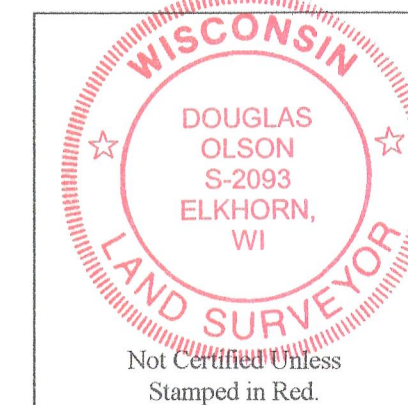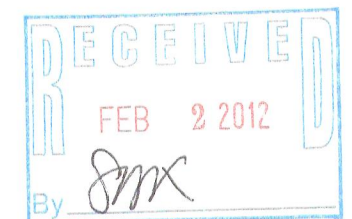

Notes:

- 1) This survey plat is not certified unless signed and sealed in red ink.
- 2) This survey is subject to Wisconsin lien laws. This Plat of Survey is the notice of intent to file lien. Lien waiver required.

Copyright 2011 by Jensen & Olson Land Surveying, LLC.

All rights reserved. No part of this survey plat may be reproduced or transmitted in any form by any means - graphic, electronic, or mechanical, including photocopying, tracing, or information storage and retrieval systems - without permission in writing from Douglas G. Olson, Jensen & Olson Land Surveying, LLC.

I hereby certify that I have surveyed the above described property and the map hereon is correct to the best of my professional knowledge and belief and shows the size and location of the property, its exterior boundaries, the location and dimensions of all visible structures thereon, boundary fences, apparent easements and roadways and visible encroachments, if any.

This survey is made for the exclusive use of the present owners of the property, and also those who purchase, mortgage or guarantee title thereto, within one year from the date hereof.

Douglas G. Olson
Wisconsin Registered Land Surveyor - 2093

Jensen & Olson Land Surveying, LLC

45 South Wisconsin Street * P.O. Box 322 * Elkhorn, Wisconsin. 53121
Telephone: (262) 723-3434 * Facsimile: (262) 723-8044
Email: jensen.olson@elknet.net

Legend
Found Iron Pipe
Found Iron Rod
Recorded Information
Utility Box or Pedestal
Water Valve
Manhole
Asphalt Surface
Concrete Surface
Pavers


Sheet 1 of 1 Sheets

Drawing Name: 11116-201107-201107Plat.sj

Job Reference Number

2011.077

2011.077

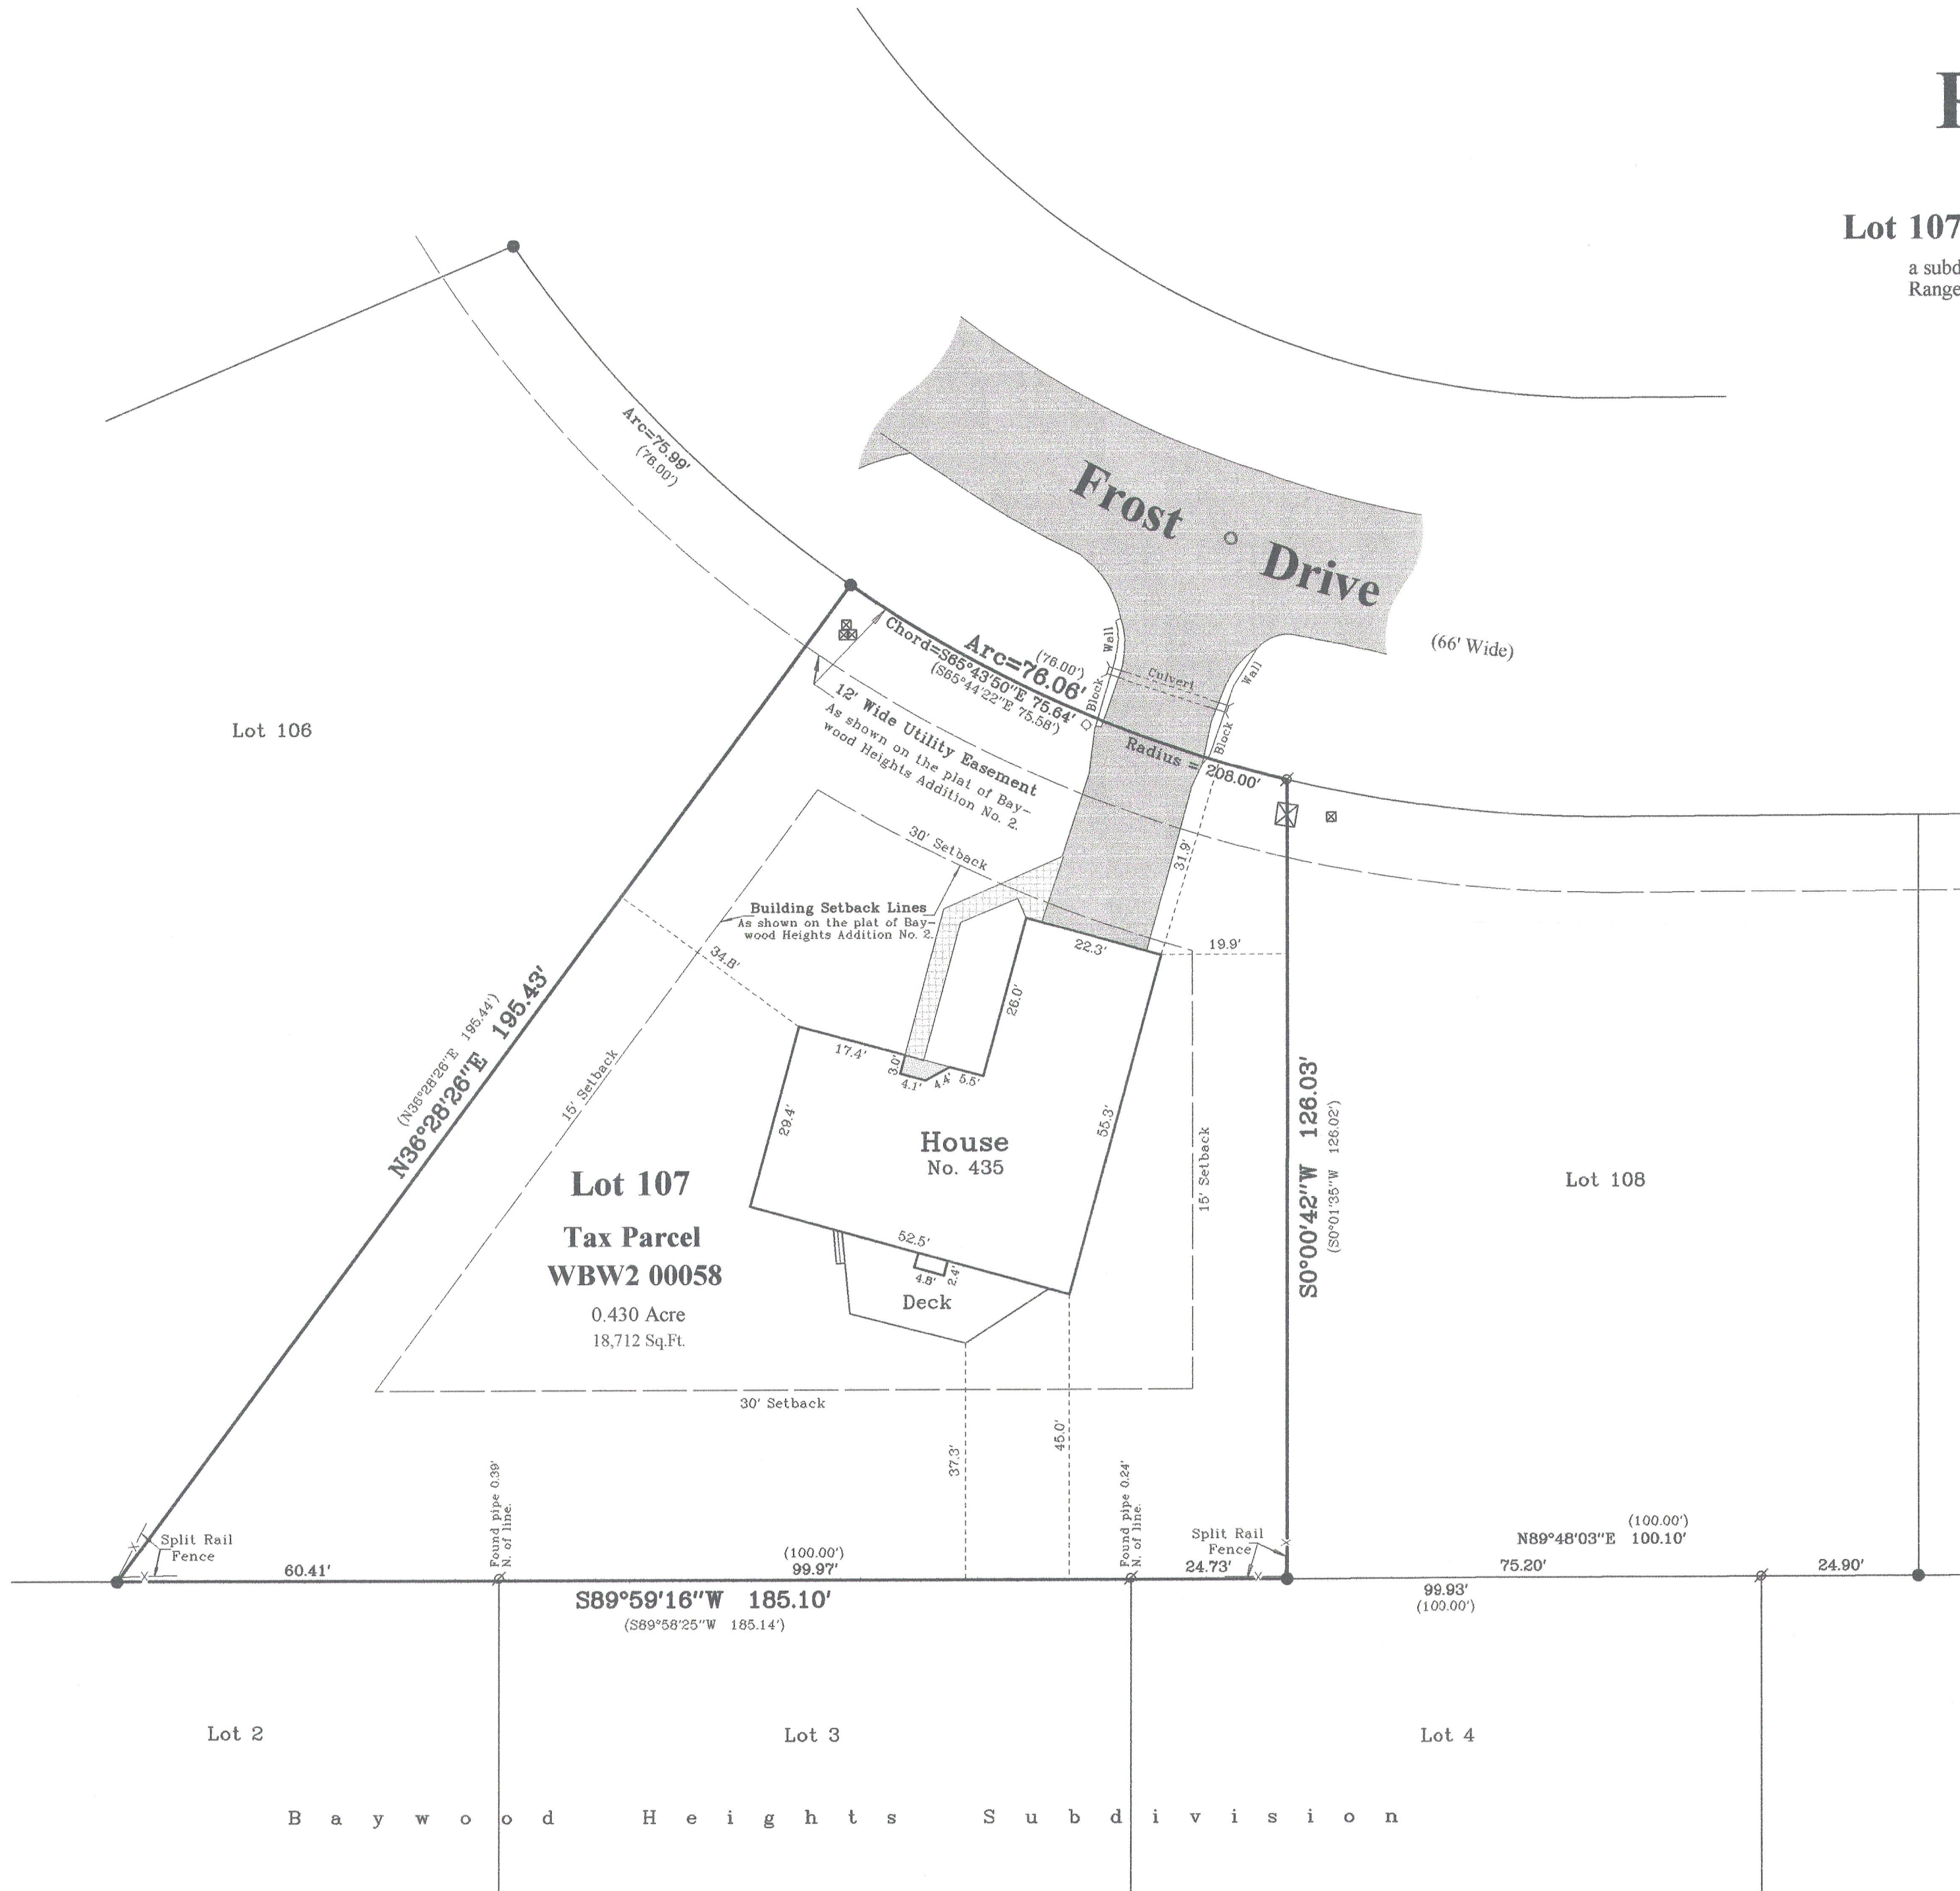

WBW 2-58

011-2401