

PREPARED FOR:
MARK LARKIN
KEEFE REAL ESTATE, INC.
751 GENEVA PARKWAY
LAKE GENEVA, WI 53147



PLAT OF SURVEY

-OF-

KROTT SURVEYING INC.

N3705 WILLOW BEND LANE
LAKE GENEVA WI. 53147
PHONE # (262)248-3697
FAX # (262)249-0639

LOT THIRTY-THREE (33) OF LACKEY BROTHERS SUBDIVISION NOW KNOWN
AS OAKWOOD ESTATES, AS RECORDED IN VOLUME 7 OF PLATS ON PAGE 112
LOCATED IN THE VILLAGE OF WILLIAMS BAY, WALWORTH COUNTY,
WISCONSIN.

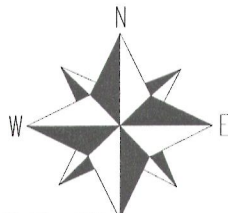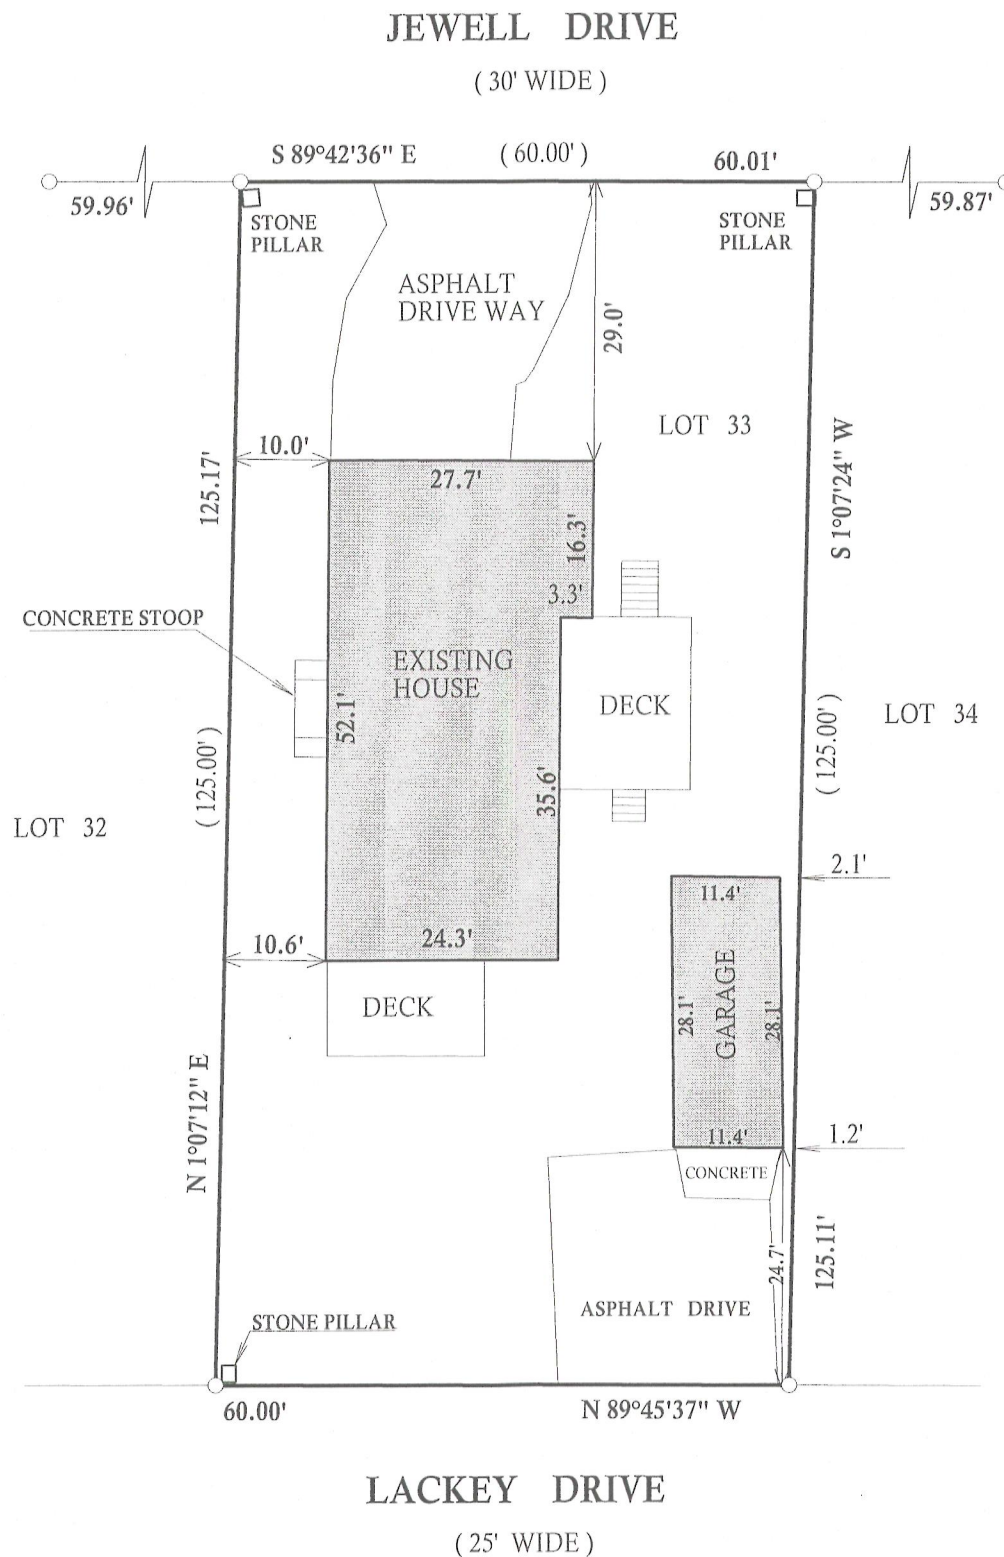

SCALE 1" = 20' S

BEARINGS REFERENCED TO PREVIOUS
SURVEY OF RECORD.

LEGEND

○ FOUND IRON PIPE

(xx) RECORDED AS

JOB #12-086

TAX ID # WLB00033

I have surveyed the above-described property and the above map is a true representation thereof and shows the size and location of the property, its exterior boundaries, the location and dimensions of all structures thereon, fences apparent easements and roadways and visible encroachments, if any.

This survey is made for the exclusive use of the present owners of the property, and also those who purchase, mortgage, or insure the title thereto within one (1) year from date hereof; and as to them I warrant the accuracy of said survey map.



DATED THIS 3rd, DAY OF JULY, 2012

John P. Krott

JOHN KROTT S - 2258
Wisconsin Registered Land Surveyor
(original if signed in red)

011-2426