

PREPARED FOR
PATRICIA DUDA
PO. BOX 813
WILLIAMS BAY WI. 53191



PLAT OF SURVEY

- OF -


LOT 166 IN CEDAR POINT PARK SECOND ADDITION IN THE
VILLAGE OF WILLIAMS BAY, WALWORTH COUNTY, WISCONSIN.

KROTT SURVEYING INC.

N3705 WILLOW BEND LANE
LAKE GENEVA WI. 53147
PHONE # (262)248-3697
FAX # (262)249-0639

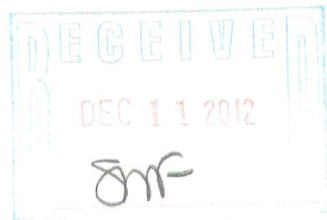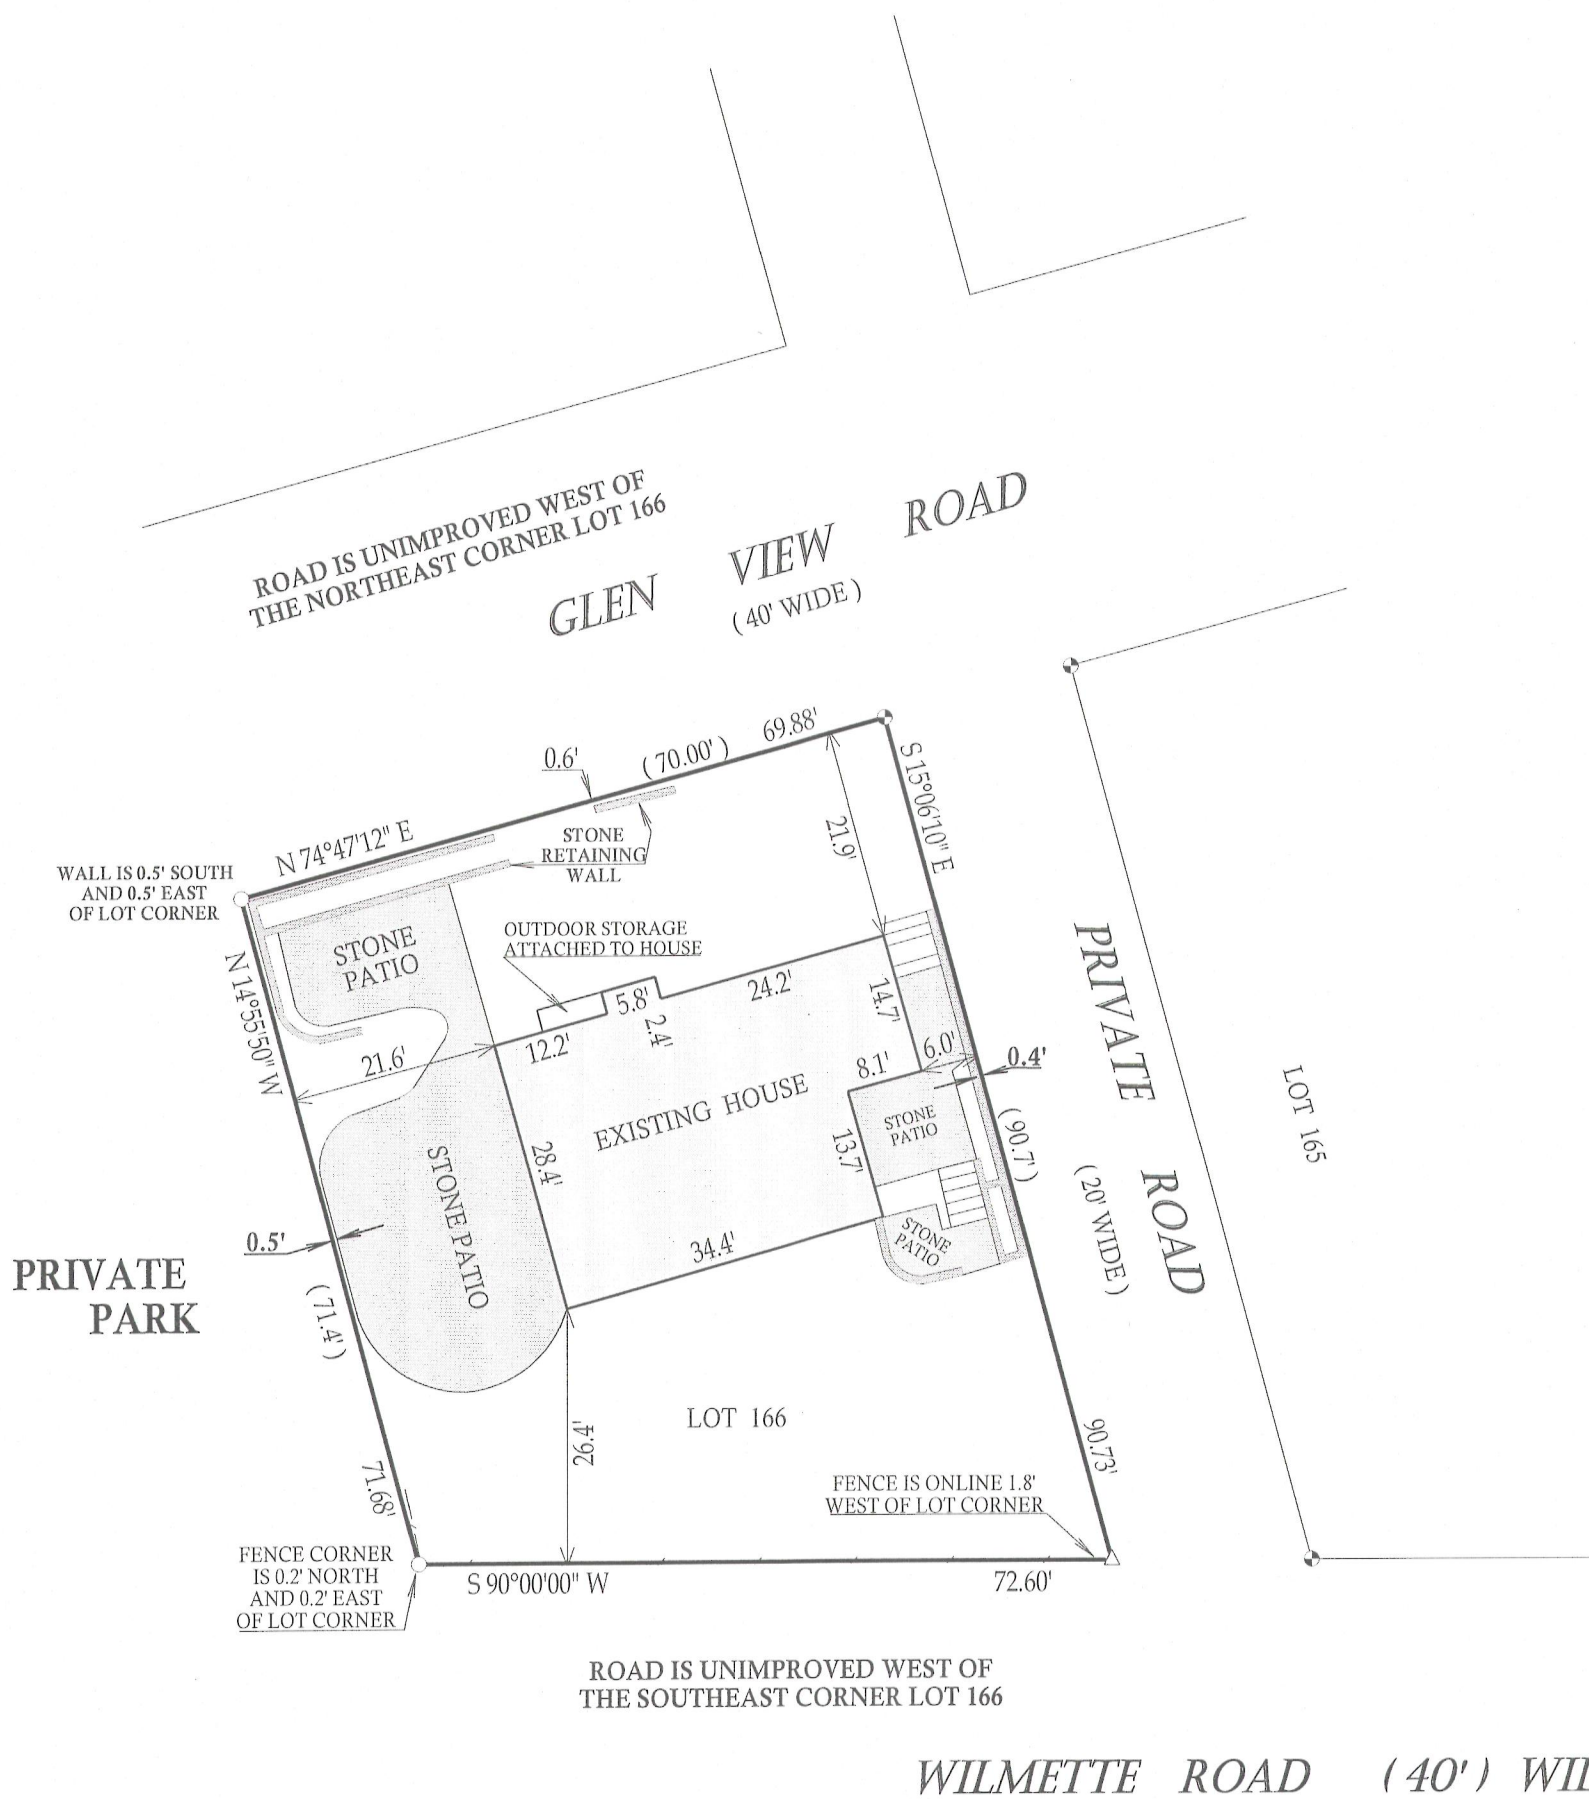

LOT 191

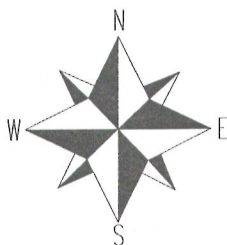


SCALE 1" = 20'



NOTE: BEARINGS ARE REFERENCED TO PREVIOUS SURVEY RECORDS

I have surveyed the above-described property and the above map is a true representation thereof and shows the size and location of the property, its exterior boundaries, the location and dimensions of all structures thereon, fences apparent easements and roadways and visible encroachments, if any.

This survey is made for the exclusive use of the present owners of the property, and also those who purchase, mortgage, or insure the title thereto within one (1) year from date hereof; and as to them I warrant the accuracy of said survey map.

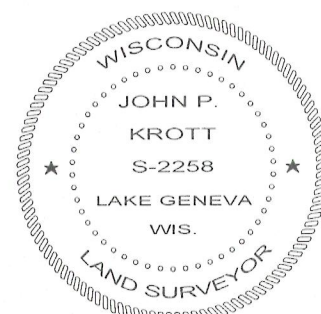

DATED THIS 13th DAY OF SEPTEMBER 2012

John P. Krott
JOHN KROTT S - 2258
Wisconsin Registered Land Surveyor
(original if signed in red)

LEGEND

- FOUND IRON PIPE
- △ FOUND P.K. NAIL
- FOUND CONCRETE MONUMENT

(XX) RECORDED AS

TAX ID # WCP200058

JOB # 07-380UD

011-2451