



PREPARED FOR:
LINDA TONGE
KEEFE REAL ESTATE, INC.
751 GENEVA PARKWAY
LAKE GENEVA, WI 53147

PLAT OF SURVEY


-OF-

LOT FIFTY-SEVEN (57) AND THE SOUTH THIRTY (30') FEET
OF LOT FIFTY-SIX (56) OF THE ORIGINAL SUBDIVISION OF
CEDAR POINT PARK ACCORDING TO A PLAT THEREOF ON
RECORD IN THE OFFICE OF THE REGISTER OF DEEDS IN AND
FOR WALWORTH COUNTY.

KROTT SURVEYING INC.
N3705 WILLOW BEND LANE
LAKE GENEVA WI. 53147
PHONE # (262)248-3697
FAX # (262)249-0639

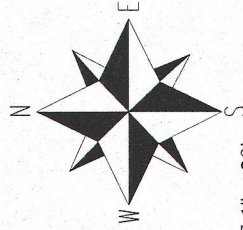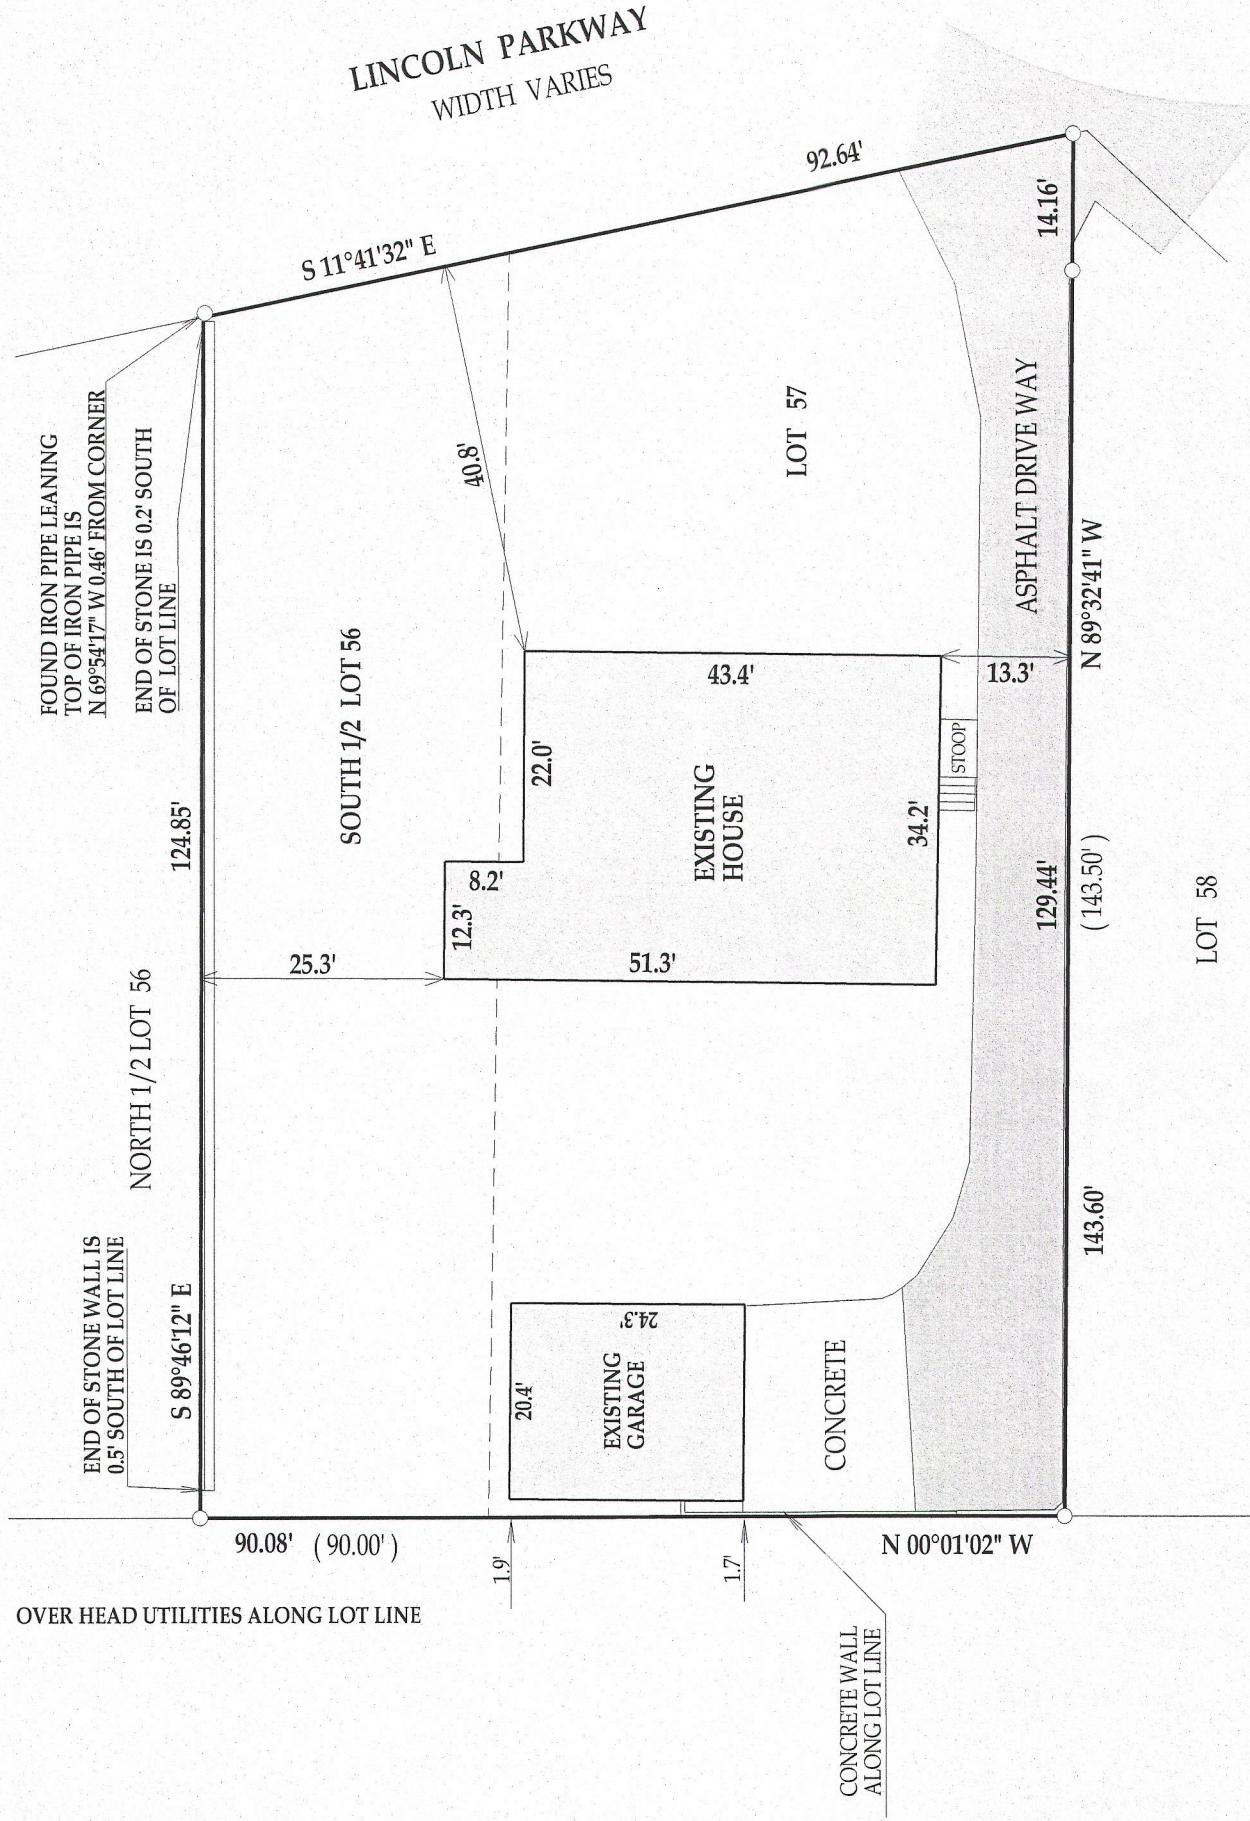

SCALE 1" = 20'

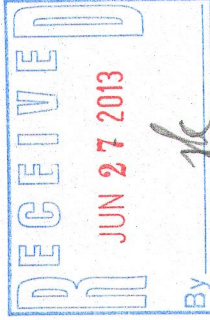

LEGEND

- FOUND IRON PIPE
- FOUND IRON BAR
- SET IRON BAR


(xx) RECORDED AS

JOB #13-082

TAX ID WCP00042

I have surveyed the above-described property and the above map is a true representation thereof and shows the size and location of the property, its exterior boundaries, the location and dimensions of all structures thereon, fences apparent easements and roadways and visible encroachments, if any.

This survey is made for the exclusive use of the present owners of the property, and also those who purchase, mortgage, or insure the title thereto within one (1) year from date hereof; and as to them I warrant the accuracy of said survey map.

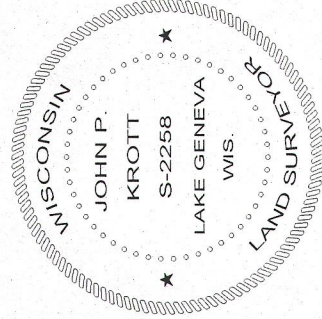

DATED THIS 13th, DAY OF JUNE, 2013

John P. Krott
JOHN KROTT S - 2258
Wisconsin Registered Land Surveyor
(original if signed in red)

011-2466