


FLIEN SIAVELIS
C/O NICHOLAS A. EGERT
McCORMACK & EGERT, S.C.
GENEVA PARKWAY NORTH
LAKE GENEVA WI 53147

N3705 WILLOW BEND LANE
LAKE GENEVA WI. 53147
PHONE # (262)248-3697
FAX # (262)249-0639

LOT 21, LACKEY BROTHERS SUBDIVISION LOCATED IN THE VILLAGE OF WILLIAMS BAY, WALWORTH COUNTY, WISCONSIN.

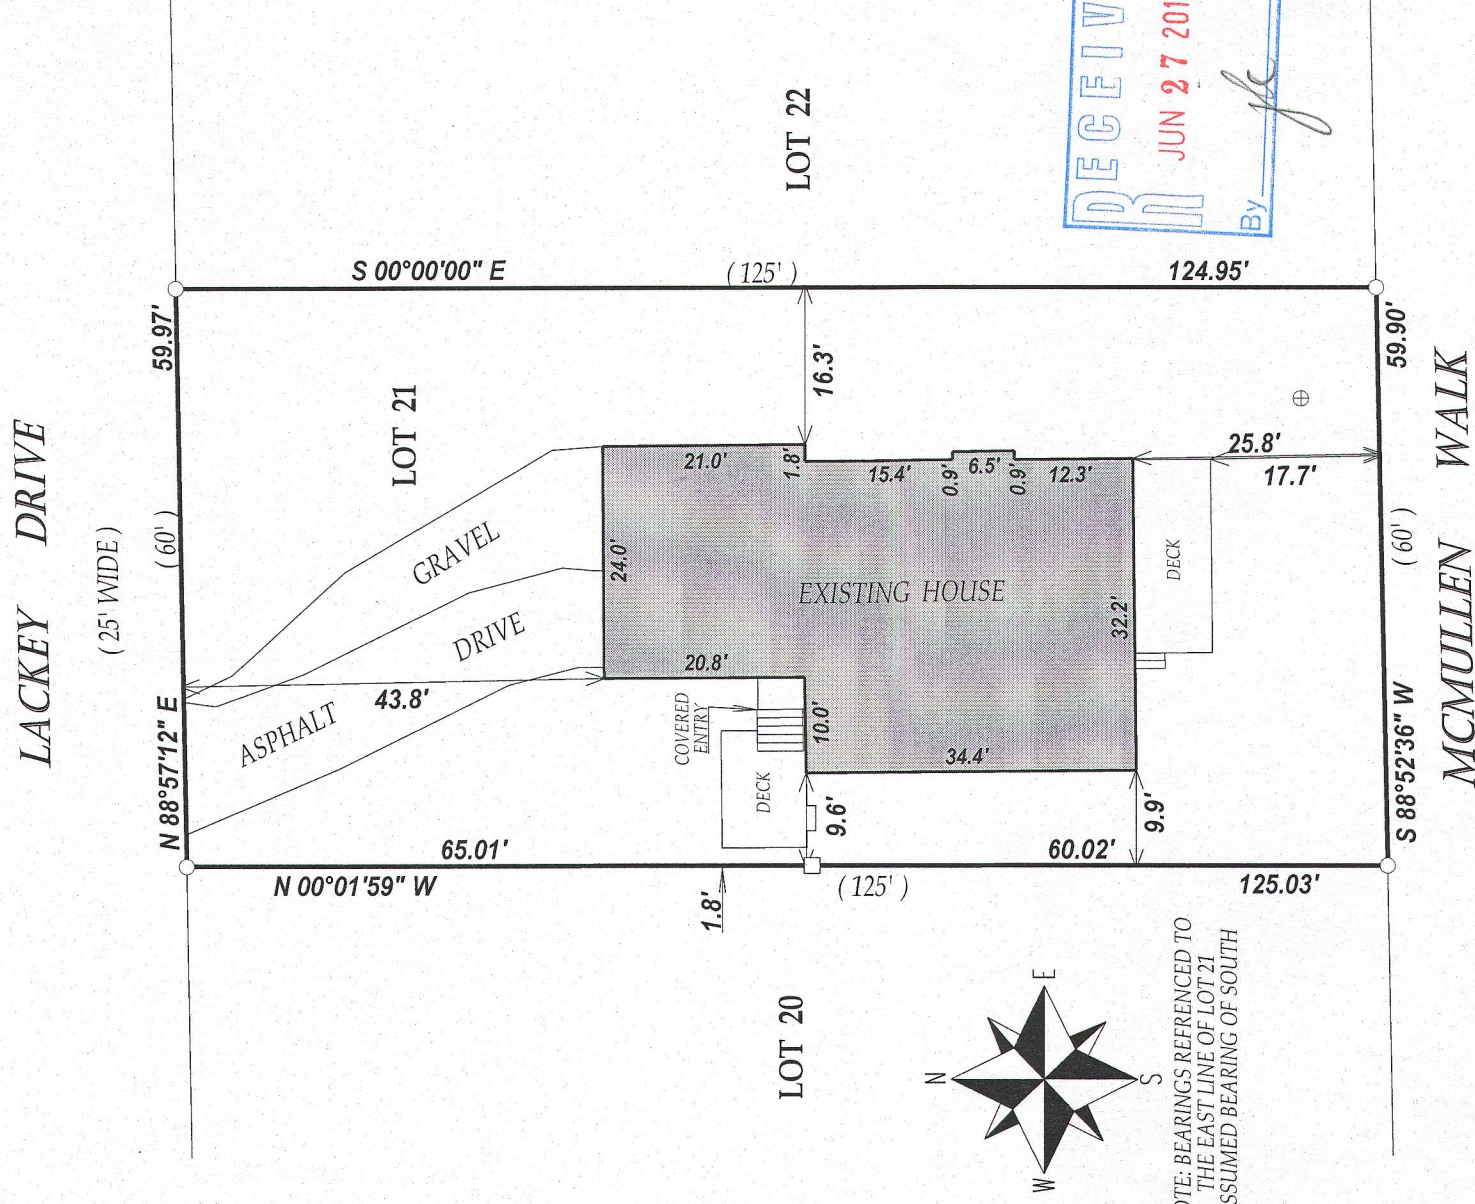

NOTE: BEARINGS REFERENCED TO
THE EAST LINE OF LOT 21
ASSUMED BEARING OF SOUTH



LEGEND

- FOUND IRON PIPE
□ FOUND IRON BAR
⊕ STEEL LID

(XX) RECORDED AS

TAX ID # WL B00021

JOB # 13-043

I have surveyed the above-described property and the above map is a true representation thereof and shows the size and location of the property, its exterior boundaries, the location and dimensions of all structures thereon, fences apparent easements and roadways and visible encroachments, if any.

DATED THIS 12th DAY OF APRIL 2013

This survey is made for the exclusive use of the present owners of the property, and also those who purchase, mortgage, or insure the title thereto within one (1) year from date hereof, and as to them I warrant the accuracy of said survey map.

JOHN KROTT S - 2258
Wisconsin Registered Land Surveyor
(original if signed in red)

011-2407