

PREPARED FOR:



JULIE BUSH
COLDWELL BANKER HONIG-BELL
226 BROAD ST.
LAKE GENEVA, WI 53147

PLAT OF SURVEY

-OF-

KROTT SURVEYING INC.
N3705 WILLOW BEND LANE
LAKE GENEVA WI 53147
PHONE # (262)248-3697
FAX # (262)249-0639

LOT NUMBER ONE HUNDRED SEVENTEEN (117) OF CEDAR POINT
PARK ORIGINAL SUBDIVISION IN THE VILLAGE OF WILLIAMS BAY
ACCORDING TO THE PLAT THEREOF ON RECORD IN THE WALWORTH
COUNTY REGISTER OF DEEDS OFFICE, STATE OF WISCONSIN.

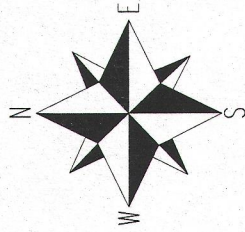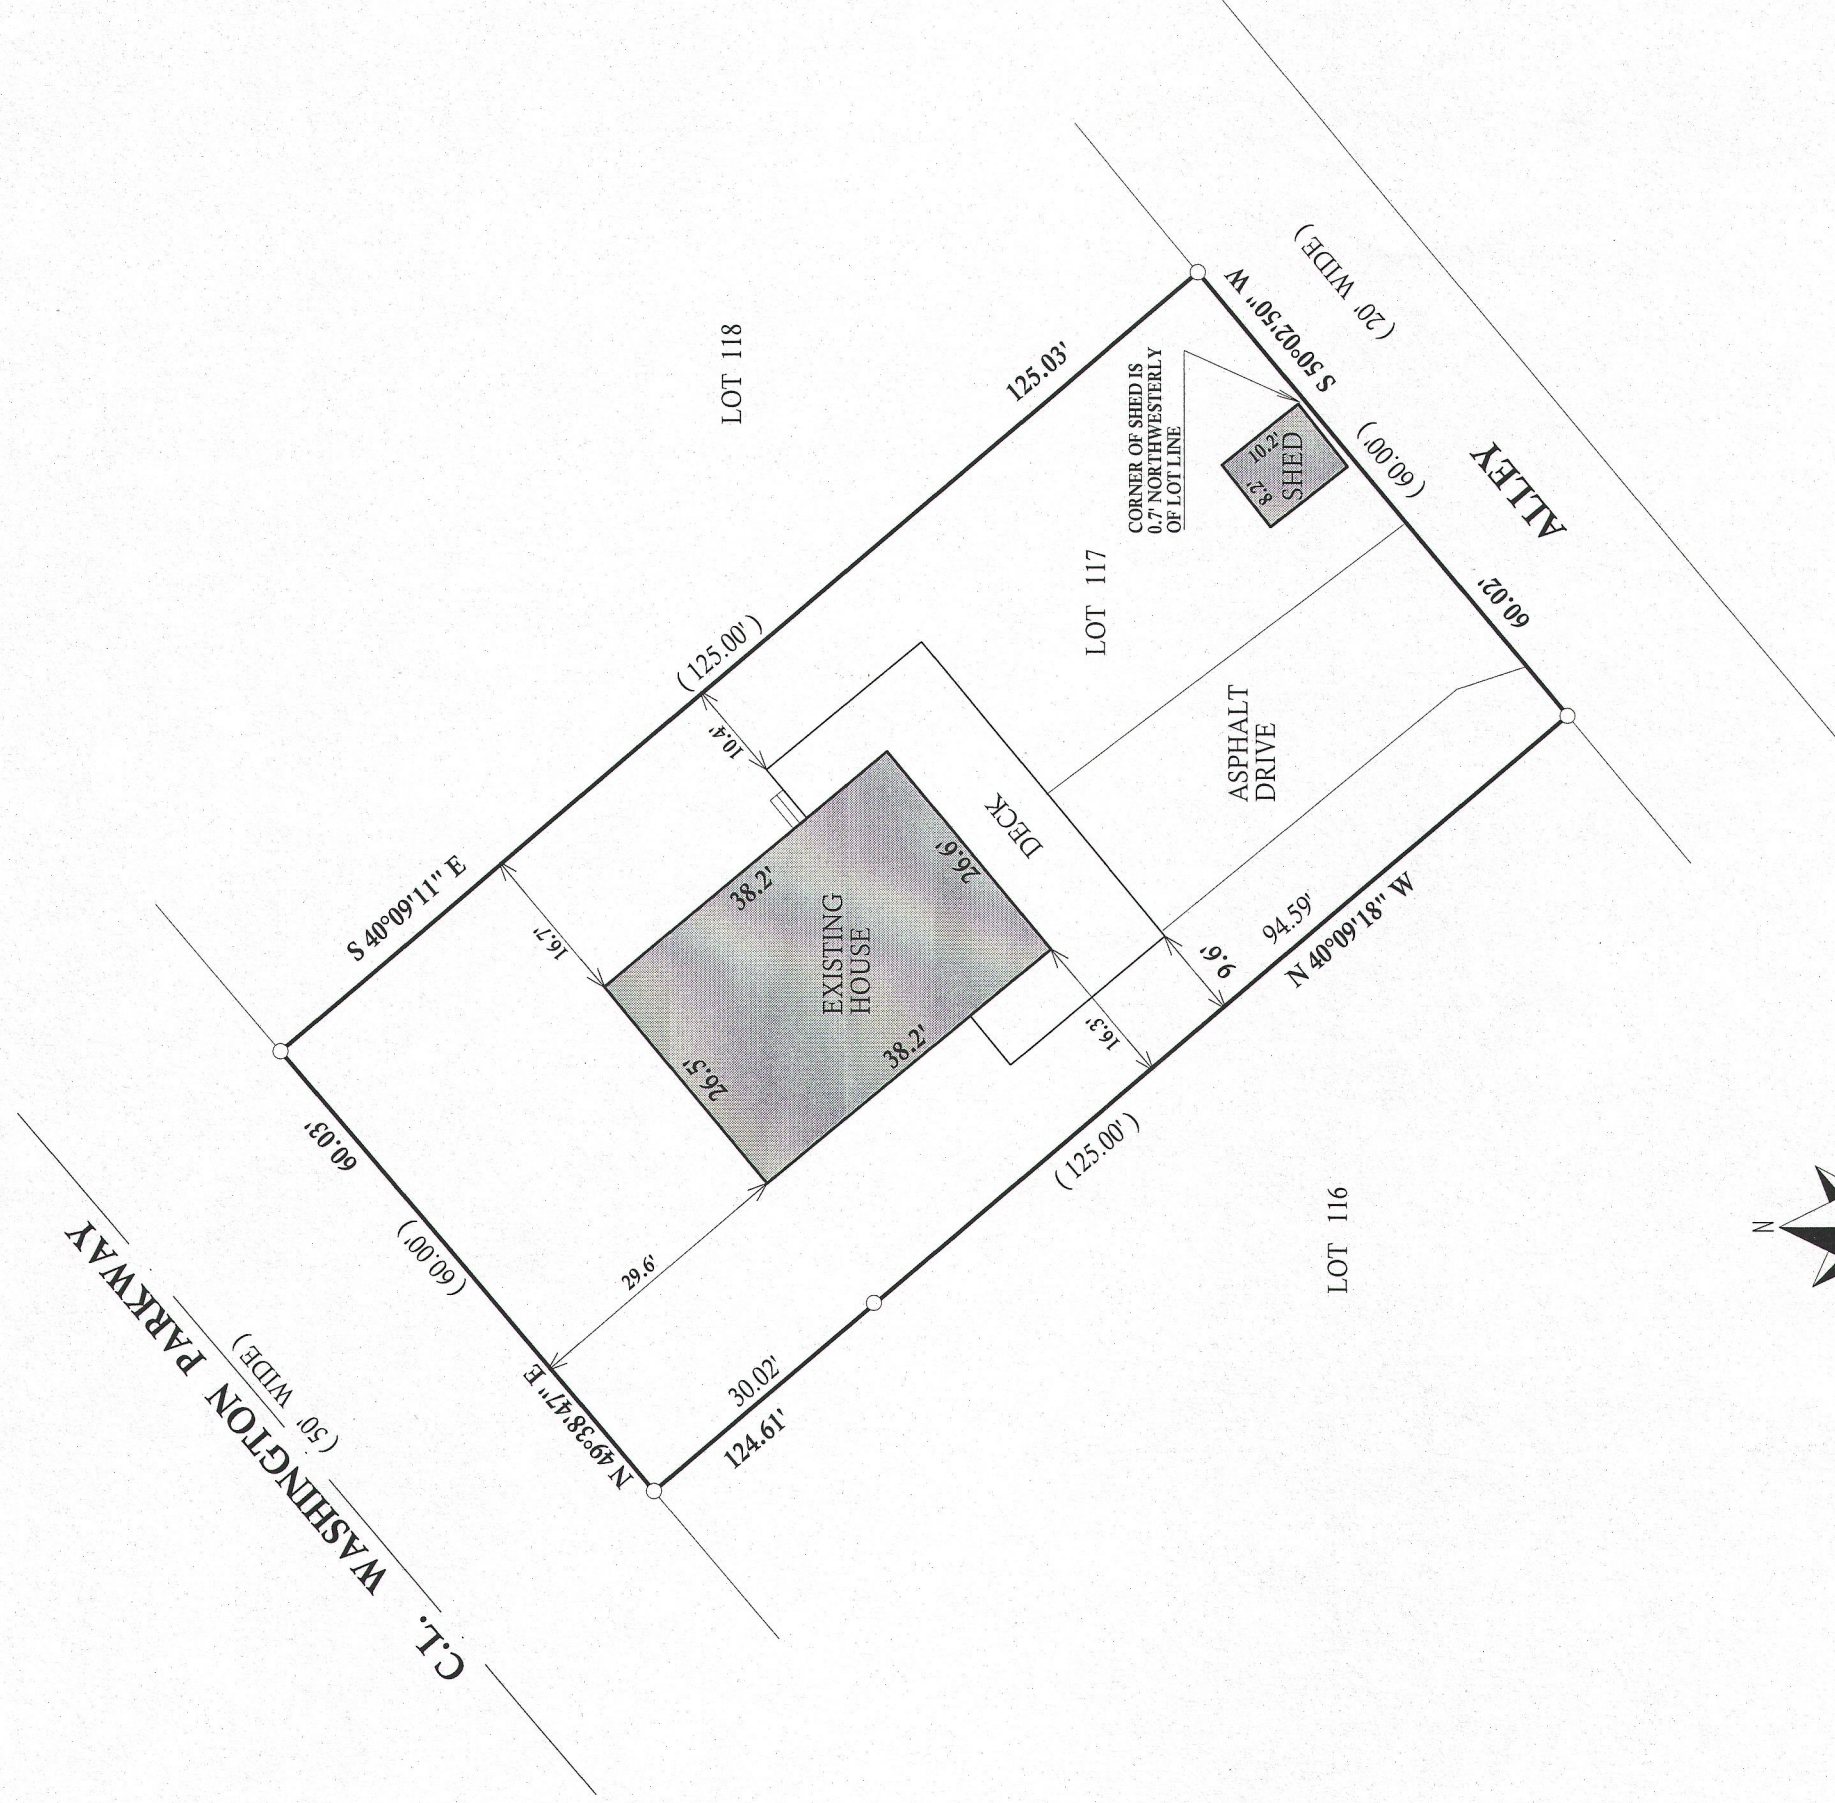

SCALE 1" = 20'

LEGEND

- FOUND IRON PIPE
- (xx) RECORDED AS



I have surveyed the above-described property and the above map is a true representation thereof and shows the size and location of the property, its exterior boundaries, the location and dimensions of all structures thereon, fences apparent easements and roadways and visible encroachments, if any.

This survey is made for the exclusive use of the present owners of the property, and also those who purchase, mortgage, or insure the title thereto within one (1) year from date hereof; and as to them I warrant the accuracy of said survey map.

JOB # 13-051

TAX ID #WCP00090A

DATED THIS 22nd, DAY OF APRIL, 2013

John P. Krott

JOHN KROTT S - 2258
Wisconsin Registered Land Surveyor
(original if signed in red)

011-2468