



DOROTHY HIGGINS GERBER
SHOREWEST REALTORS
623 MAIN ST.
LAKE GENEVA, WI 53147

PLAT OF SURVEY

-OF-

KROTT SURVEYING INC.
N3705 WILLOW BEND LANE
LAKE GENEVA WI. 53147
PHONE # (262)248-3697
FAX # (262)249-0639

LOT 131 AND THE EAST 1/2 OF LOT 132 OF THE SECOND
ADDITION TO CEDAR POINT PARK, BEING A SUBDIVISION
LOCATED IN THE VILLAGE OF WILLIAMS BAY, WALWORTH
COUNTY, WISCONSIN, ACCORDING TO A PLAT THEREOF OF
RECORD.

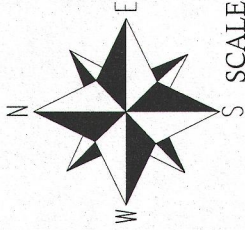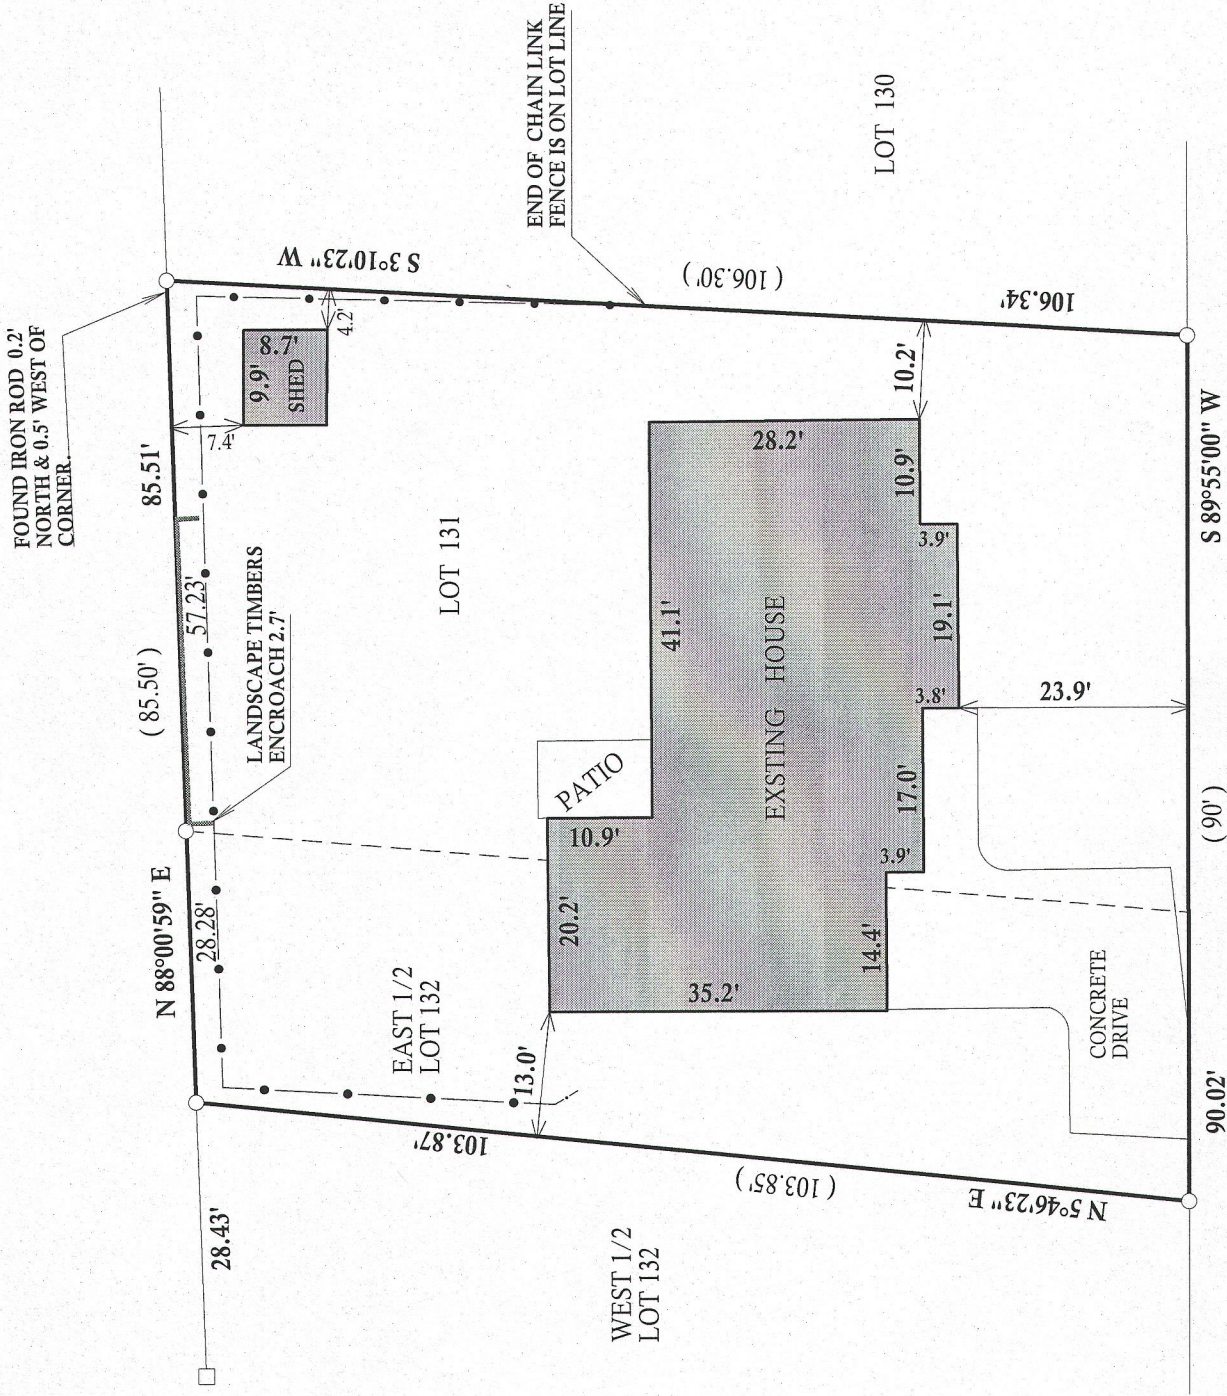

SCALE 1" = 20'

LEGEND

- FOUND IRON PIPE
- (xx) RECORDED AS
- FENCE

I have surveyed the above-described property and the above map is a true representation thereof and shows the size and location of the property, its exterior boundaries, the location and dimensions of all structures thereon, fences apparent easements and roadways and visible encroachments, if any.


This survey is made for the exclusive use of the present owners of the property, and also those who purchase, mortgage, or insure the title thereto within one (1) year from date hereof; and as to them I warrant the accuracy of said survey map.

JOB # 13-057

TAX ID # WCP200029&31

JOHN KROTT S - 2258
Wisconsin Registered Land Surveyor
(original if signed in red)

DATED THIS 27th, DAY OF APRIL, 2013

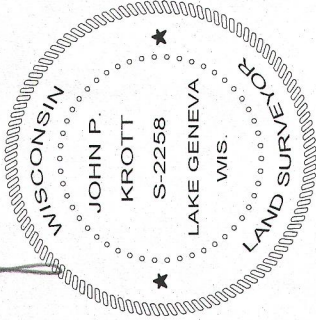

011-2469