


LOT 184 OF THE SECOND ADDITION TO CEDAR POINT PARK
SAID LAND BEING IN THE VILLAGE OF WILLIAMS BAY,
WALWORTH COUNTY, WISCONSIN.

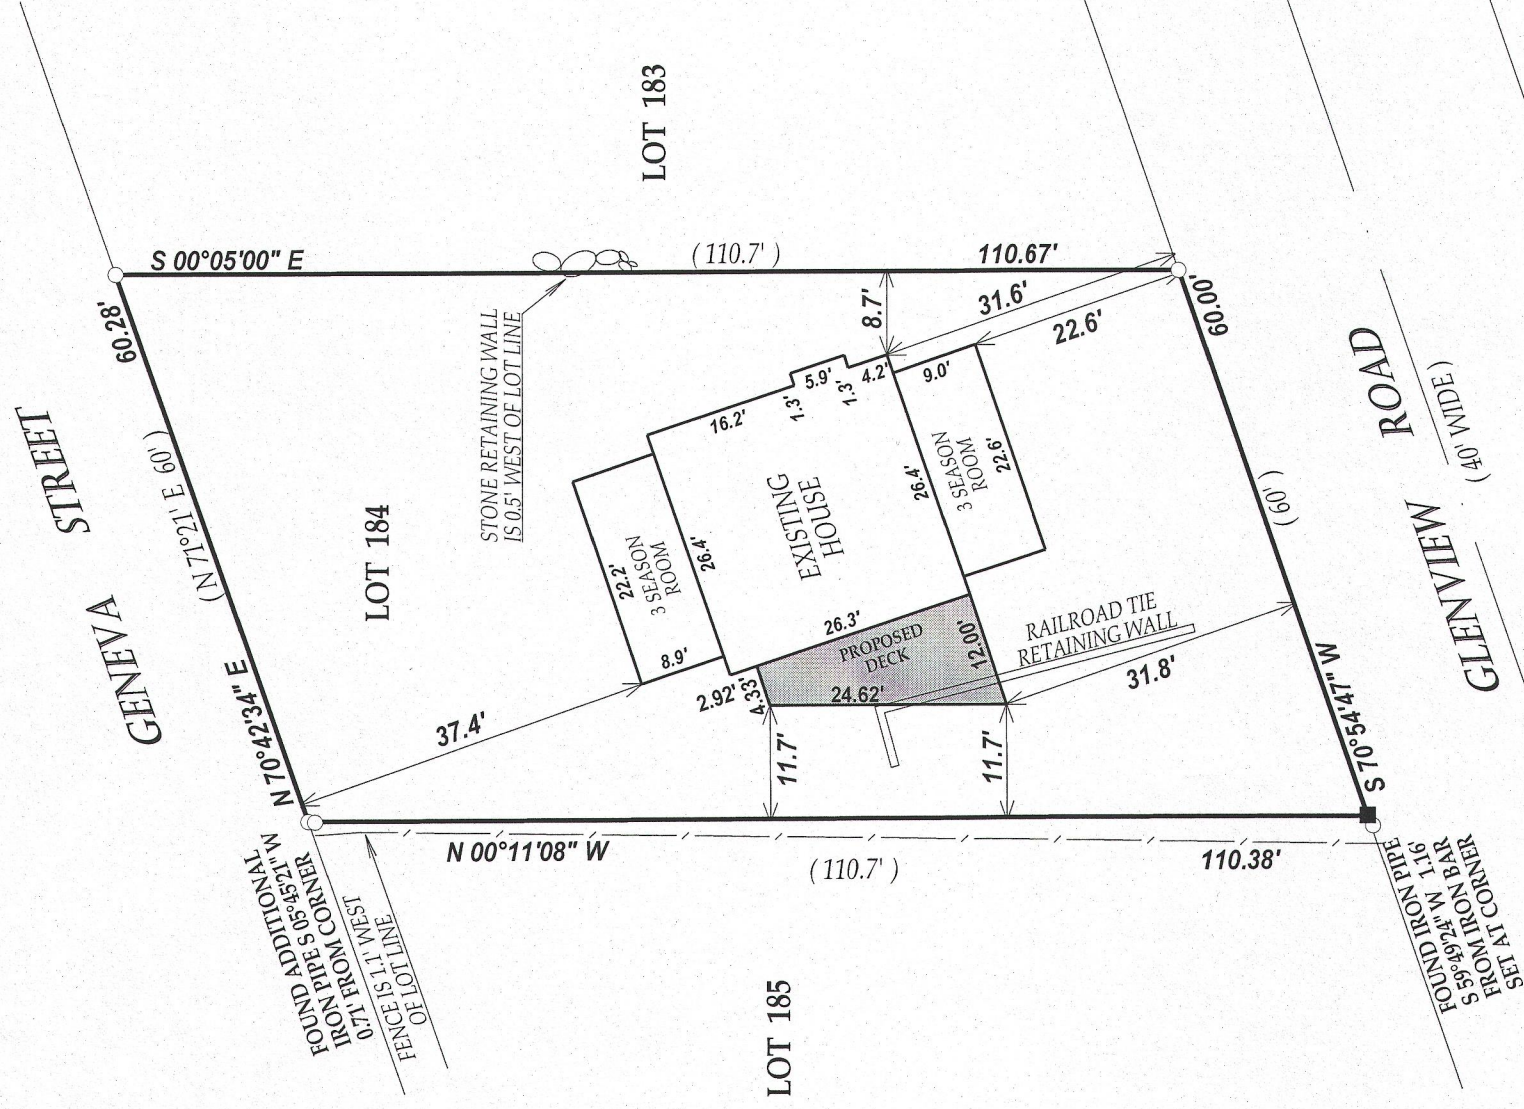


LEGEND

- FOUND IRON PIPE
■ SET IRON BAR

(XX) RECORDED AS

TAX ID # WCP200075

JOB # 13-045

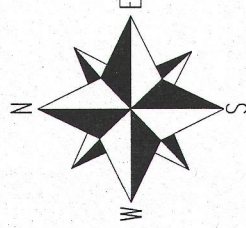


SCALE 1" = 20'



NOTE: BEARINGS ARE REFERENCED TO THE RECORD PLAT

I have surveyed the above-described property and the above map is a true representation thereof and shows the size and location of the property, its exterior boundaries, the location and dimensions of all structures thereon, fences apparent easements and roadways and visible encroachments, if any.

This survey is made for the exclusive use of the present owners of the property, and also those who purchase, mortgage, or insure the title thereto within one (1) year from date hereof; and as to them I warrant the accuracy of said survey map.

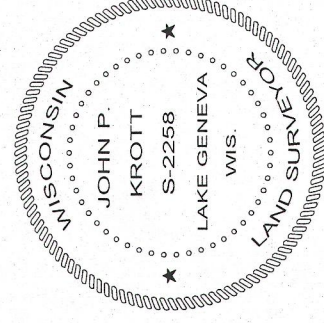

DATED THIS 15th DAY OF APRIL 2013

JOHN KROTT S - 2258
Wisconsin Registered Land Surveyor
(original if signed in red)

011-2472