

KROTT SURVEYING INC.

N3705 WILLOW BEND LANE

LAKE GENEVA WL. 53147

PHONE # (262) 248-3697


FAX # (262) 249-0639

-OF-
LOT 1 IN SUMMER HAVEN SUBDIVISION, LOCATED IN THE VILLAGE
OF WILLIAMS BAY, WALWORTH COUNTY, WISCONSIN.

CONFERENCE POINT ROAD


WOOD RETAINING WALL

(30' WIDE PLATTED AS SNAKE DRIVE)

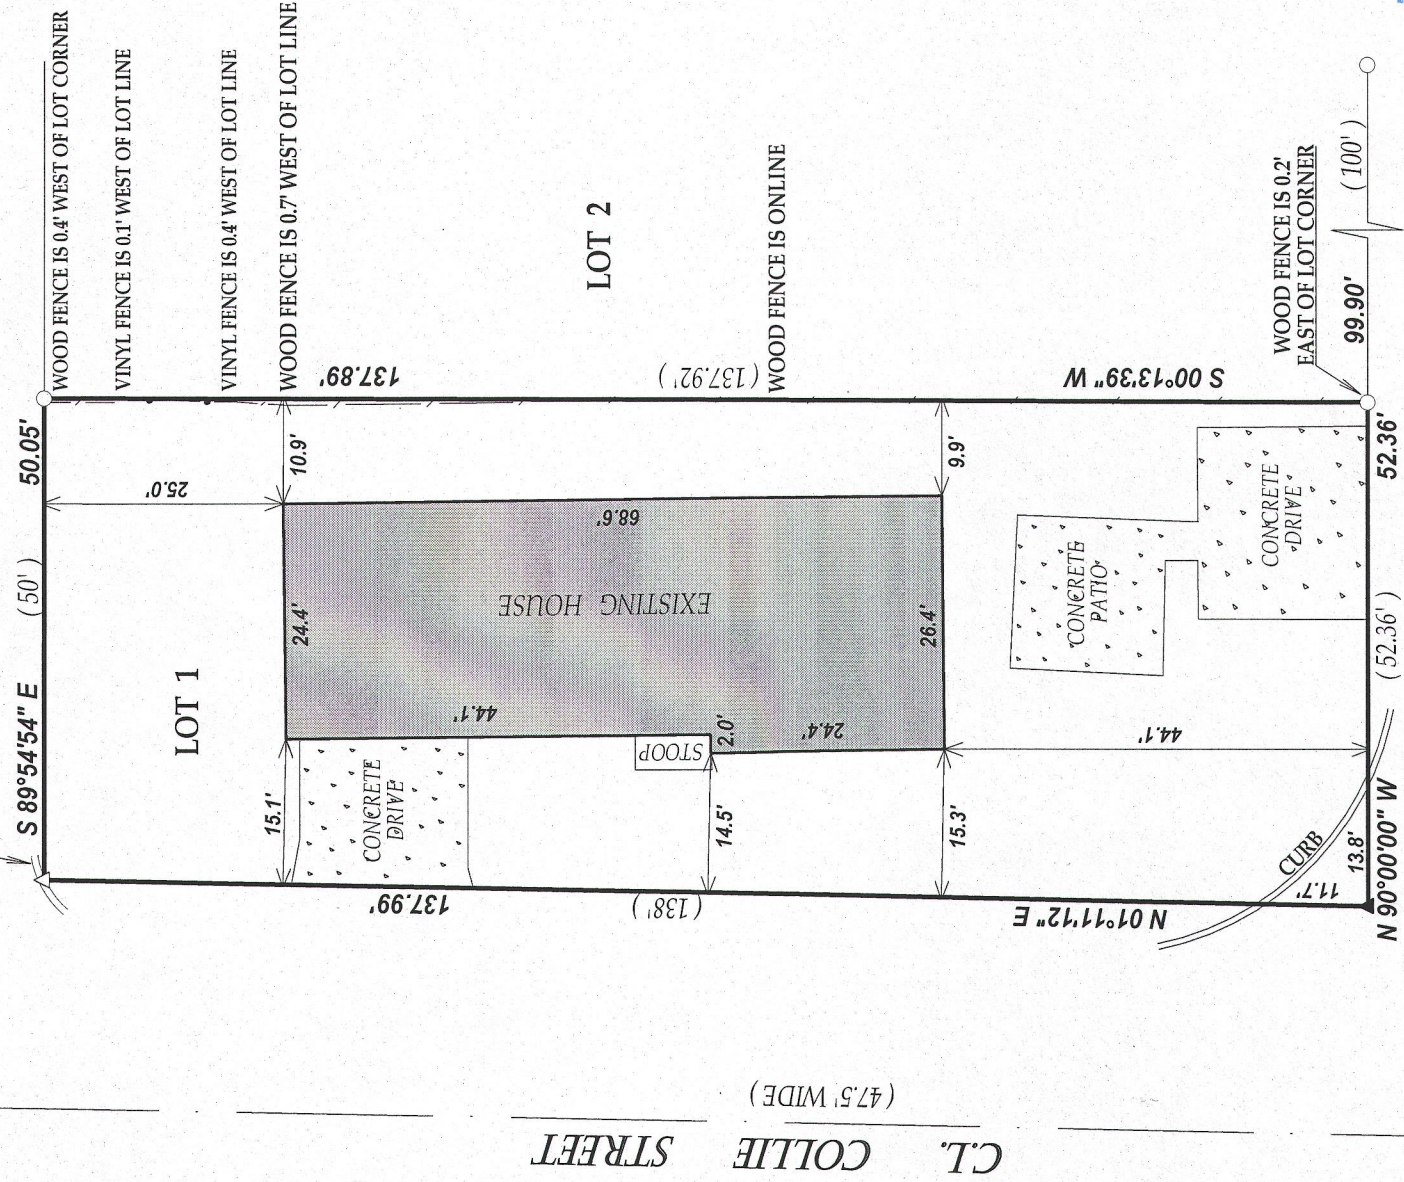

LIECHTY DRIVE

(30' WIDE)

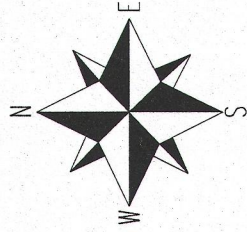

LEGEND

- FOUND IRON PIPE
- △ FOUND P.K. NAIL
- ▲ SET MAG NAIL

(XX) RECORDED AS

TAX ID # WSL00001

JOB # 13-040

SCALE 1" = 20'



NOTE: BEARINGS ARE REFERENCED TO THE RECORD PLAT

I have surveyed the above-described property and the above map is a true representation thereof and shows the size and location of the property, its exterior boundaries, the location and dimensions of all structures thereon, fences apparent easements and roadways and visible encroachments, if any.

This survey is made for the exclusive use of the present owners of the property, and also those who purchase, mortgage, or insure the title thereto within one (1) year from date hereof; and as to them I warrant the accuracy of said survey map.

DATED THIS 5th DAY OF APRIL 2013

[Handwritten signature]

JOHN KROTT S - 2258

(original if signed in red)

011-2473