


PREPARED FOR
JACKSON SANDERSON
KOENIG & STREY REAL LIVING
AND
CHRISTOPHER & MARGARET KIRBY

PLAT OF SURVEY

PATHFINDER SURVEYING INC.
(formerly)
J.K. SURVEYING INC.
P.O BOX 322
LAKE GENEVA, WI. 53147
WWW.PATHFINDERSURVEYING.NET
262-248-8303

- OF -

LOTS 23 AND 24, IN BLOCK 1 OF STARK'S SUBDIVISION, ACCORDING TO THE RECORD PLAT THEREOF, SAID LAND BEING IN THE VILLAGE OF WILLIAMS BAY, COUNTY OF WALWORTH, STATE OF WISCONSIN.


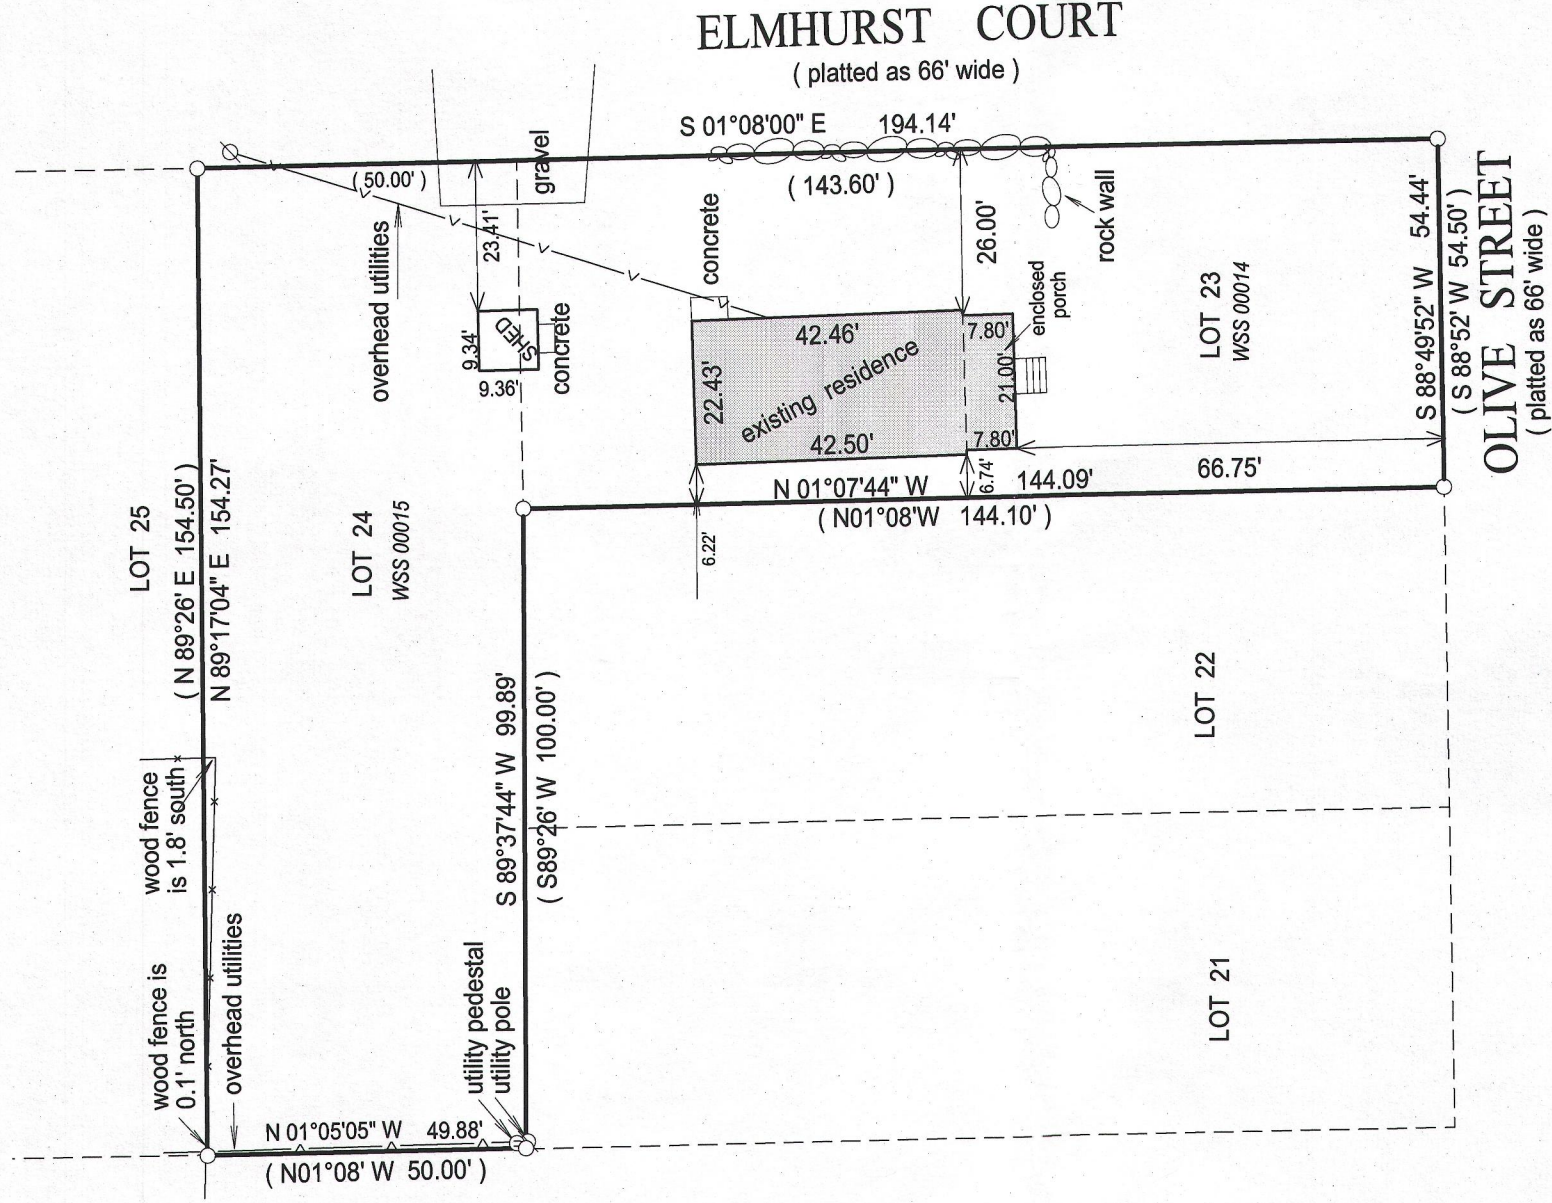


- () = recorded as
- = found iron bar
- = found iron pipe
- = set iron pipe
- = set iron bar

SCALE 1" = 30'

JOB # 13-29

TAX ID #
WSS 00014
WSS 00015

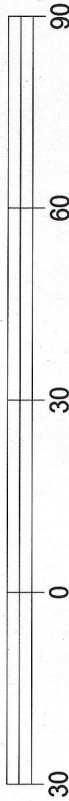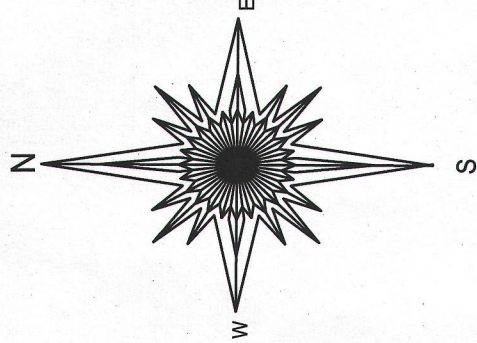

BASIS OF BEARING OF THIS PLAT: THE WEST LINE OF ELMHURST COURT WAS ASSUMED TO BEAR S 01°08' E AS SHOWN ON THE RECORD SUBDIVISION PLAT OF STARKS SUBDIVISION.

I hereby certify that I have surveyed the above- described property and the above map is a true representation thereof and shows the size and location of the property, its exterior boundaries, the location and dimensions of all structures thereon, fences, apparent easements and roadways and visible encroachments if any.

This survey is made for the present owners of the property, and those who purchase, mortgage, or guarantee the title thereto, within one year from the date hereof.

DATED THIS 6th day of April, 2013.



JEFFREY L KIMPS S - 2436
Wisconsin Registered Land Surveyor
(original if signed in red)

WSS -14
WSS -15

011-2475