
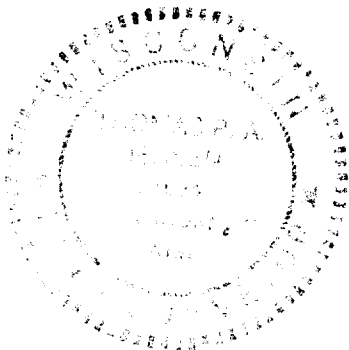


LOT 125 AND PART OF LOT 124, CEDAR POINT
PARK 2ND ADDITION, LOCATED IN THE NE $\frac{1}{4}$
OF SECTION 6, T1N R1E, VILLAGE OF
WILLIAMS BAY, WALKWORTH COUNTY, WISCONSIN.

\$ HIGHLAND ROAD -

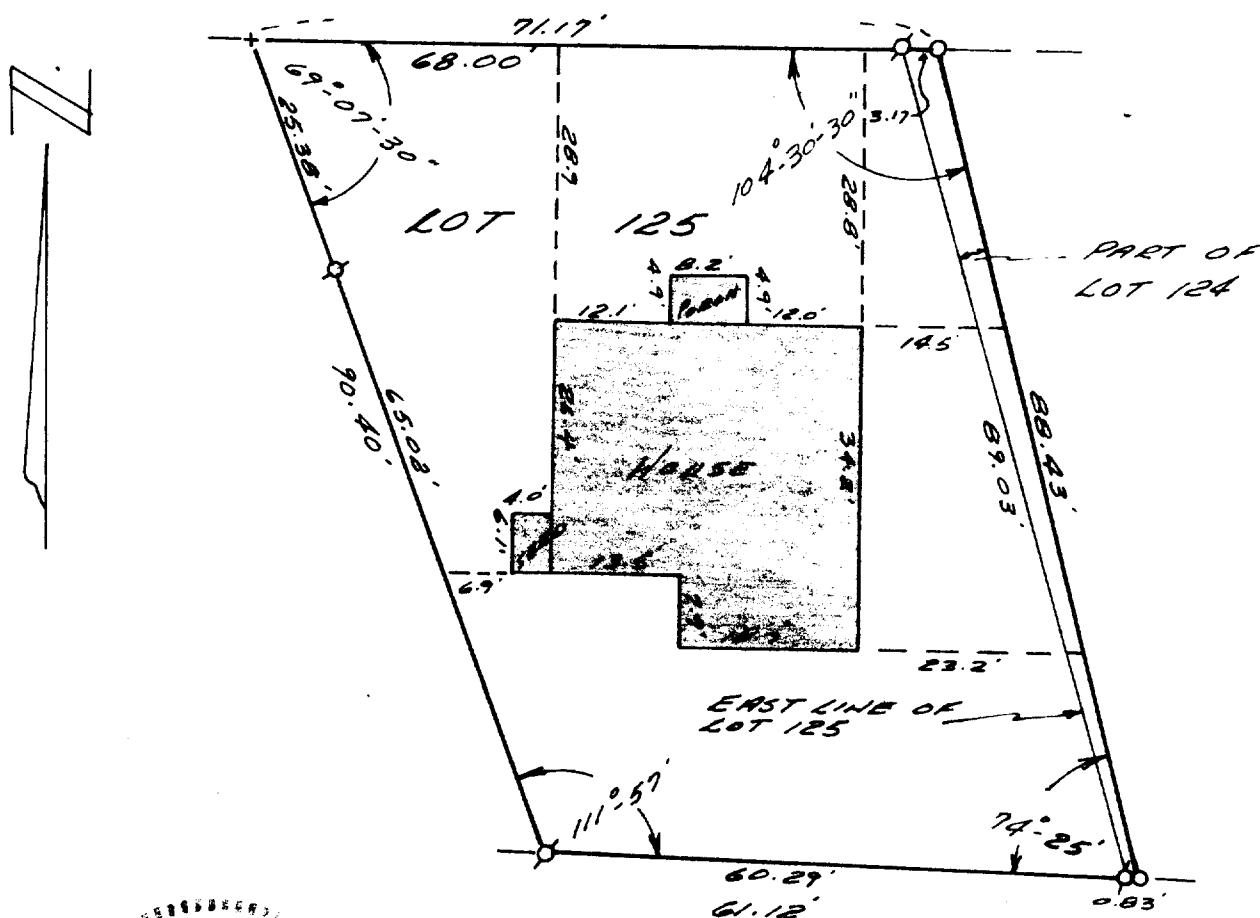

Elkhorn, Wisconsin

○ — Iron Pipe SET
● — Concrete Monument

0 - IRON PIPE FOUND

+ ~ CHISEL CROSS CUT
FOUND

WE CERTIFY: That we have surveyed the above described property and that the plat shown hereon is an accurate survey and a true representation thereof and correctly shows the exterior boundary lines and all divisions of said property, *AND ALL BUILDINGS THEREON.*

Date JULY 23, 1973

Wisconsin Registered Land Surveyor, No. S-[REDACTED]