


FARRIS, HANSEN & ASSOC. INC.

7 RIDGWAY COURT- P.O. BOX 437
ELKHORN, WISCONSIN 53121
PHONE (262) 723-2098
FAX (262) 723-5886

PLAT OF SURVEY
LOT 6 OF JOHNSON'S ADDITION TO THE
VILLAGE OF WILLIAMS BAY
LOCATED IN THE SE 1/4 OF THE NE 1/4 SEC. 1
T1N, R16E

ORDERED BY: GENEVA LAKEFRONT REALTY
49 WEST GENEVA STREET
WILLIAMS BAY, WI. 53191

VILLAGE OF WILLIAMS BAY
WALWORTH COUNTY, WI.

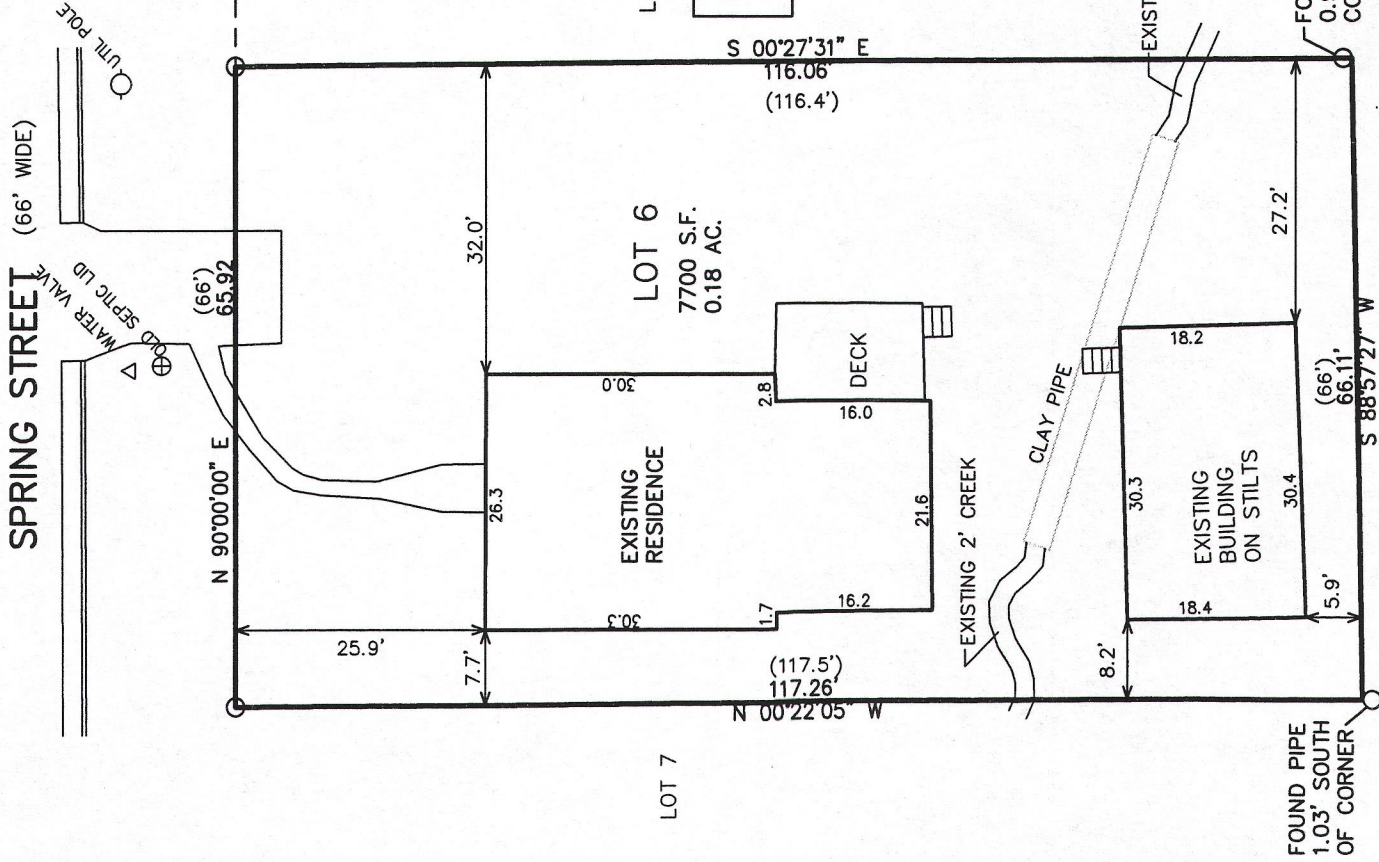

LEGEND
O = FOUND IRON PIPE STAKE
(XXX) = RECORDED AS

LOT 7

LOT 5

Lot 6, in Johnson's Addition to the Village of Williams Bay, according to the recorded plat thereof, in the Village of Williams Bay, County of Walworth, State of Wisconsin.
Tax Key No: WJA-00005



ASSIGNED SOUTH LINE SPRING STREET
N 90°00'00" E

NOTE: COPIES OF THIS MAP TO WHICH THE FOLLOWING CERTIFICATE WILL APPLY SHOW THE SURVEYOR'S ORIGINAL SEAL AND SIGNATURE IN RED INK. COPIES BY ANY OTHER MEANS MAY HAVE ALTERATIONS WHICH DO NOT REPRESENT THE SURVEYOR'S WORK PRODUCT.


I HEREBY CERTIFY THAT THE ABOVE DESCRIBED PROPERTY HAS BEEN SURVEYED UNDER MY DIRECTION AND THAT THE ABOVE MAP IS A TRUE REPRESENTATION THEREOF AND SHOWS THE SIZE AND LOCATION OF THE PROPERTY, ITS EXTERIOR BOUNDARIES, THE LOCATION OF ALL VISIBLE STRUCTURES, AND DIMENSIONS OF ALL PRINCIPLE BUILDINGS THEREON, BOUNDARY FENCES, APPARENT EASEMENTS, ROADWAYS, AND VISIBLE ENCROACHMENTS, IF ANY. THIS SURVEY IS MADE FOR THE USE OF THE PRESENT OWNERS OF THE PROPERTY, AND ALSO THOSE WHO PURCHASE, MORTGAGE, OR GUARANTEE THE TITLE THERETO WITHIN ONE YEAR FROM THE DATE HEREOF.



DATED: JULY 23, 2013

PETER S. GORDON

PROJECT NO. 8853
DATED: 07-23-2013
SHEET 1 OF 1 SHEETS

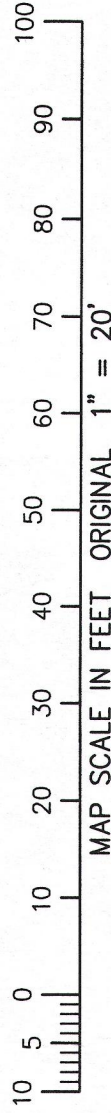

JUL 29 2013

WJA-5

011-2480