



PREPARED FOR
CHRISTINE FOX
SHOREWEST REALTY
830 E GENEVA ST
DELAVAN, WI 53115

PLAT OF SURVEY

- OF -

PATHFINDER SURVEYING INC.
(formerly)
J.K. SURVEYING INC.
P.O BOX 322
LAKE GENEVA, WI. 53147
WWW.PATHFINDERSURVEYING.NET
262-248-8303

LOT 257 AND THE SOUTH 1/2 OF LOT 254, CEDAR POINT PARK THIRD ADDITION, BEING A PART OF THE EAST 1/2 OF FRACTIONAL SECTION 6 AND 7, TOWN 1 NORTH, RANGE 17 EAST, VILLAGE OF WILLIAMS BAY, WALWORTH COUNTY, WISCONSIN.

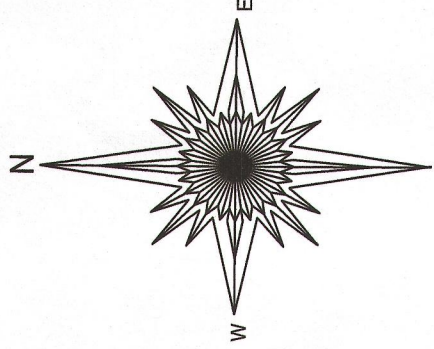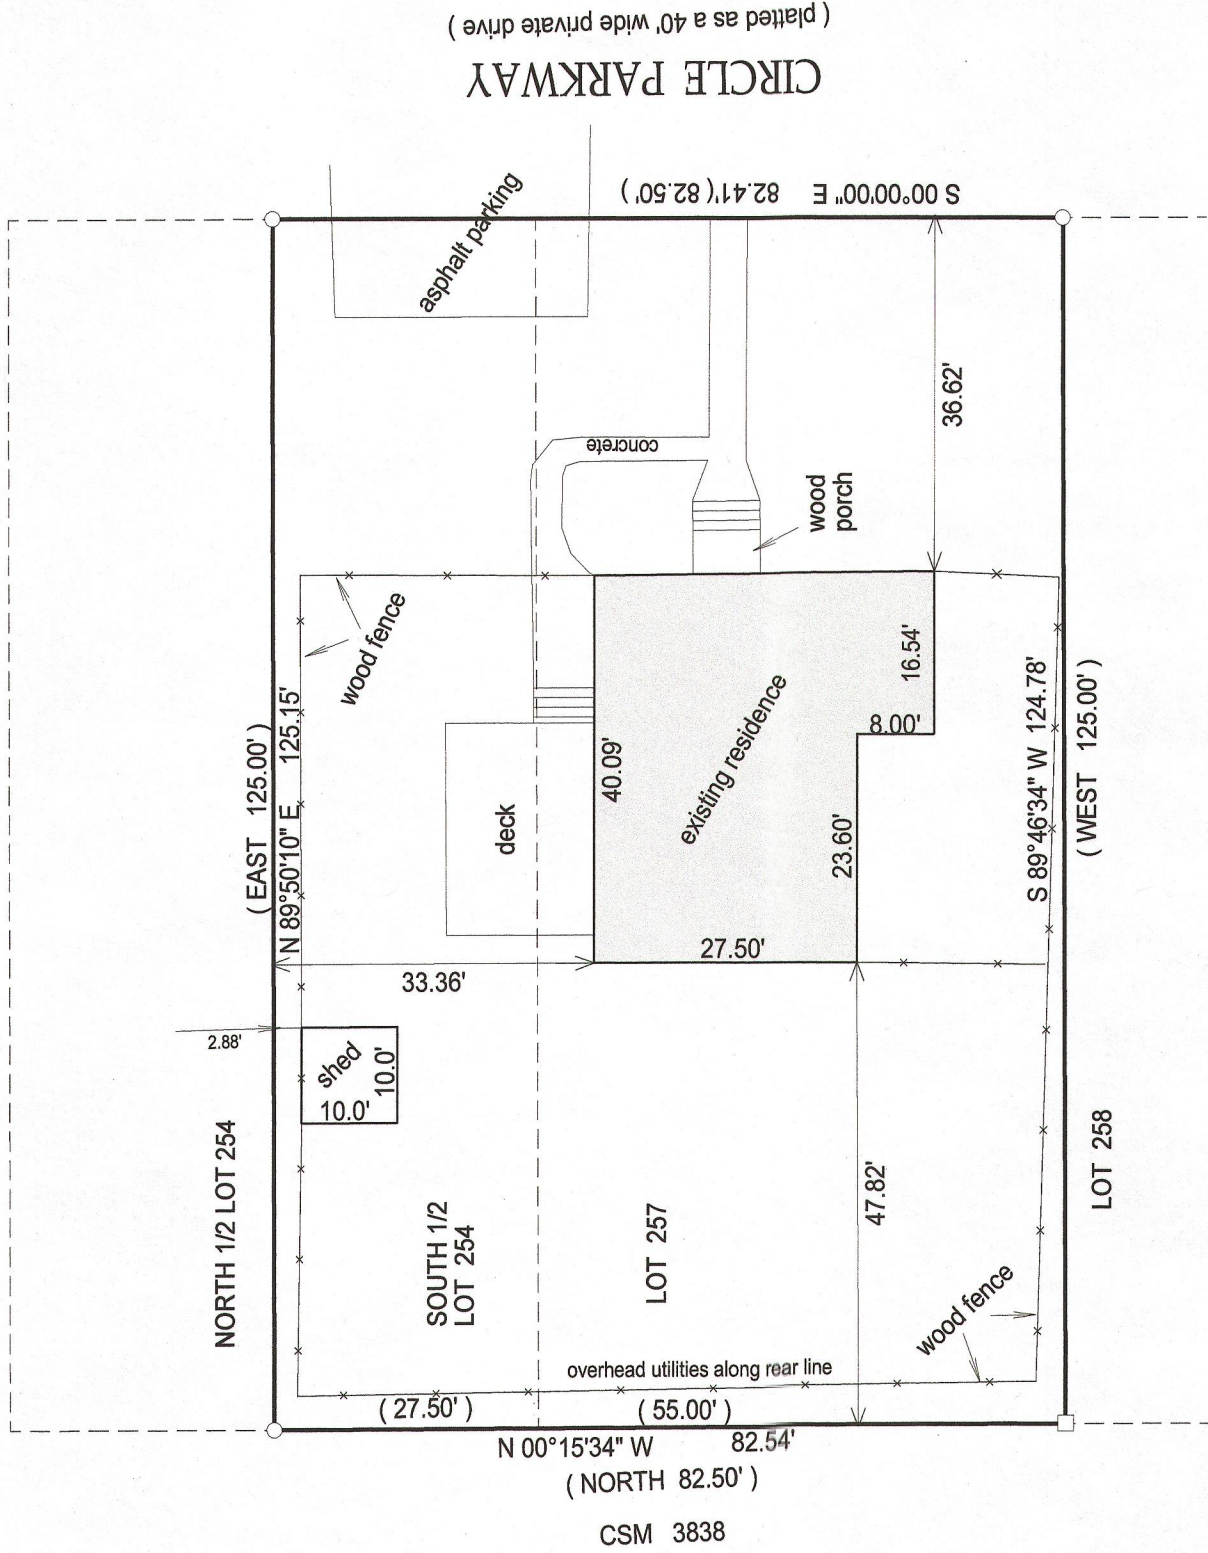

- () = recorded as
- = found iron bar
- = found iron pipe
- = set iron pipe
- = set iron bar

SCALE 1" = 20'

JOB # 13-169


TAX ID #
WCP300046 & WCP300048

BASIS OF BEARING OF THIS PLAT: THE WEST LINE OF CIRCLE PARKWAY WAS ASSUMED TO BEAR SOUTH AS SHOWN ON THE RECDORD SUBDIVISION PLAT.

I hereby certify that I have surveyed the above- described property and the above map is a true representation thereof and shows the size and location of the property, its exterior boundaries, the location and dimensions of all structures thereon, fences, apparent easements and roadways and visible encroachments if any.

This survey is made for the present owners of the property, and those who purchase, mortgage, or guarantee the title thereto, within one year from the date hereof.

DATED THIS 10TH DAY OF SEPTEMBER, 2013.

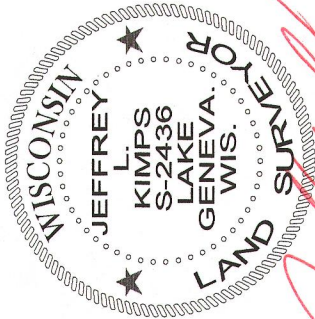

JEFFREY L. KIMPS S - 2436
Wisconsin Registered Land Surveyor
(original if signed in red)

WCP3 -46
WCP3 -48

011-2483