


OF

27

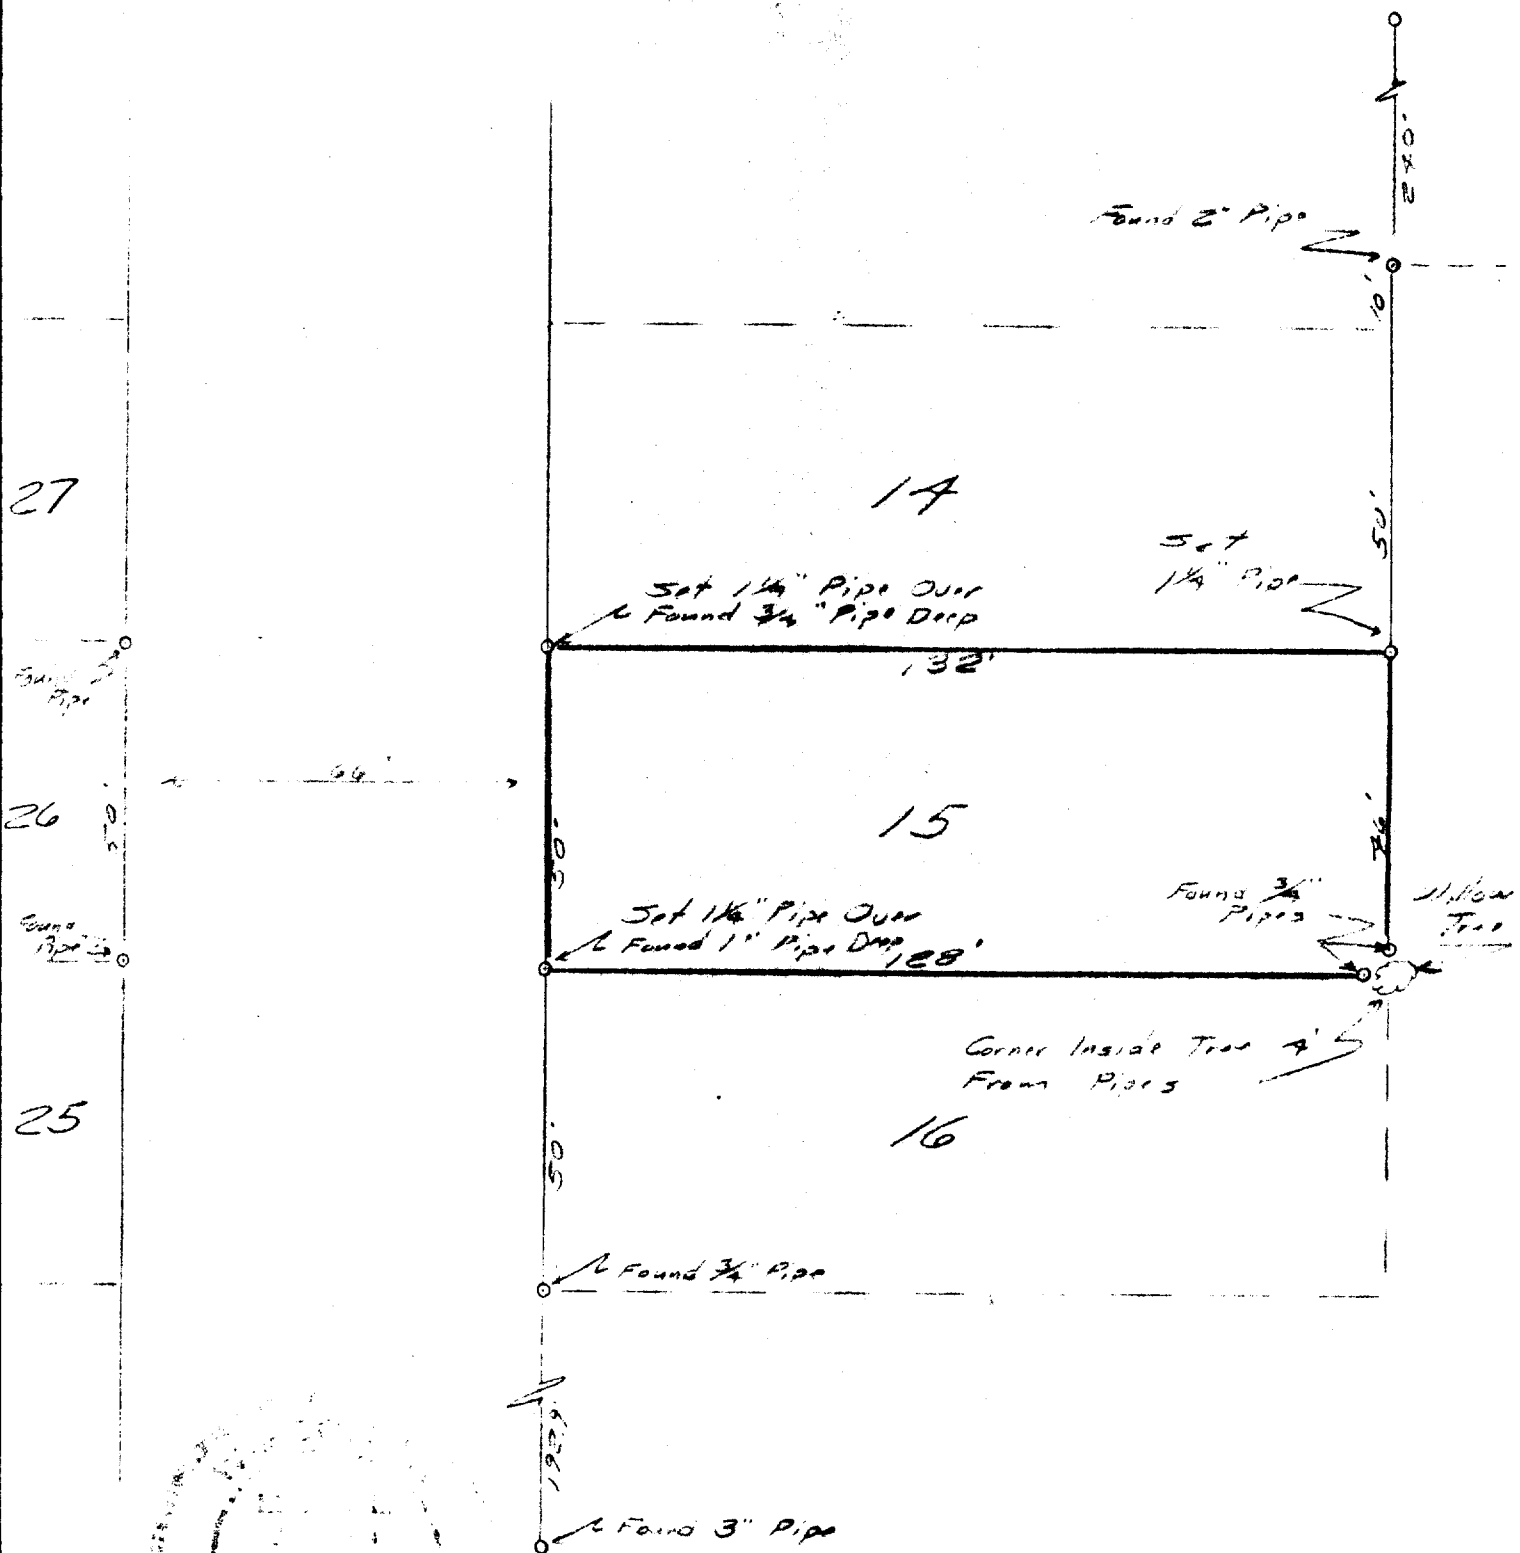

JENSEN & JOHNSON, INC.
CIVIL ENGINEERS AND SURVEYORS

LEGEND

- — Iron Pipe
● — Concrete Monument

WE CERTIFY: That we have surveyed the above described property and that the plat shown hereon is an accurate survey and a true representation thereof and correctly shows the exterior boundary lines and all divisions of said property.

Date Aug 1973

Lloyd L. Jensen
LLOYD L. JENSEN

Wisconsin Registered Land Surveyor, No. S-211