

PREPARED FOR
MICHAEL VANDERBUNT
106 W. GENEVA ST.
WILLIAMS BAY WI. 53191

PLAT OF SURVEY



- OF -

LOT 6, BLOCK 3, ORIGINAL PLAT OF WILLIAMS BAY,
WALWORTH COUNTY, WISCONSIN.

KROTT SURVEYING INC.
N3705 WILLOW BEND LANE
LAKE GENEVA WI. 53147
PHONE # (262)248-3697
FAX # (262)249-0639

C.L. CHERRY STREET

(66' WIDE ROAD)

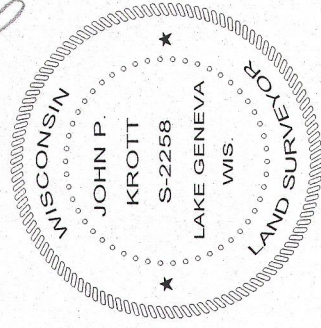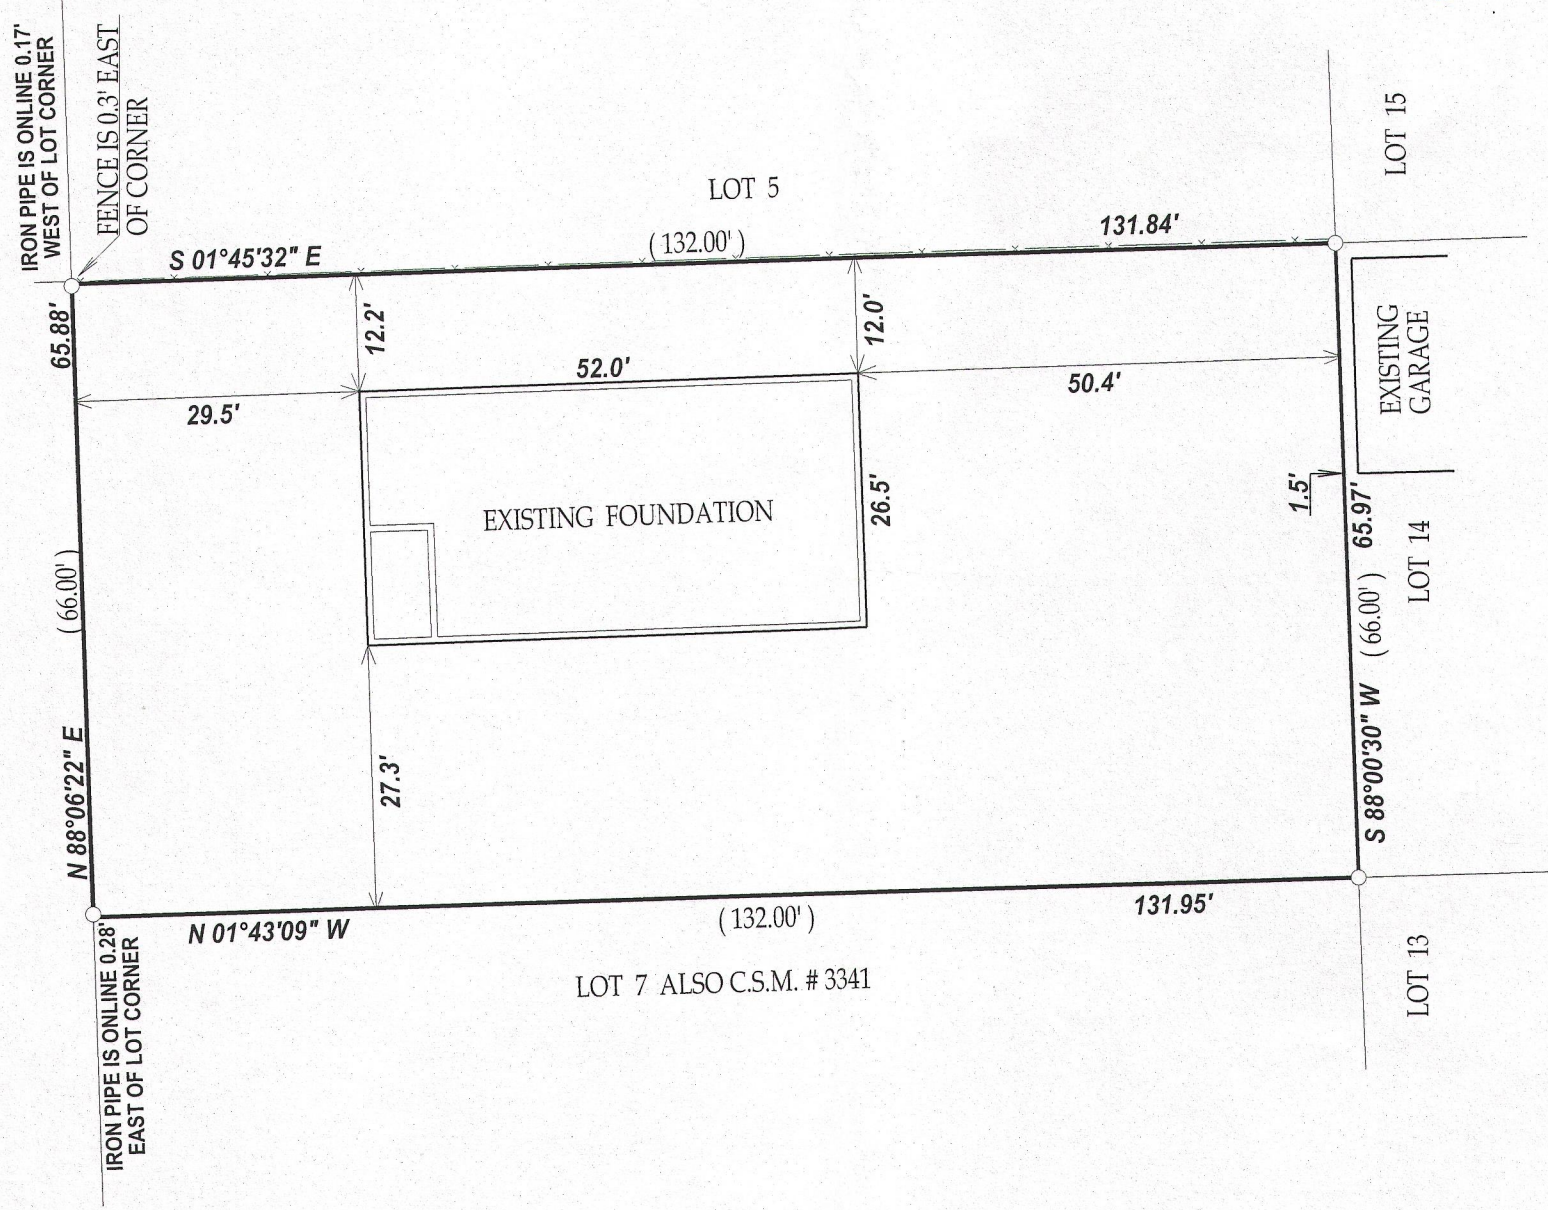

NOTE : BEARINGS ARE REFERENCED TO PREVIOUS SURVEY RECORDS



LEGEND

○ FOUND IRON PIPE

(XX) RECORDED AS

TAX ID # WOP00036

JOB # 05-094AB2013

DATED THIS 26th DAY OF MARCH 2013
DATE OF LAST REVISION: 09 / 11 / 2013
REVISED 6 / 12 / 2013

John P. Krott

JOHN KROTT S - 2258
Wisconsin Registered Land Surveyor
(original if signed in red)

011-2490