

PREPARED FOR
TOM OSTRANDER
403 FAIR OAKS DR
WILLIAMS BAY, WI.




PLAT OF SURVEY

- OF -

PATHFINDER SURVEYING INC.
(formerly)
J.K. SURVEYING INC.
N3705 WILLOWBEND LANE
LAKE GENEVA, WI, 53147
262-248-8303

LOT 10 IN BLOCK 6 OF LAKEWOOD TRAILS SUBDIVISION, A SUBDIVISION
LOCATED IN THE NORTHEAST 1/4 AND THE NORTHWEST 1/4 OF THE
NORTHWEST 1/4 OF SECTION 1, IN TOWNSHIP 1 NORTH, RANGE 16 EAST,
OF THE FOURTH PRINCIPAL MERIDIAN, VILLAGE OF WILLIAMS BAY, COUNTY
OF WALWORTH AND STATE OF WISCONSIN.

FAIR OAKS DRIVE
(PLATTED AS 66' WIDE)

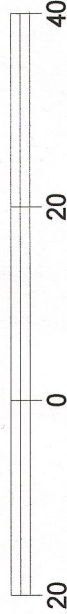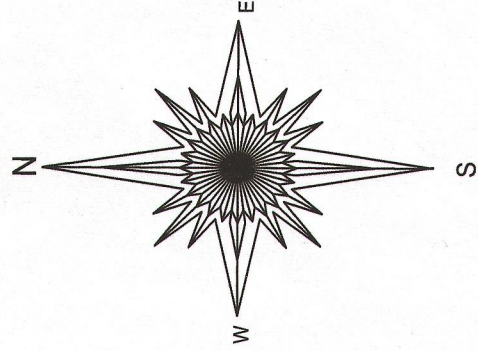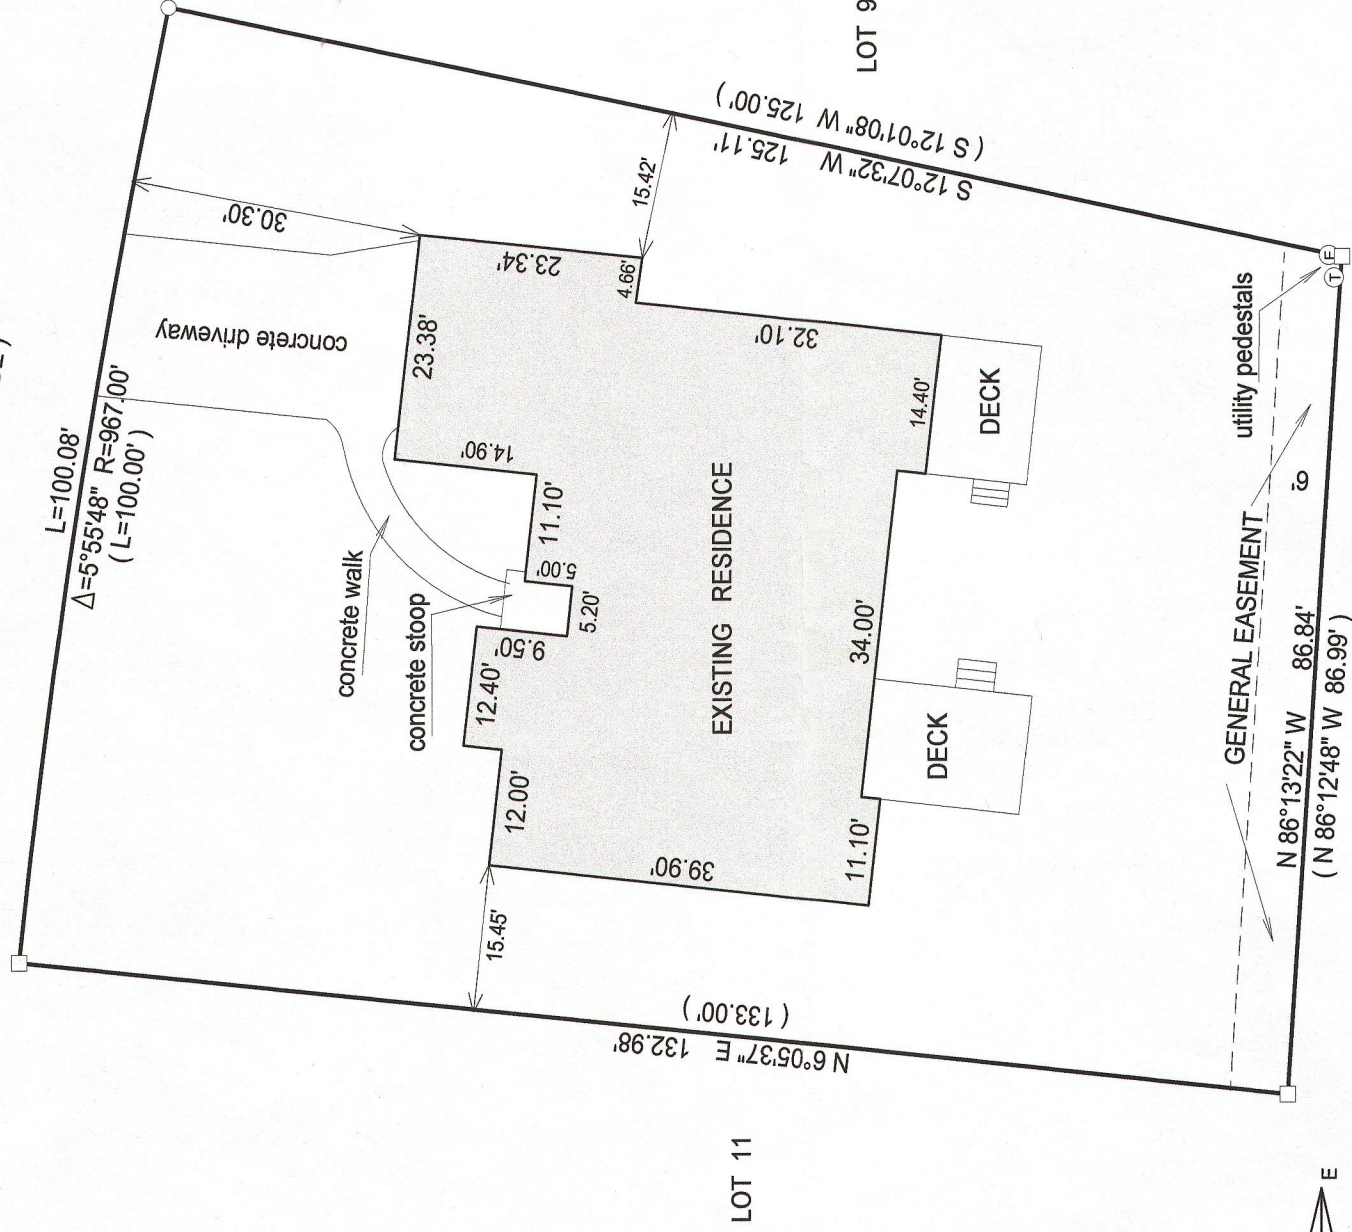

BASIS OF BEARING OF THIS PLAT: THE WEST LINE
OF LOT 10 BLOCK 6 WAS ASSUMED TO BEAR:
N6°05'37" E AS SHOWN ON THE RECORD PLAT.

- () = recorded as
- = found iron bar
 - = found iron pipe
 - = set iron pipe
 - = set iron bar


SCALE 1" = 20'

JOB # 08-060

TAX ID #

wlak 00100

REVISED 9/16/2013 ADDED NEW DECK
NO OTHER CHANGES

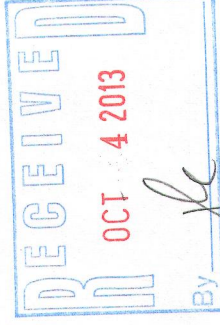

"I hereby certify that I have surveyed the above described property and that
the above map is a true representation thereof and shows the size and
location of all visible structures, apparent easements and encroachments
if any."

This survey is made for the present owners of the property, and those who
purchase, mortgage, or guarantee the title thereto, within one year from
the date hereof.

DATED THIS 13TH DAY OF MAY, 2008.

WLAK-100

011-2501