


FARRIS, HANSEN & ASSOC. INC.

7 RIDGWAY COURT- P.O. BOX 437
ELKHORN, WISCONSIN 53121
PHONE (262) 723-2098
FAX (262) 723-5886

ORDERED BY: SANDRA VESELKA
62 WOODEN BRIDGE DRIVE
YORKVILLE, IL. 60560

PLAT OF SURVEY
LOTS Y & Z OF LOCH VISTA CLUB SUBDIVISION NO. 2
LOCATED IN THE SE 1/4 SECTION 1
TOWN 1 NORTH, RANGE 16 EAST
VILLAGE OF WILLIAMS BAY, WALWORTH COUNTY, WISCONSIN

LOWER LOCH VISTA DRIVE (25' WIDE)

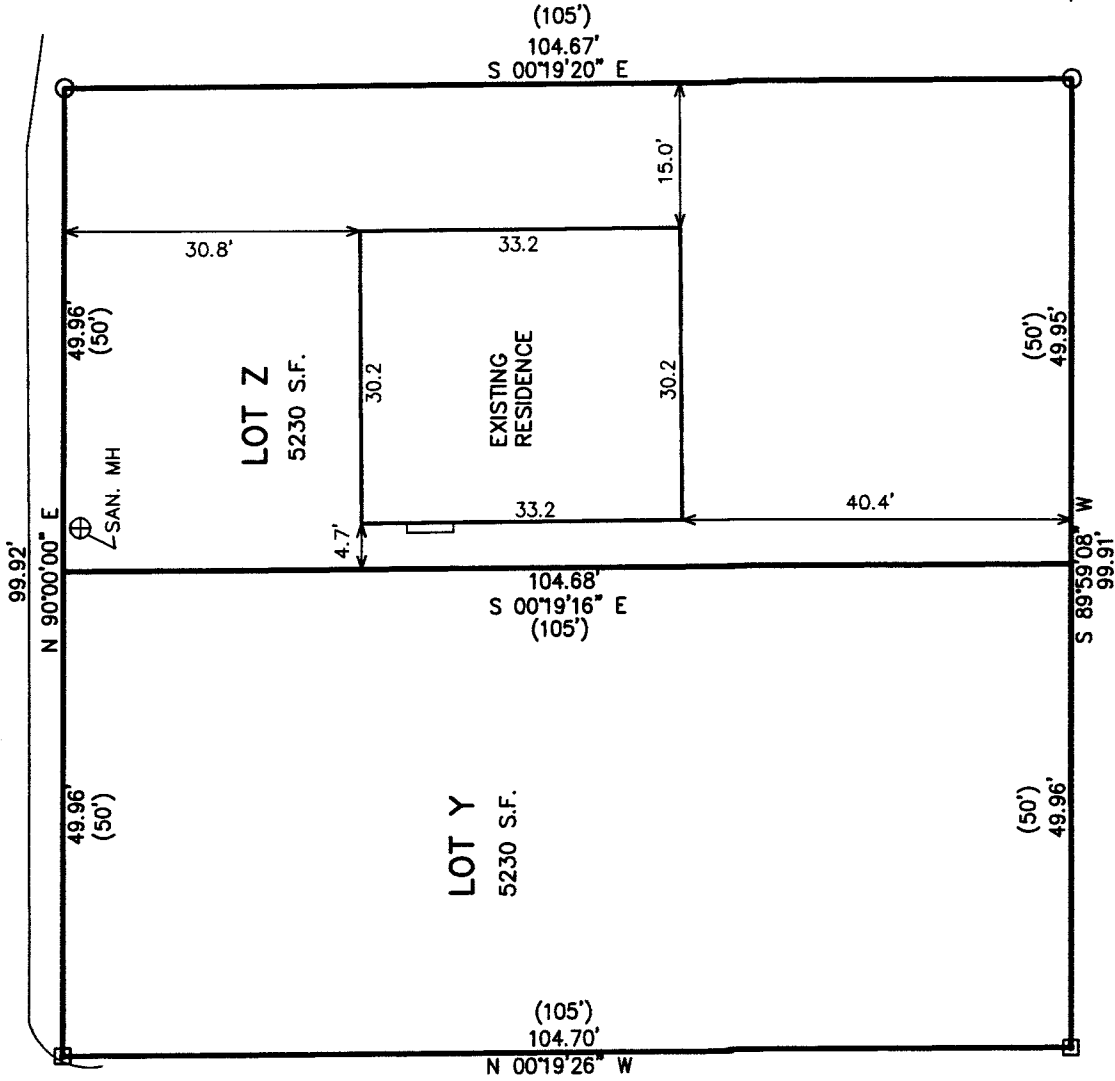

LEGEND

- = FOUND IRON PIPE STAKE
- = FOUND CONCRETE MONUMENT
- (XXX) = RECORDED AS


NOTE: COPIES OF THIS MAP TO WHICH THE FOLLOWING CERTIFICATE WILL APPLY SHOW SURVEYOR'S ORIGINAL SEAL AND SIGNATURE IN RED INK. COPIES BY ANY OTHER MEANS MAY HAVE ALTERATIONS WHICH DO NOT REPRESENT THE SURVEYOR'S WORK PRODUCT.

I HEREBY CERTIFY THAT THE ABOVE DESCRIBED PROPERTY HAS BEEN SURVEYED UNDER MY DIRECTION AND THAT THE ABOVE MAP IS A TRUE REPRESENTATION THEREOF AND SHOWS THE SIZE AND LOCATION OF THE PROPERTY AND ITS EXTERIOR BOUNDARIES. THIS SURVEY IS MADE FOR THE USE OF THE PRESENT OWNERS OF THE PROPERTY, AND ALSO THOSE WHO PURCHASE, MORTGAGE, OR GUARANTEE THE TITLE THERETO WITHIN ONE YEAR FROM THE DATE HEREOF.

DATED: OCTOBER 14, 2013

PETER S. GORDON R.L.S. 2101

PROJECT NO. 8895
DATED: 10-14-2013
SHEET 1 OF 1 SHEETS

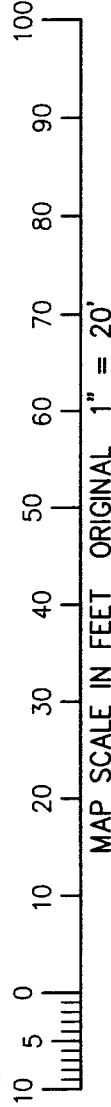

OCT 14 2013

WL V2 -19

WL V2 -20

011-2504

ASSIGNED NORTH LINE LOTS Y & Z
N 90°00'00" E

NOV 27 2013

