

PREPARED FOR:  
DOROTHY HIGGINS GERBER  
SHOREWEST REALTOR'S  
623 MAIN ST.  
LAKE GENEVA, WI 53147


# PLAT OF SURVEY

-OF-

LOT 2 IN BLOCK 15 OF WILLIAMS SECOND ADDITION, VILLAGE OF WILLIAMS BAY, WALWORTH COUNTY, WISCONSIN.

KROTT SURVEYING INC.

N3705 WILLOW BEND LANE  
LAKE GENEVA WI. 53147  
PHONE # (262)248-3697  
FAX # (262)249-0639

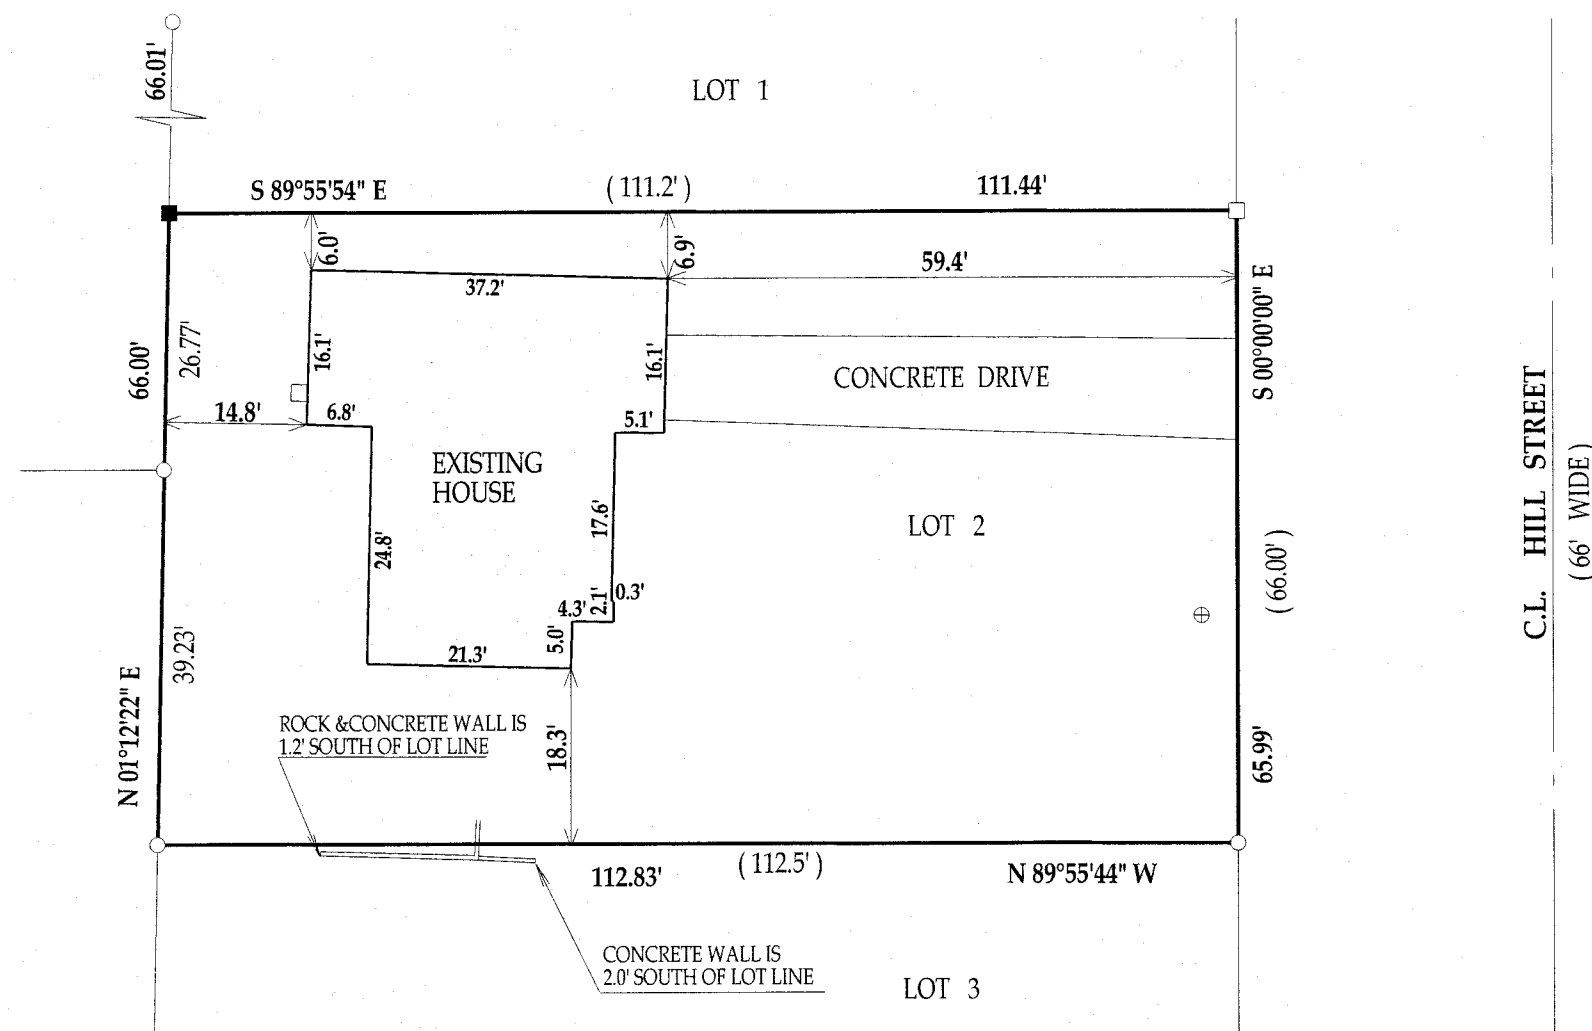




### LEGEND

- FOUND IRON PIPE  
⊕ STEEL LID  
■ SET IRON BAR  
(XX) RECORDED AS

JOB # 13-156      TAX ID # WOP00211

I have surveyed the above-described property and the above map is a true representation thereof and shows the size and location of the property, its exterior boundaries, the location and dimensions of all structures thereon, fences apparent easements and roadways and visible encroachments, if any.

This survey is made for the exclusive use of the present owners of the property, and also those who purchase, mortgage, or insure the title thereto within one (1) year from date hereof; and as to them I warrant the accuracy of said survey map.

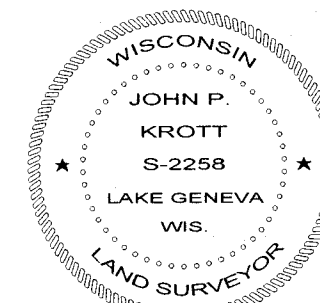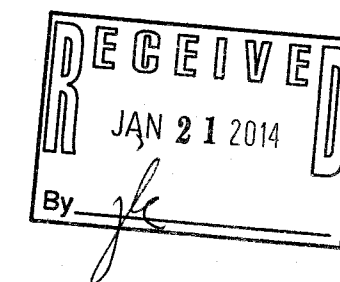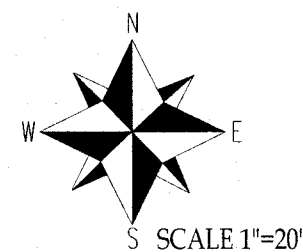

DATED THIS 10th, DAY OF OCTOBER, 2013

  
JOHN KROTT S - 2258  
Wisconsin Registered Land Surveyor  
( original if signed in red )

WOP -211

011-2514