


FARRIS, HANSEN & ASSOCIATES, INC.

ENGINEERING - ARCHITECTURE - SURVEYING
7 RIDGWAY COURT - P.O. BOX 437 - ELKHORN, WISCONSIN 53121
PHONE: (262) 723-2098 FAX: (262) 723-5886

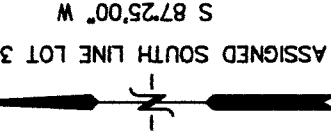

PLAT OF SURVEY


LOT 39 BAY VIEW SUBDIVISION
PART OF THE NW 1/4 OF THE SE 1/4 SEC. 1
TOWN 1 NORTH, RANGE 16 EAST
VILLAGE OF WILLIAMS BAY, WALWORTH COUNTY, WI.

WORK ORDERED BY -
RAULAND AGENCY
PO BOX 159
WALWORTH, WI. 53184

PARCEL 1: Lot 39, in Bay View Subdivision, Village of Williams Bay, Walworth County, Wisconsin.

PARCEL 2: Together with an easement for driveway purposes over the Southerly 10 feet of Lot 38, in Bay View Subdivision, Village of Williams Bay, Walworth County, Wisconsin recorded on June 7, 1973 as Document No. 665574.

Tax Key No. WBV 00014

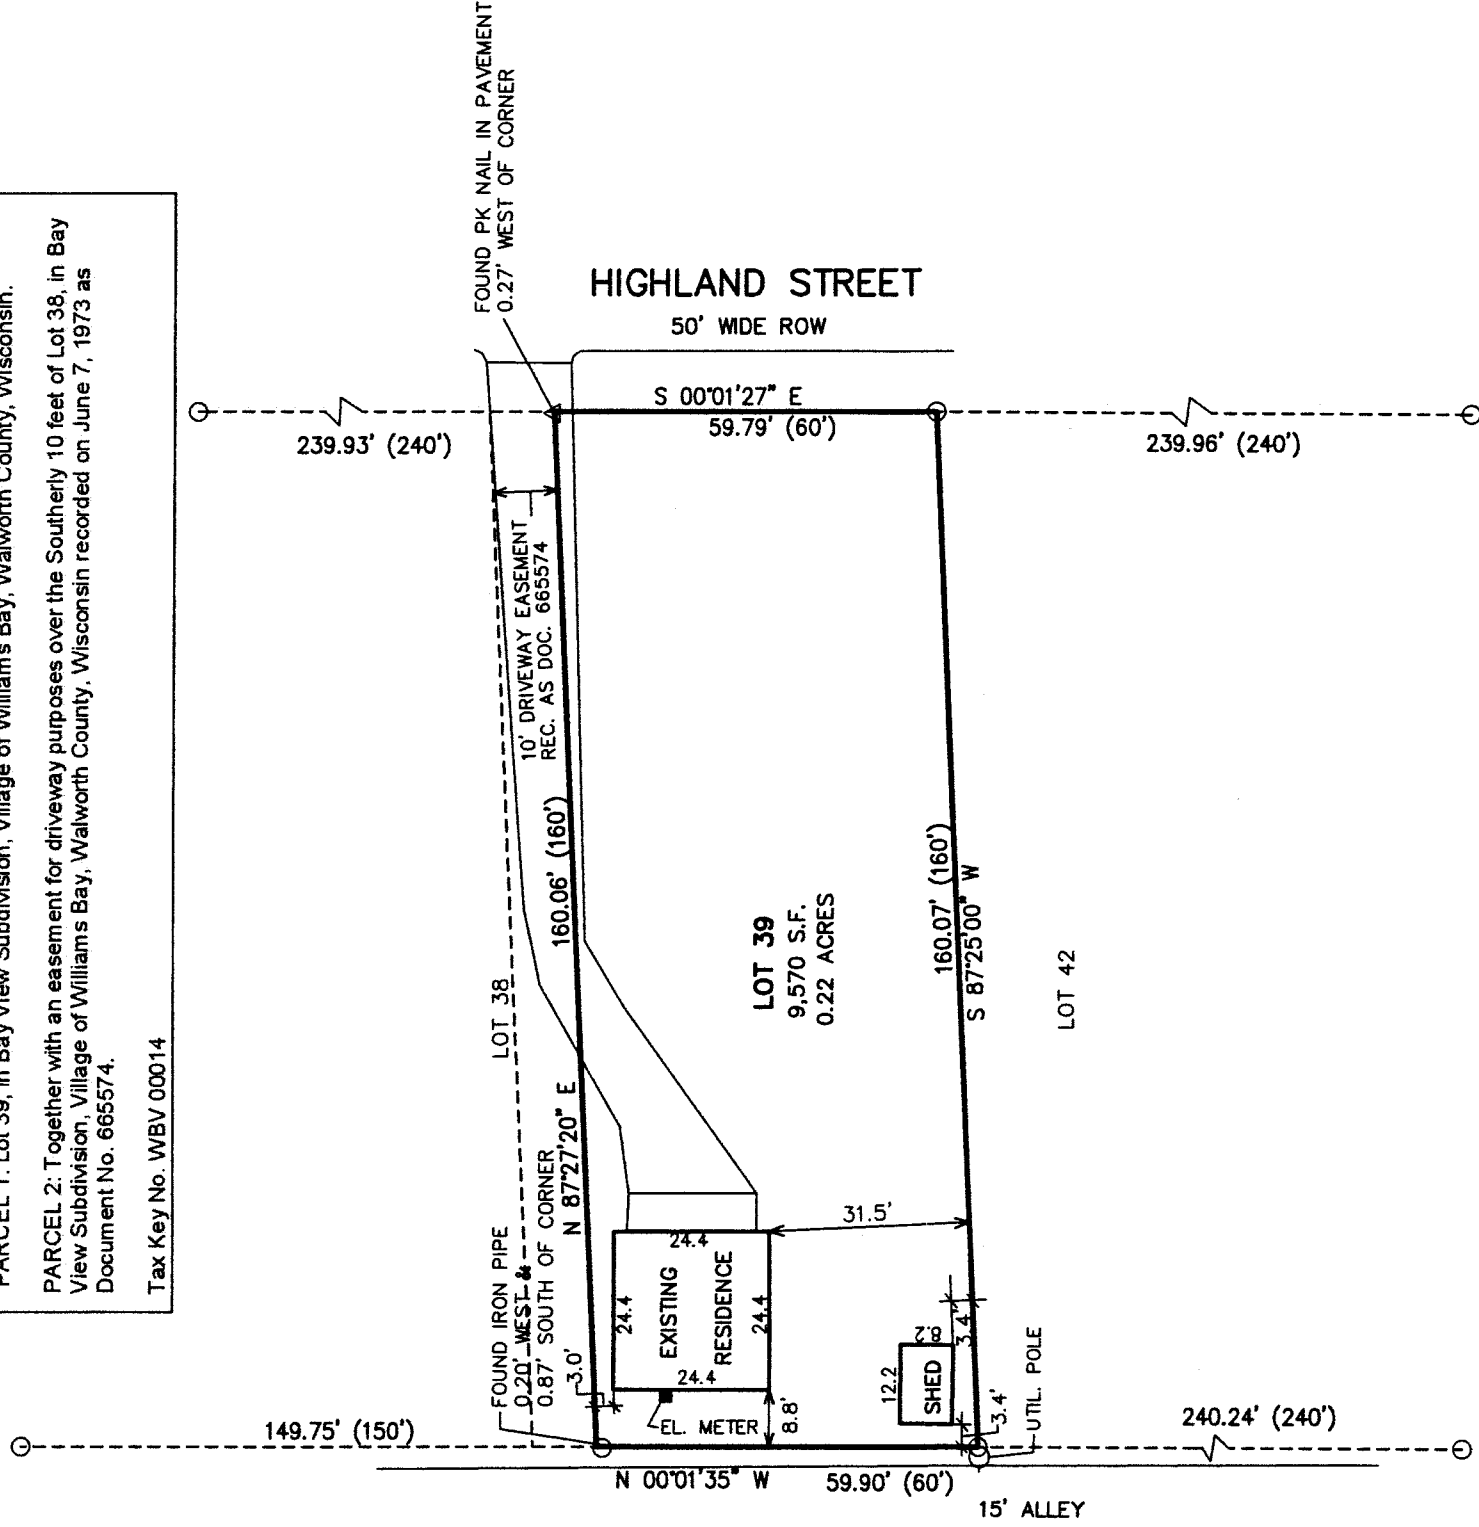


NOTE: COPIES OF THIS MAP TO WHICH THE FOLLOWING CERTIFICATE WILL APPLY SHOW THE SURVEYOR'S ORIGINAL SEAL AND SIGNATURE IN RED INK. COPIES BY ANY OTHER MEANS MAY HAVE ALTERATIONS WHICH DO NOT REPRESENT THE SURVEYOR'S WORK PRODUCT.

I HEREBY CERTIFY THAT THE ABOVE DESCRIBED PROPERTY HAS BEEN SURVEYED UNDER MY DIRECTION AND THAT THE ABOVE MAP IS A TRUE REPRESENTATION THEREOF AND SHOWS THE SIZE AND LOCATION OF THE PROPERTY, ITS EXTERIOR BOUNDARIES, THE LOCATION OF ALL VISIBLE STRUCTURES, AND DIMENSIONS OF ALL PRINCIPLE BUILDINGS THEREON, BOUNDARY FENCES, APPARENT EASEMENTS, ROADWAYS, AND VISIBLE ENCROACHMENTS, IF ANY. THIS SURVEY IS MADE FOR THE USE OF THE PRESENT OWNERS OF THE PROPERTY, AND ALSO THOSE WHO PURCHASE, MORTGAGE, OR GUARANTEE THE TITLE THERETO WITHIN ONE YEAR FROM THE DATE HEREOF.

DATED: JUNE 5, 2014

Peter S. Gordon
PETER S. GORDON

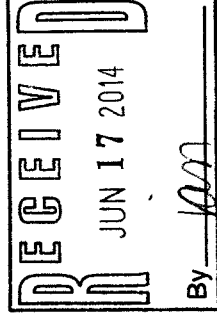

PROJECT: 9048
DATE: 6-4-2014
SHEET 1 OF 1

JUN 05 2014

WBV-14

011-2530