
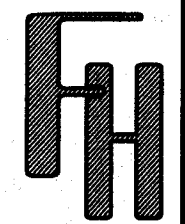


JUN 12 2014

6/12/2014 X:\Projects\9052\DCAD\SURVEY

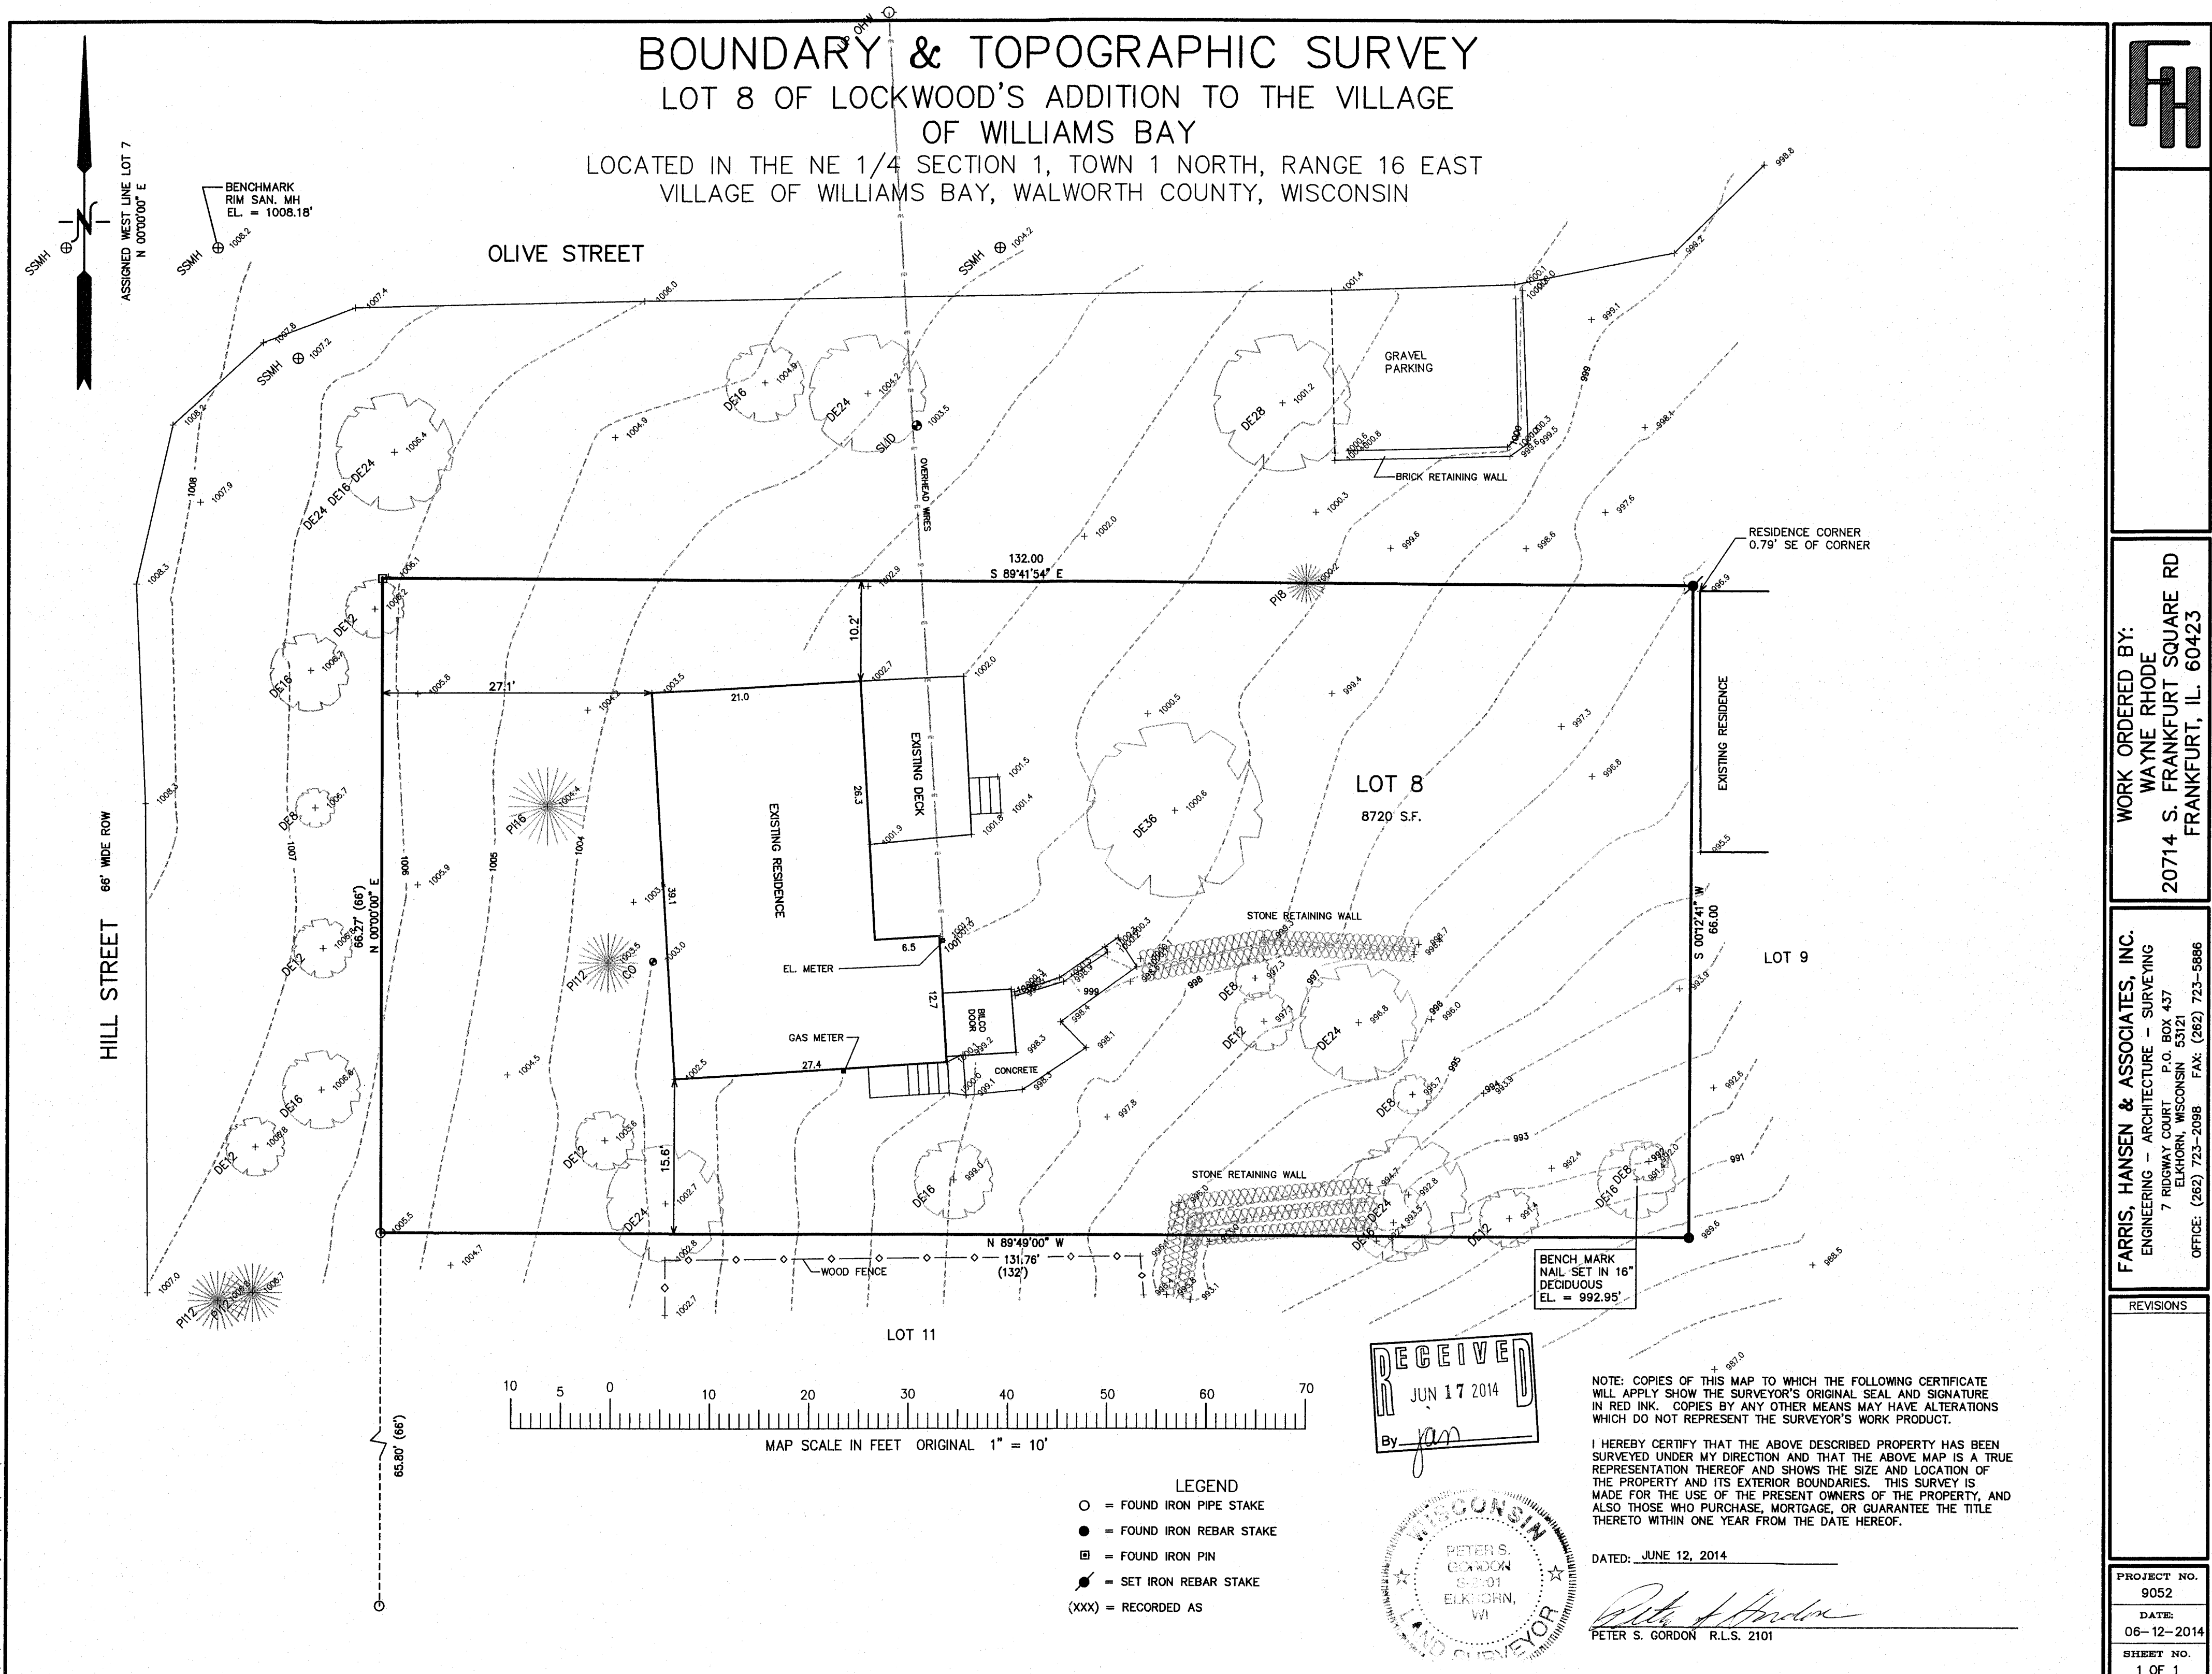

WORK ORDERED BY:
WAYNE RHODE
20714 S. FRANKFURT SQUARE RD
FRANKFURT, IL. 60423

FARRIS, HANSEN & ASSOCIATES, INC.
ENGINEERING - ARCHITECTURE - SURVEYING
7 RIDGWAY COURT P.O. BOX 437
ELKHORN, WISCONSIN 53121
OFFICE: (262) 723-2098 FAX: (262) 723-5886

REVISIONS

WLW -S 011-2531