

FARRIS, HANSEN & ASSOC. INC.

PLAT OF SURVEY

7 RIDGWAY COURT- P.O. BOX 437
ELKHORN, WISCONSIN 53121
PHONE (262) 723-2098
FAX (262) 723-5888



ORDERED BY: CHRIS OLSEN
PO BOX 77
ELKHORN, WI. 53121

LEGEND

- = FOUND IRON REBAR STAKE
- = FOUND IRON PIPE STAKE
- ▣ = FOUND CONCRETE MONUMENT
- (XXX) = RECORDED AS

LOT 6 MADISON'S ADDITION
TO THE VILLAGE OF WILLIAMS BAY
LOCATED IN THE NE 1/4 SEC. 1, T1N, R16E
VILLAGE OF WILLIAMS BAY, WALWORTH COUNTY, WI.

ASSIGNED WEST LINE COLLIE AVE
S 00°00'00" E

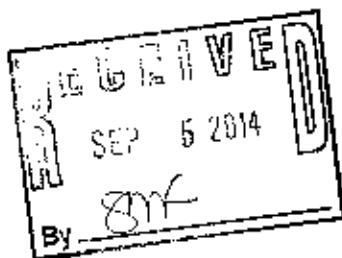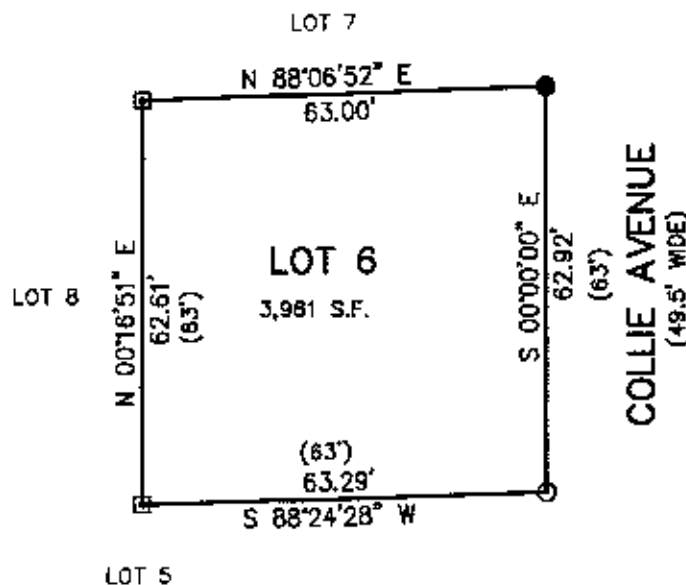

MAP SCALE IN FEET ORIGINAL 1" = 30'

NOTE: COPIES OF THIS MAP TO WHICH THE FOLLOWING CERTIFICATE WILL APPLY SHOW SURVEYOR'S ORIGINAL SEAL AND SIGNATURE IN RED INK. COPIES BY ANY OTHER MEANS MAY HAVE ALTERATIONS WHICH DO NOT REPRESENT THE SURVEYOR'S WORK PRODUCT.

I HEREBY CERTIFY THAT THE ABOVE DESCRIBED PROPERTY HAS BEEN SURVEYED UNDER MY DIRECTION AND THAT THE ABOVE MAP IS A TRUE REPRESENTATION THEREOF AND SHOWS THE SIZE AND LOCATION OF THE PROPERTY AND ITS EXTERIOR BOUNDARIES. THIS SURVEY IS MADE FOR THE USE OF THE PRESENT OWNERS OF THE PROPERTY, AND ALSO THOSE WHO PURCHASE, MORTGAGE, OR GUARANTEE THE TITLE THERETO WITHIN ONE YEAR FROM THE DATE HEREOF.

DATED: AUGUST 11, 2014

[Signature]
PETER S. GORDON R.L.S. 2101



PROJECT NO. 9110
DATED: 08-08-2014
SHEET 1 OF 1 SHEETS

AUG 11 2014 WMA-5

011-2539