


GEORGE T. DUNHAM
SURVEYING & SUBDIVIDING
DELAVAN, WISCONSIN

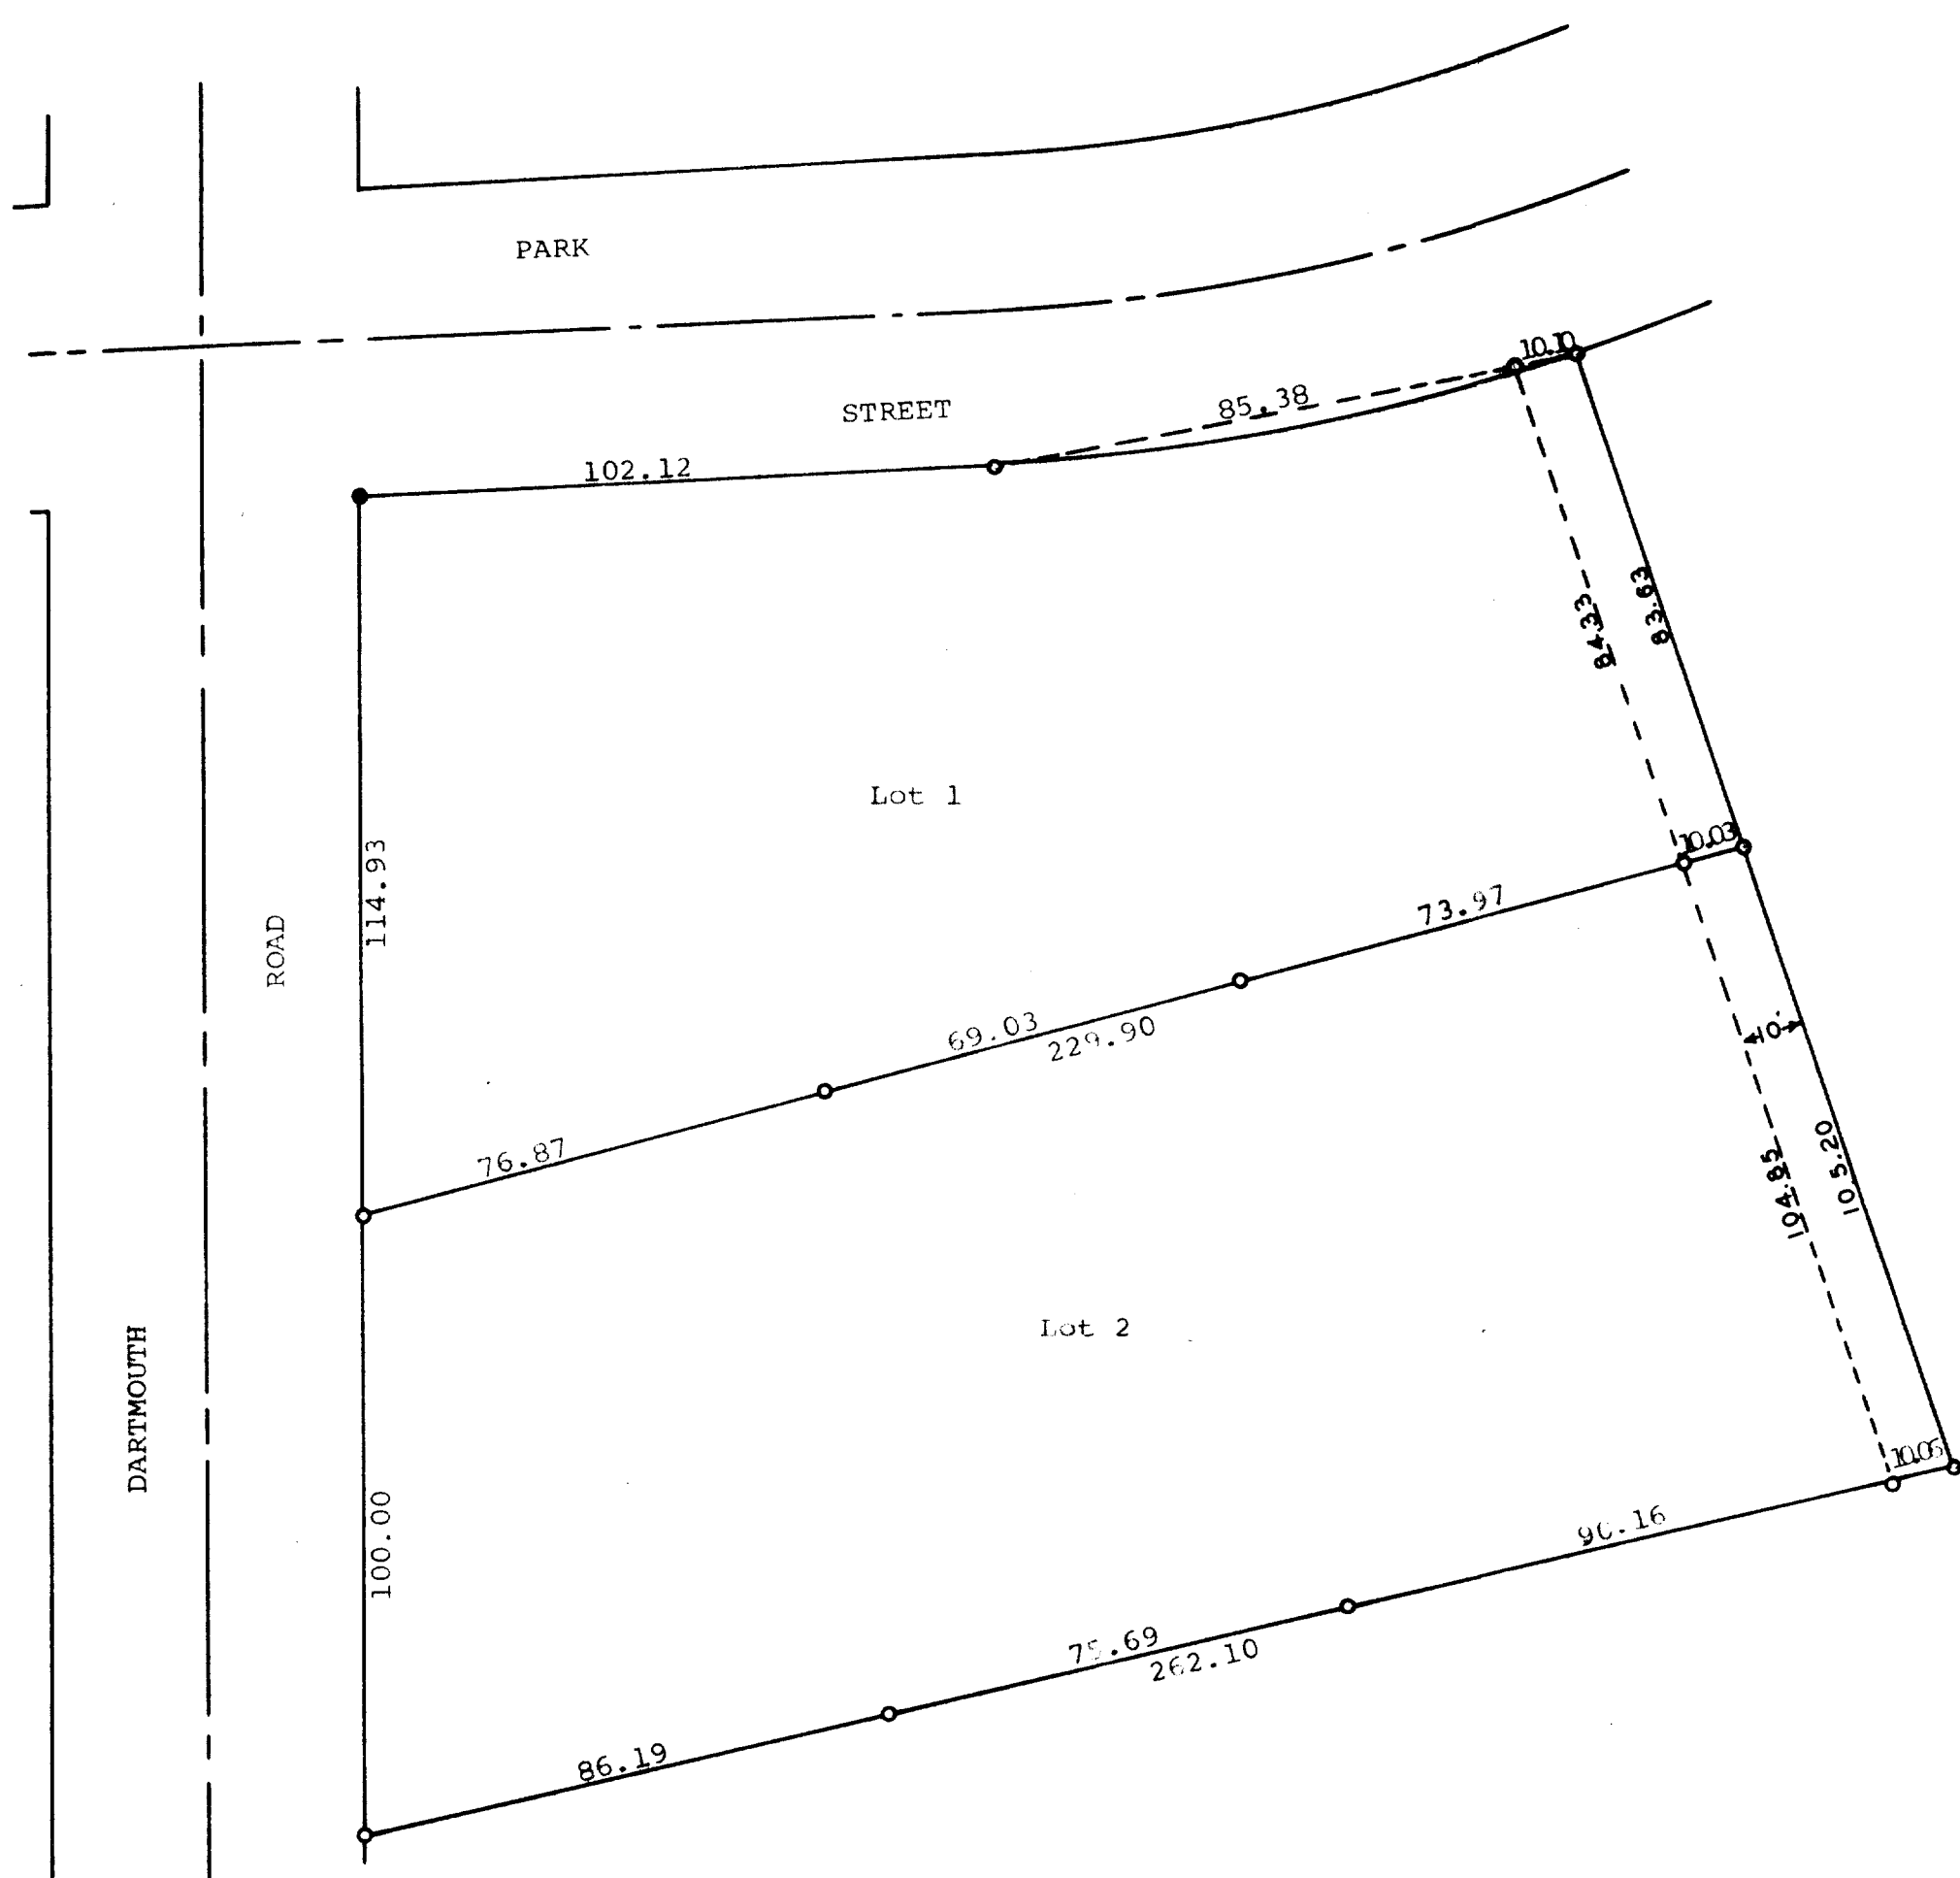

Scale - 1" = 30'
○ = Iron Pipe
● = Concrete Monument

STATE OF WISCONSIN)
COUNTY OF WALWORTH) SS

I, George T. Dunham, Surveyor, certify that I have surveyed
the property described as follows,

Lots 1 and 2 in Block 2, University Heights, Village of
Williams Bay, Walworth County, Wisconsin,

and that the plat shown hereon is an accurate survey and a true
representation thereof and correctly shows the exterior boundary
lines and that there are no buildings on said land at this time.
May 3, 1973

George T. Dunham
George T. Dunham, Surveyor

