




PREPARED FOR
DORTHY HIGGINS GERBER
SHOREWEST REALTY
LAKE GENEVA, WI

PLAT OF SURVEY

- OF -

PATHFINDER SURVEYING INC.
(formerly)
J.K. SURVEYING INC.
P.O BOX 322
LAKE GENEVA, WI. 53147
WWW.PATHFINDERSURVEYING.NET
262-248-8303

LOT 27 EXCEPT THE WEST 5 FEET, LOCH VISTA CLUB SUBDIVISION,
LOCATED IN THE SE 1/4 OF SECTION 1, TOWN 1 NORTH, RANGE 16
EAST, VILLAGE OF WILLIAMS BAY, WALWORTH COUNTY, WISCONSIN.

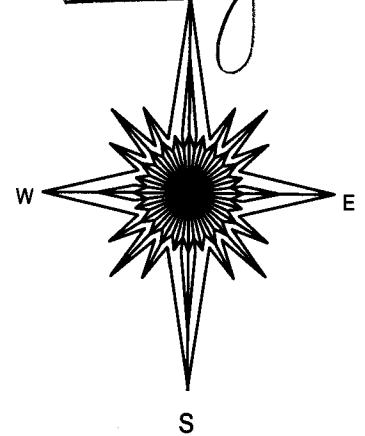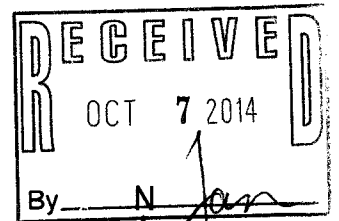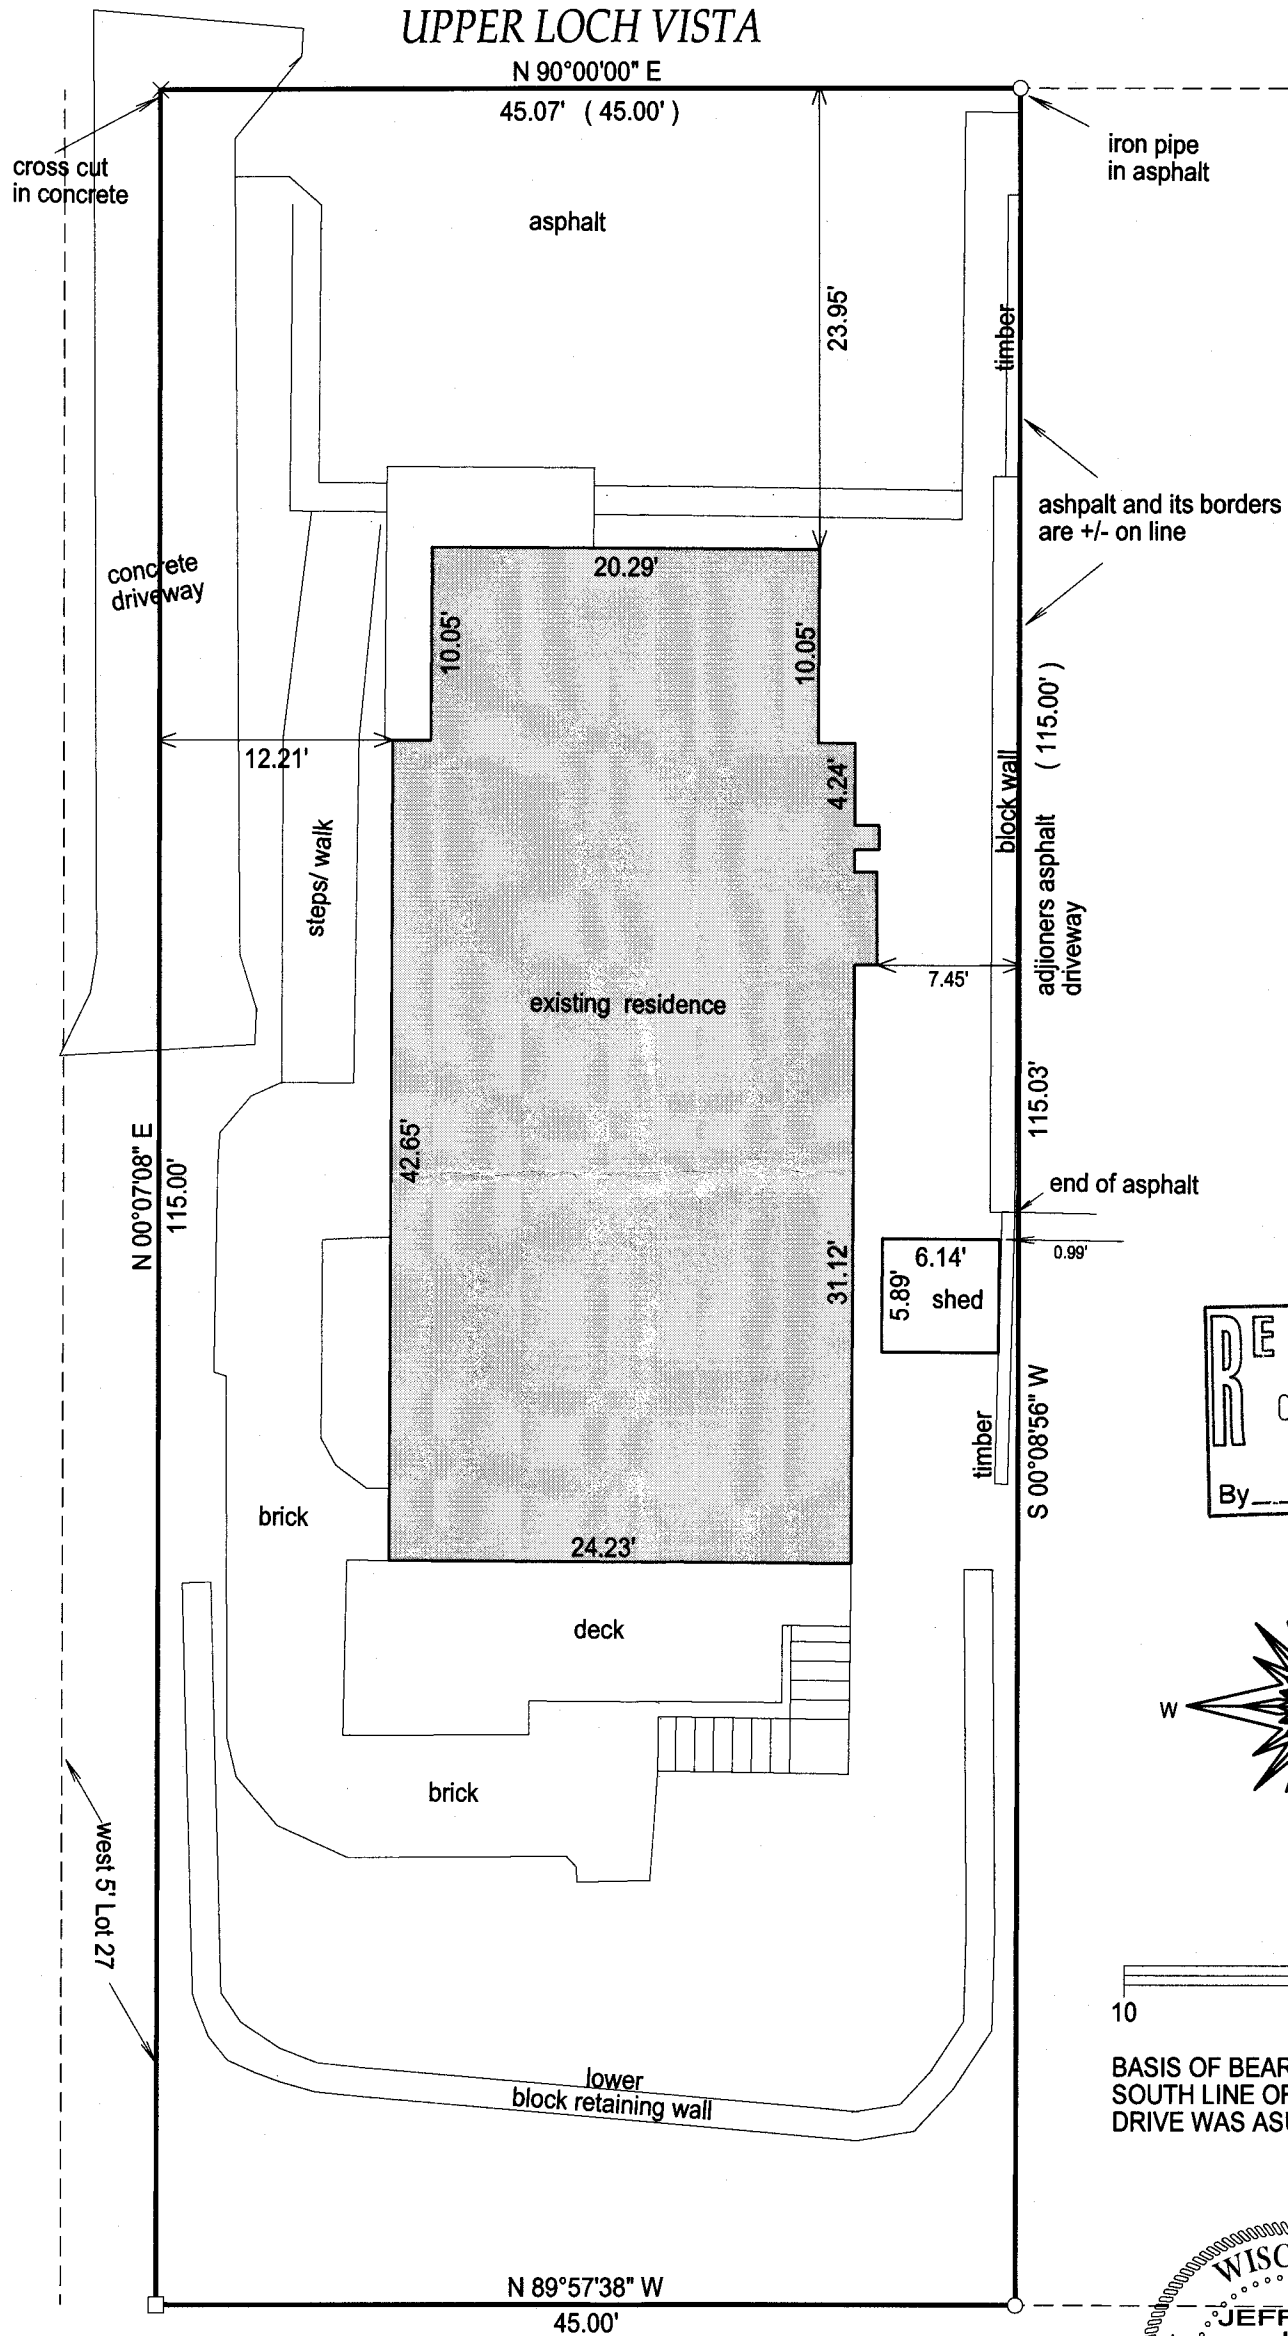

10 0 10

BASIS OF BEARING OF THIS PLAT: THE
SOUTH LINE OF UPPER LOCH VISTA
DRIVE WAS ASSUMED TO BEAR EAST.

- () = recorded as
□ = found iron bar
○ = found iron pipe
● = set iron pipe
■ = set iron bar

SCALE 1" = 10'

JOB # 14-188

TAX ID #
WLV00021

I hereby certify that I have surveyed the above- described property and the above map is a true representation thereof and shows the size and location of the property, its exterior boundaries, the location and dimensions of all structures thereon, fences, apparant easements and roadways and visible encroachments if any.

This survey is made for the present owners of the property, and those who purchase, mortgage, or guarantee the title thereto, within one year from the date hereof.

DATED THIS 20TH DAY OF AUGUST, 2014.



JEFFREY L. KIMPS S-2436
Wisconsin Registered Land Surveyor
(original if signed in red)

WLV -21

011-2544