




PREPARE FOR:
MARY KILKENNY
KEEFE REAL ESTATE
DEHAVAN, WI.

PLAT OF SURVEY

- OF -

LOT 4, BLOCK 18 OF WILLIAMS SECOND ADDITION,
A SUBDIVISION LOCATED IN THE NE 1/4 OF SECTION
1, TOWN 1 NORTH, RANGE 16 EAST, VILLAGE OF
WILLIAMS BAY, WALWORTH, COUNTY, WISCONSIN.

PATHFINDER SURVEYING INC.
(formerly)
J.K. SURVEYING INC.
P.O BOX 322
LAKE GENEVA, WI. 53147
WWW.PATHFINDERSURVEYING.NET
262-248-8303

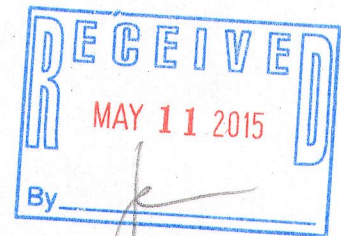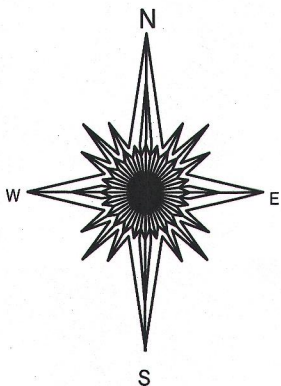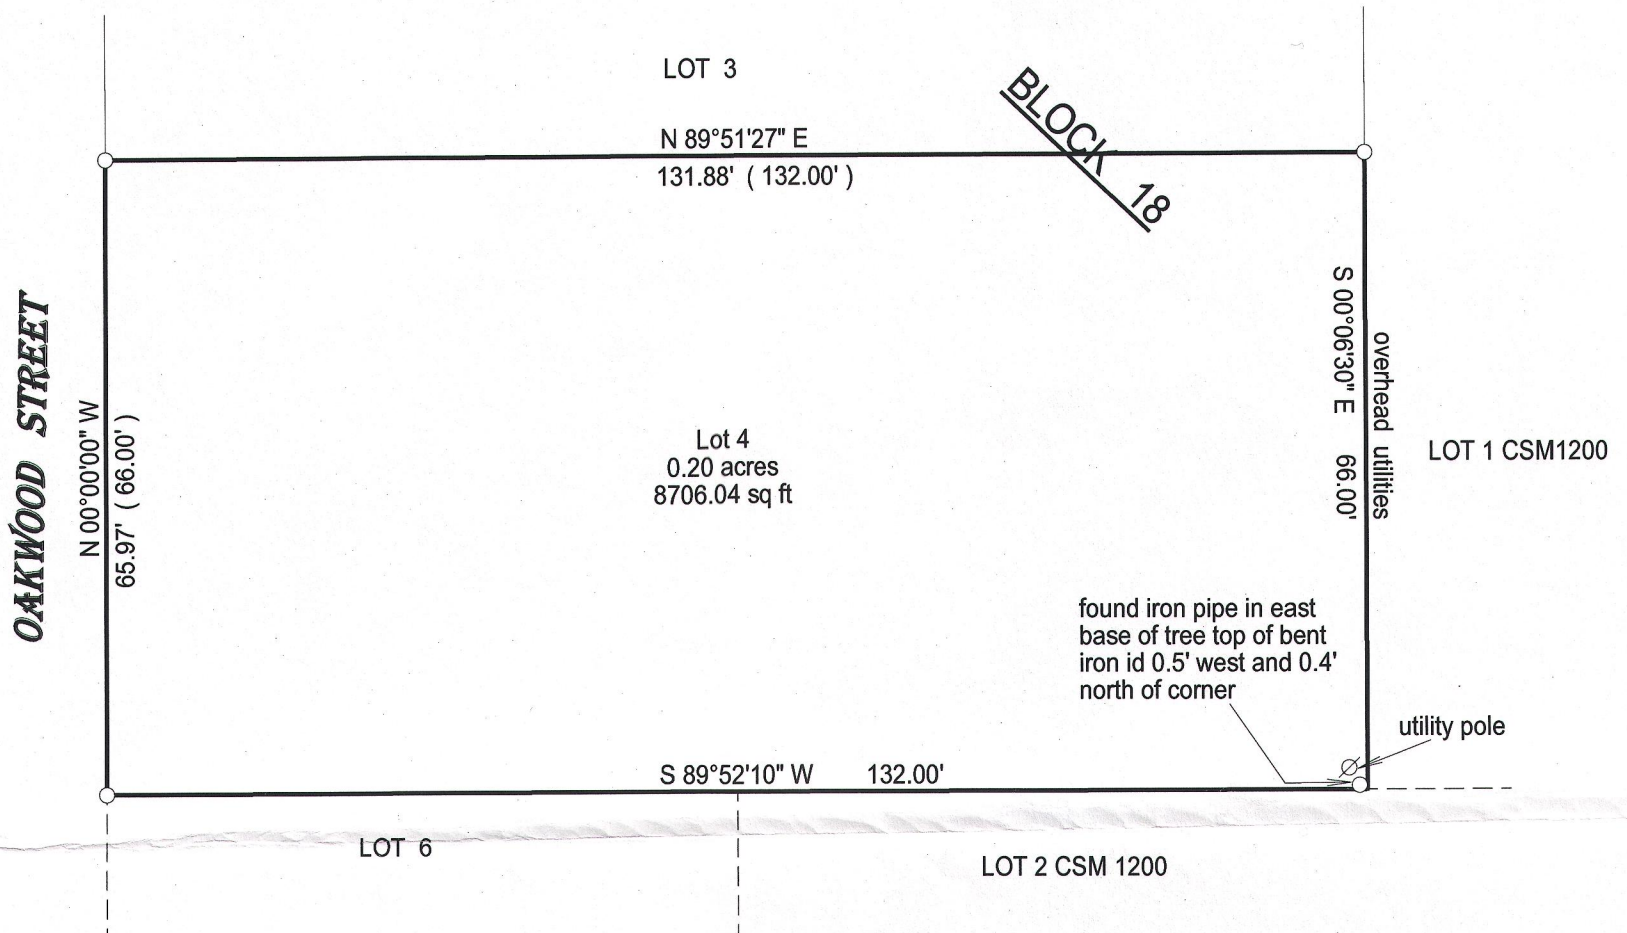

() = recorded as

□ = found iron bar

○ = found iron pipe

● = set iron pipe

■ = set iron bar

SCALE 1" = 20'

JOB # 15-59

TAX ID # WOP000246A




BASIS OF BEARING OF THIS PLAT: THE EAST LINE OF OAKWOOD
WAS ASSUMED TO BEAR NORTH.

I hereby certify that I have surveyed the above- described property and the
above map is a true representation thereof and shows the size and
location of the property, its exterior boundaries, the location and
dimensions of all structures thereon, fences, apparant easements and
roadways and visible encroachments if any.

This survey is made for the present owners of the property, and those who
purchase, mortgage, or guarantee the title thereto, within one year from
the date hereof.

DATED THIS 17TH DAY OF MARCH, 2015.

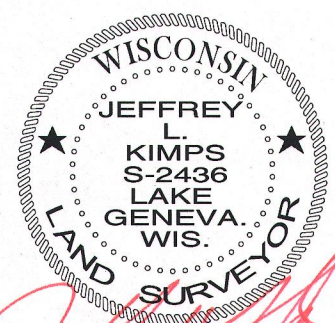

JEFFREY L KIMPS S - 2436
Wisconsin Registered Land Surveyor
(original if signed in red)

WOP-246A

011-2580