

PREPARED FOR
LINDA TONGE
KEEFE REAL ESTATE
LAKE GENEVA WI



PLAT OF SURVEY

- OF -

LOT 154 ORIGINAL CEDAR POINT PARK SUBDIVISION, BEING A
SUBDIVISION IN THE VILLAGE OF WILLIAMS BAY, WALWORTH
COUNTY, WISCONSIN.

PATHFINDER SURVEYING INC.
(formerly)
J.K. SURVEYING INC.
P.O BOX 322
LAKE GENEVA, WI. 53147
WWW.PATHFINDERSURVEYING.NET
262-248-8303

C.L. GARFIELD PARKWAY
(50' WIDE)

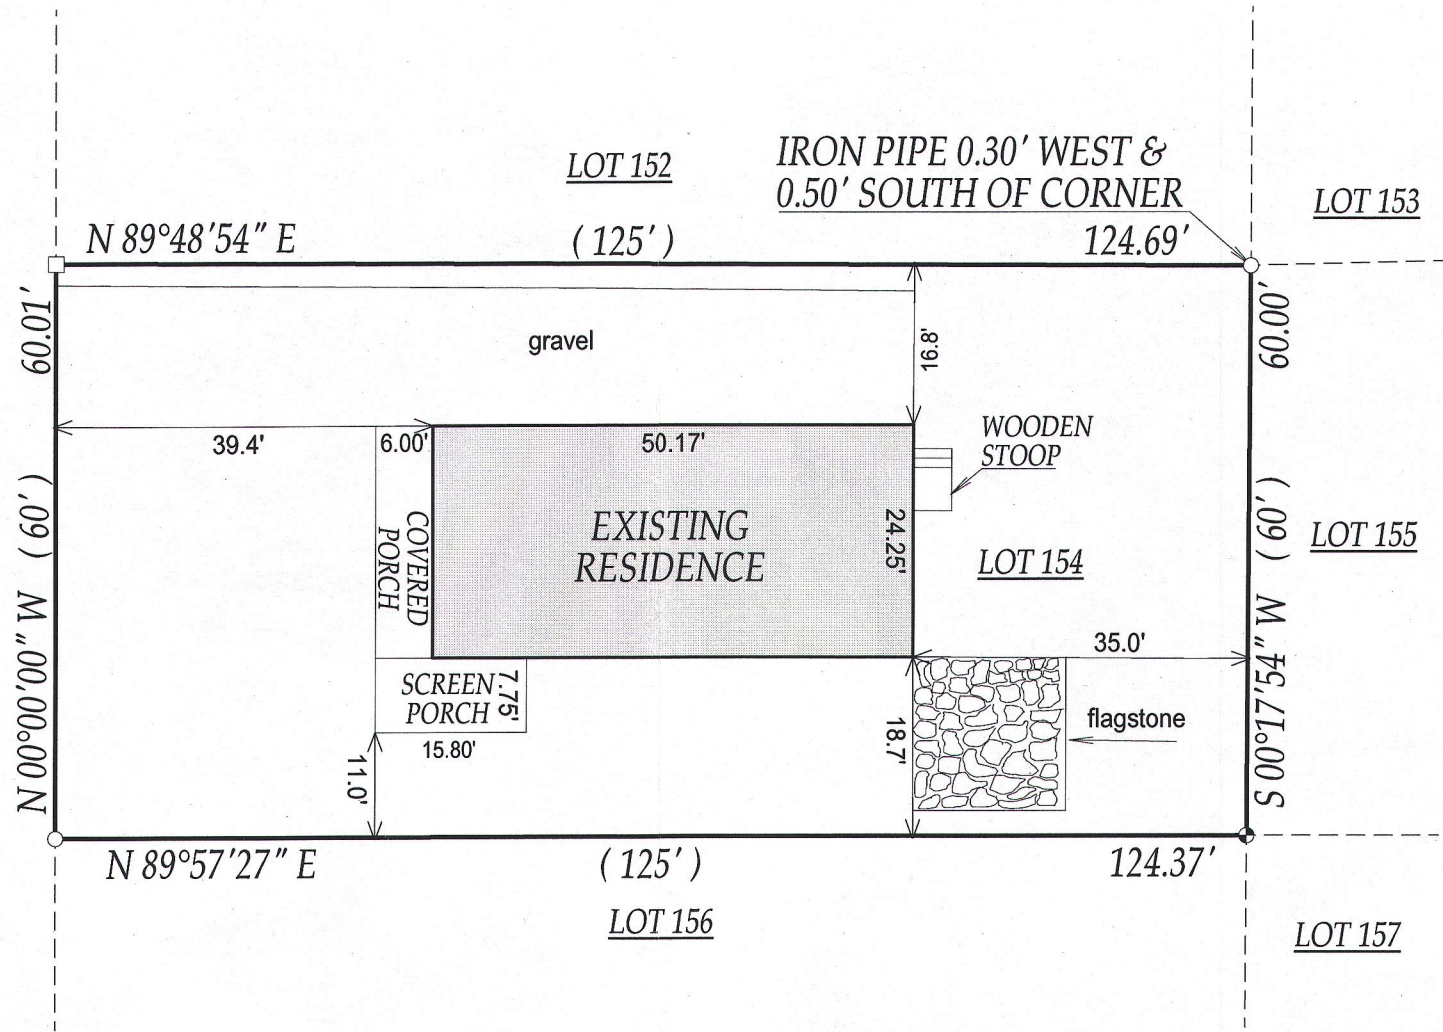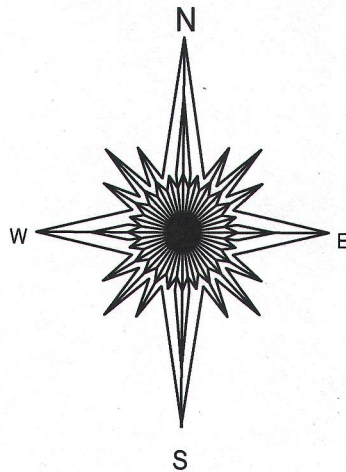

() = RECORDED AS

□ = FOUND IRON BAR

○ = FOUND IRON PIPE


■ = SET IRON BAR

● = SET IRON PIPE

SCALE: 1" = 20'


JOB #: 15-170 / 03-067UPDATE

TAX ID #: WCP 127

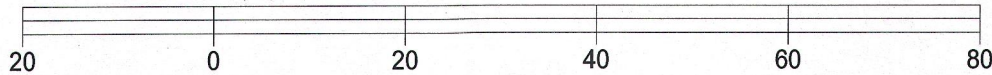

BASIS OF BEARING OF THIS PLAT: THE EAST LINE OF GARFIELD WAS ASSUMED
TO BEAR NORTH.

"I hereby certify that I have surveyed the above described property and that
the above map, to the best of my knowledge and belief, is a true representation
thereof and shows the size and location of all visible structures, apparent
easements and encroachments if any."
This survey is made for the present owners of the property, and those who
purchase, mortgage, or guarantee the title thereto, within one year from
the date hereof.

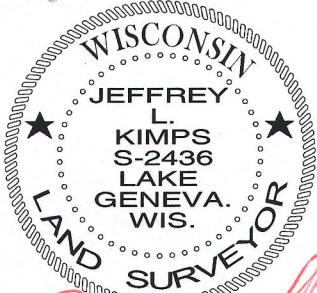

JEFFREY L. KIMPS S - 2436
Wisconsin Registered Land Surveyor
(original if signed in red)

WCP-127

011-2599