




CEDAR POINT DRIVE 50'

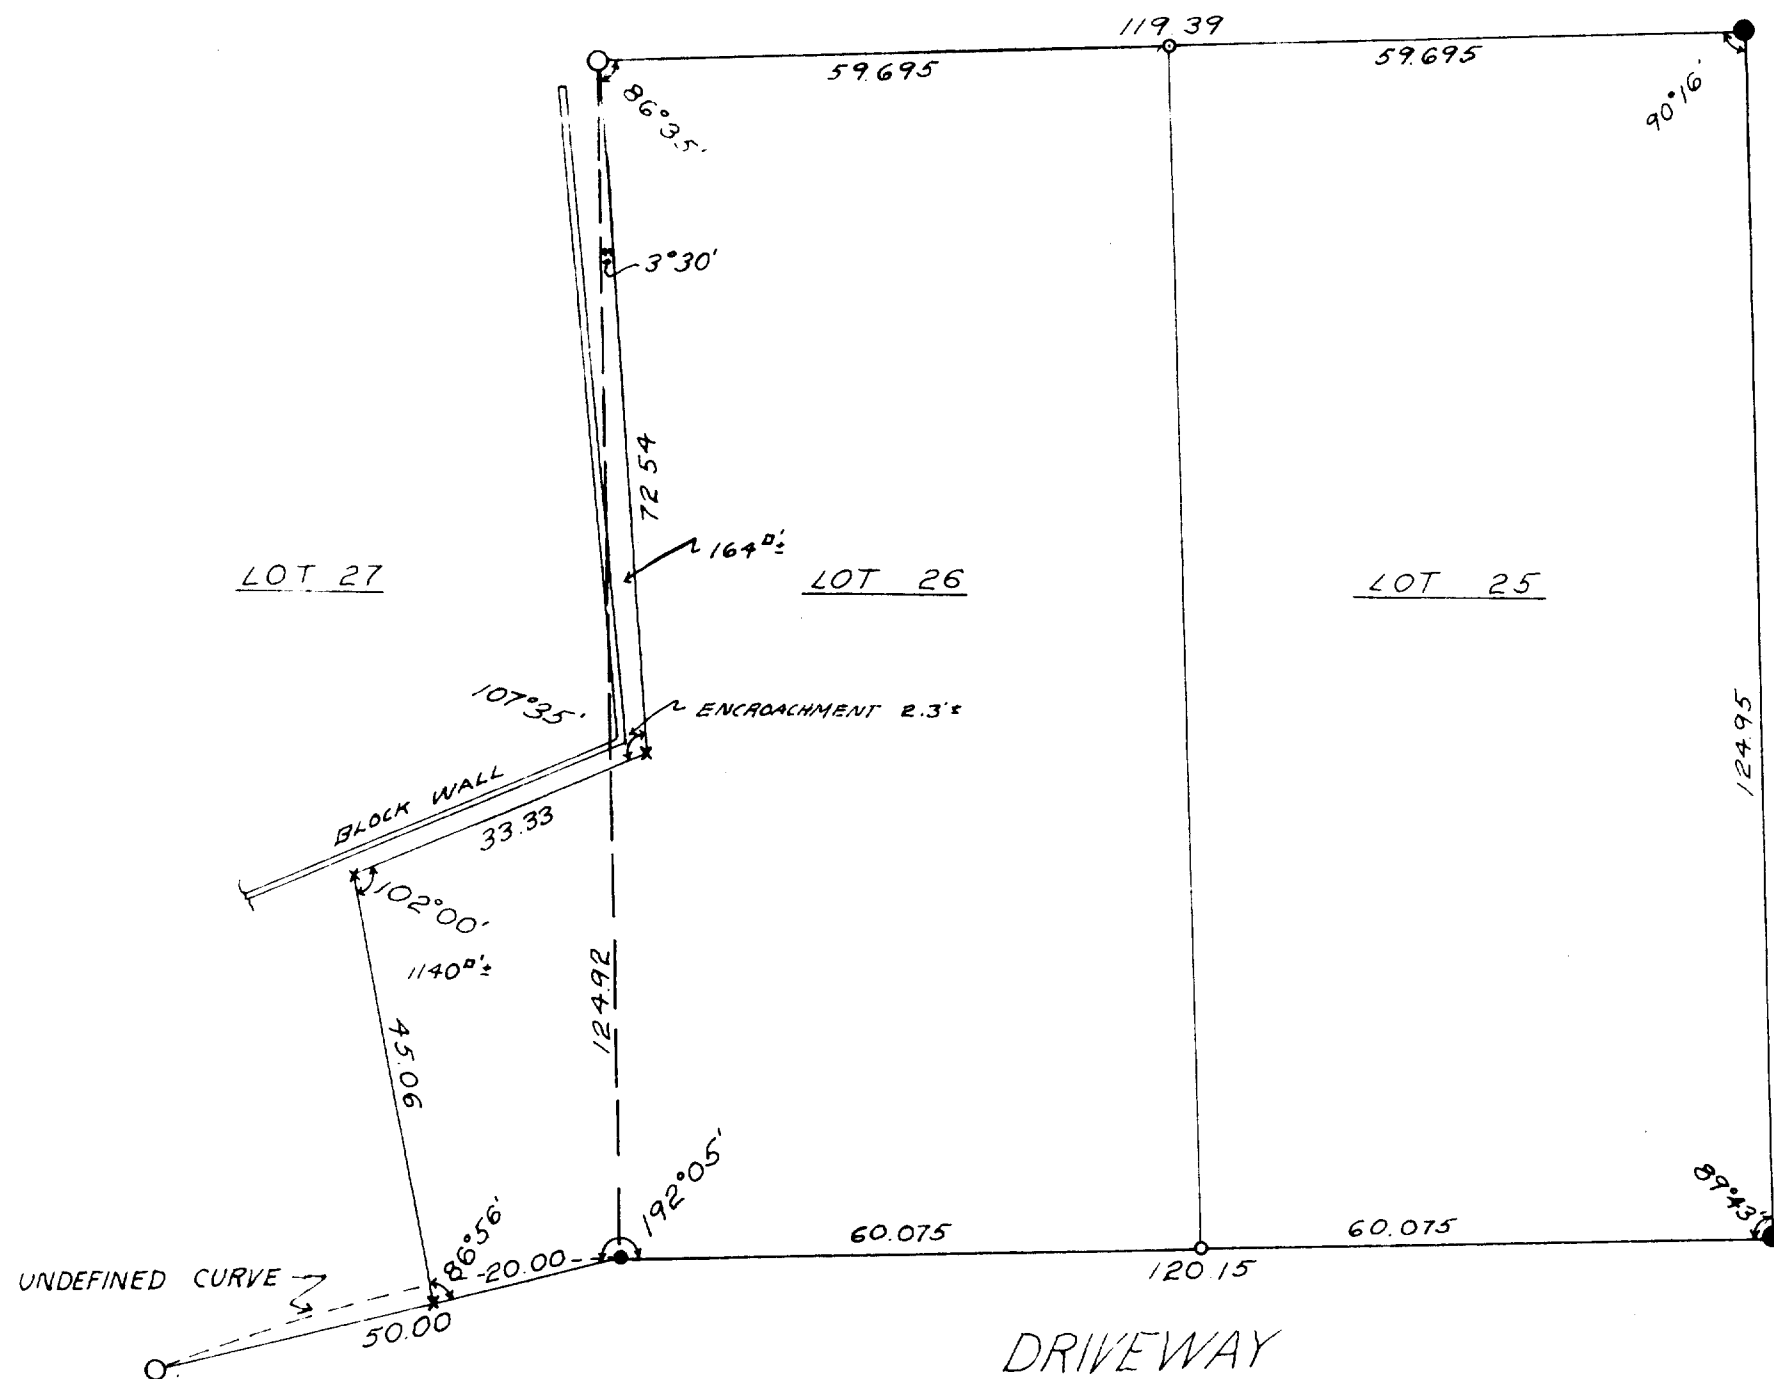

LEGEND

- CONCRETE MONUMENT FOUND
- IRON PIPE FOUND
- IRON PIPE SET
- IRON ROD FOUND
- x SPIKE SET

PLAT OF SURVEY OF

A PARCEL OF LAND IN CEDAR POINT PARK SUBDIVISION
VILLAGE OF WILLIAMS BAY, WISCONSIN

Lloyd R. Jansen
SURVEYOR

SCALE 1" = 20'

DATE 11-13-70