


N  
 SCALE ~ 1" = 40'  
 O = IRON PIPE

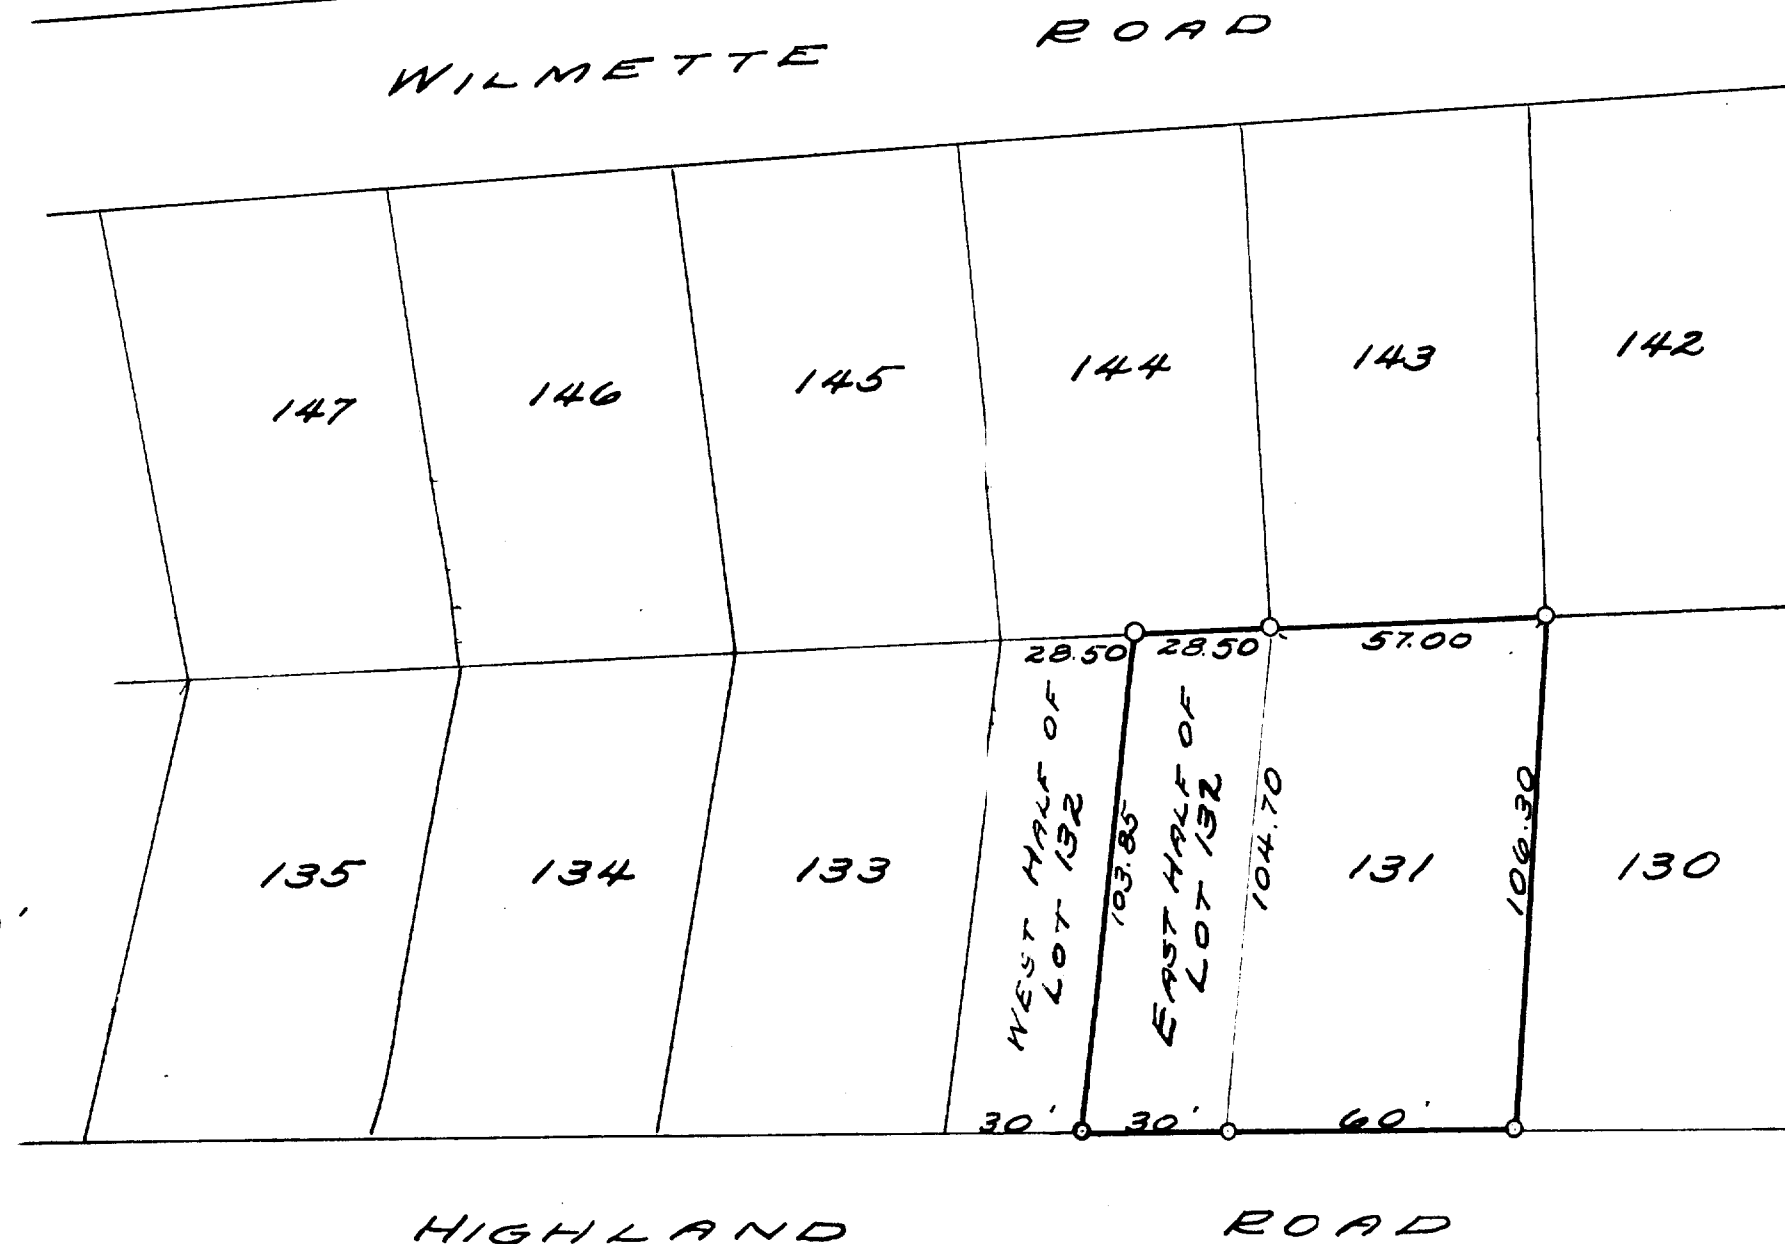

PLAT OF SURVEY OF LOT 131 AND THE EAST HALF OF LOT 132  
 OF THE SECOND ADDITION TO CEDAR POINT PARK, A SUBDIVISION  
 LOCATED IN THE VILLAGE OF WILLIAMS BAY, WALWORTH CO., WISC.

MAY 23, 1946

*H.E. Johnson*  
 SURVEYOR