


PREPARED FOR:
WENDY WAFFLE
1092 MOBILE ST.
LAKE GENEVA, WI 53147

PLAT OF SURVEY


-OF-

LYNCH & ASSOCIATES
ENGINEERING CONSULTANTS, LLC.
405 SKYLINE DRIVE, SUITE C
LAKE GENEVA, WI 53147
(262) 248-3697

LOTS 43 & 44, SUMMER HAVEN SUBDIVISION, VILLAGE OF WILLIAMS BAY,
WISCONSIN, COUNTY OF WALWORTH, STATE OF WISCONSIN.

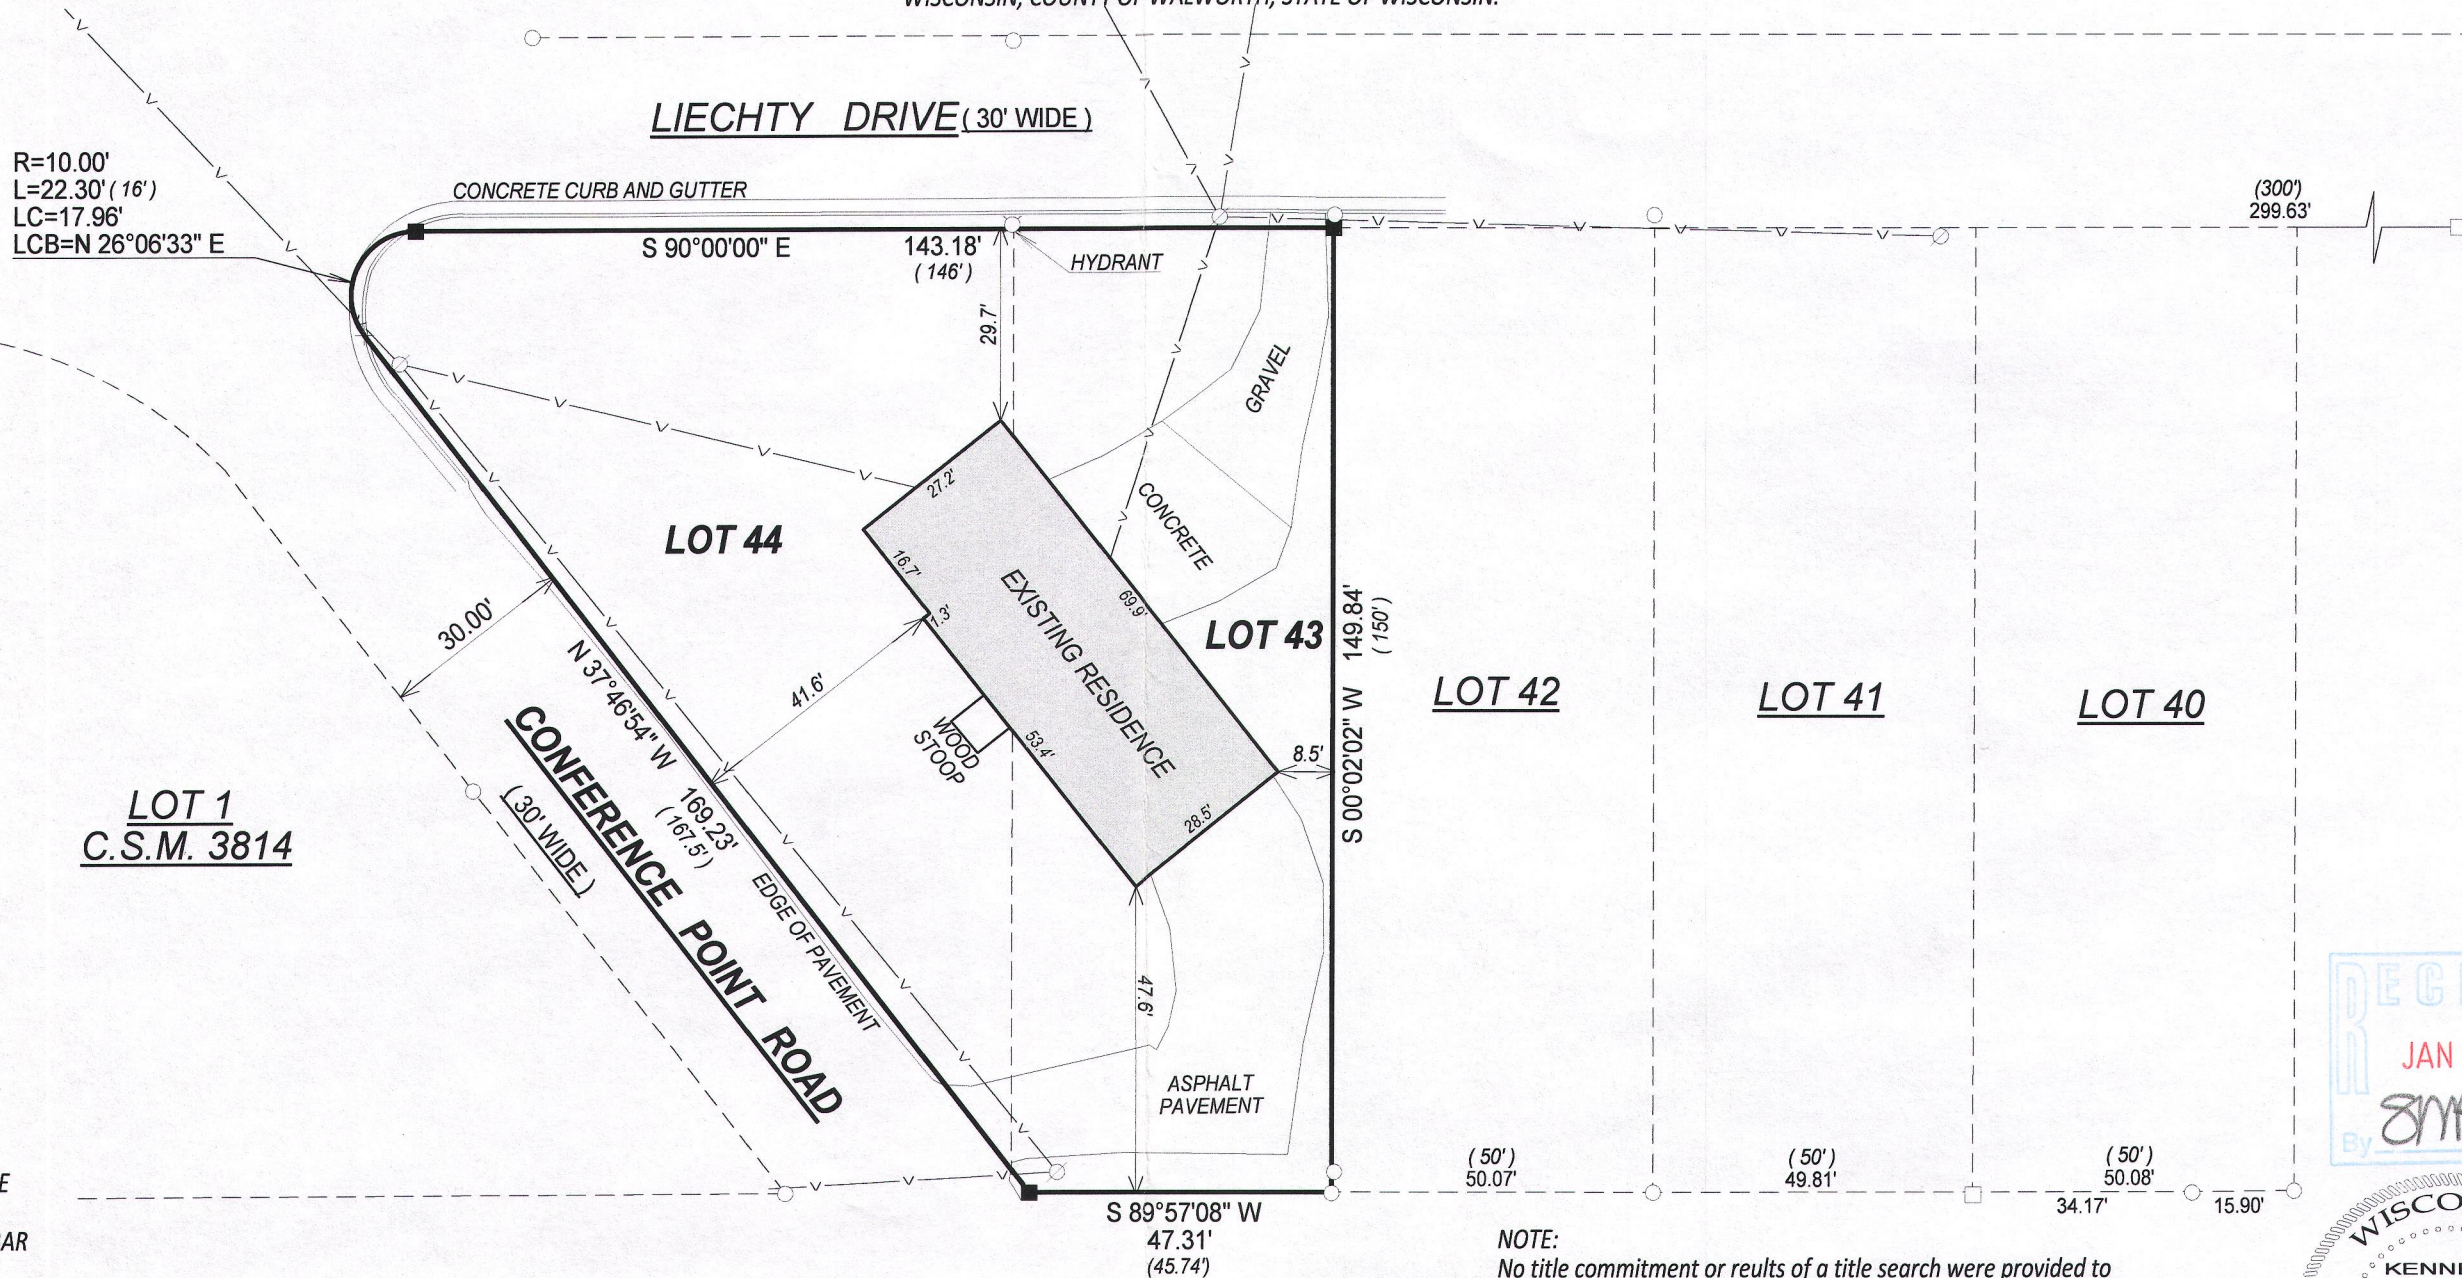

JOB # 15-635
TAX ID # WSU-00038

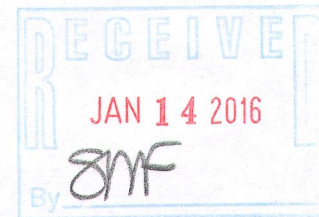

DATED THIS 28th DAY OF OCTOBER, 2015

KENNETH B. MEHRING S - 2838
Wisconsin Professional Land Surveyor
(original if signed in red)

011-2625