


PREPARED FOR:
DAN PLOUGH
11508 N. OAKVIEW CT.
MEQUON, WI 53092

PLAT OF SURVEY

-OF-


LOT 62 IN WILLABAY WOODS, ACCORDING TO THE RECORDED
PLAT THEREOF. SAID LAND BEING IN THE VILLAGE OF
WILLIAMS BAY, WALWORTH COUNTY, WISCONSIN.

LYNCH & ASSOCIATES
ENGINEERING CONSULTANTS, LLC.
405 SKYLINE DRIVE, SUITE C
LAKE GENEVA, WI 53147
(262) 248-3697

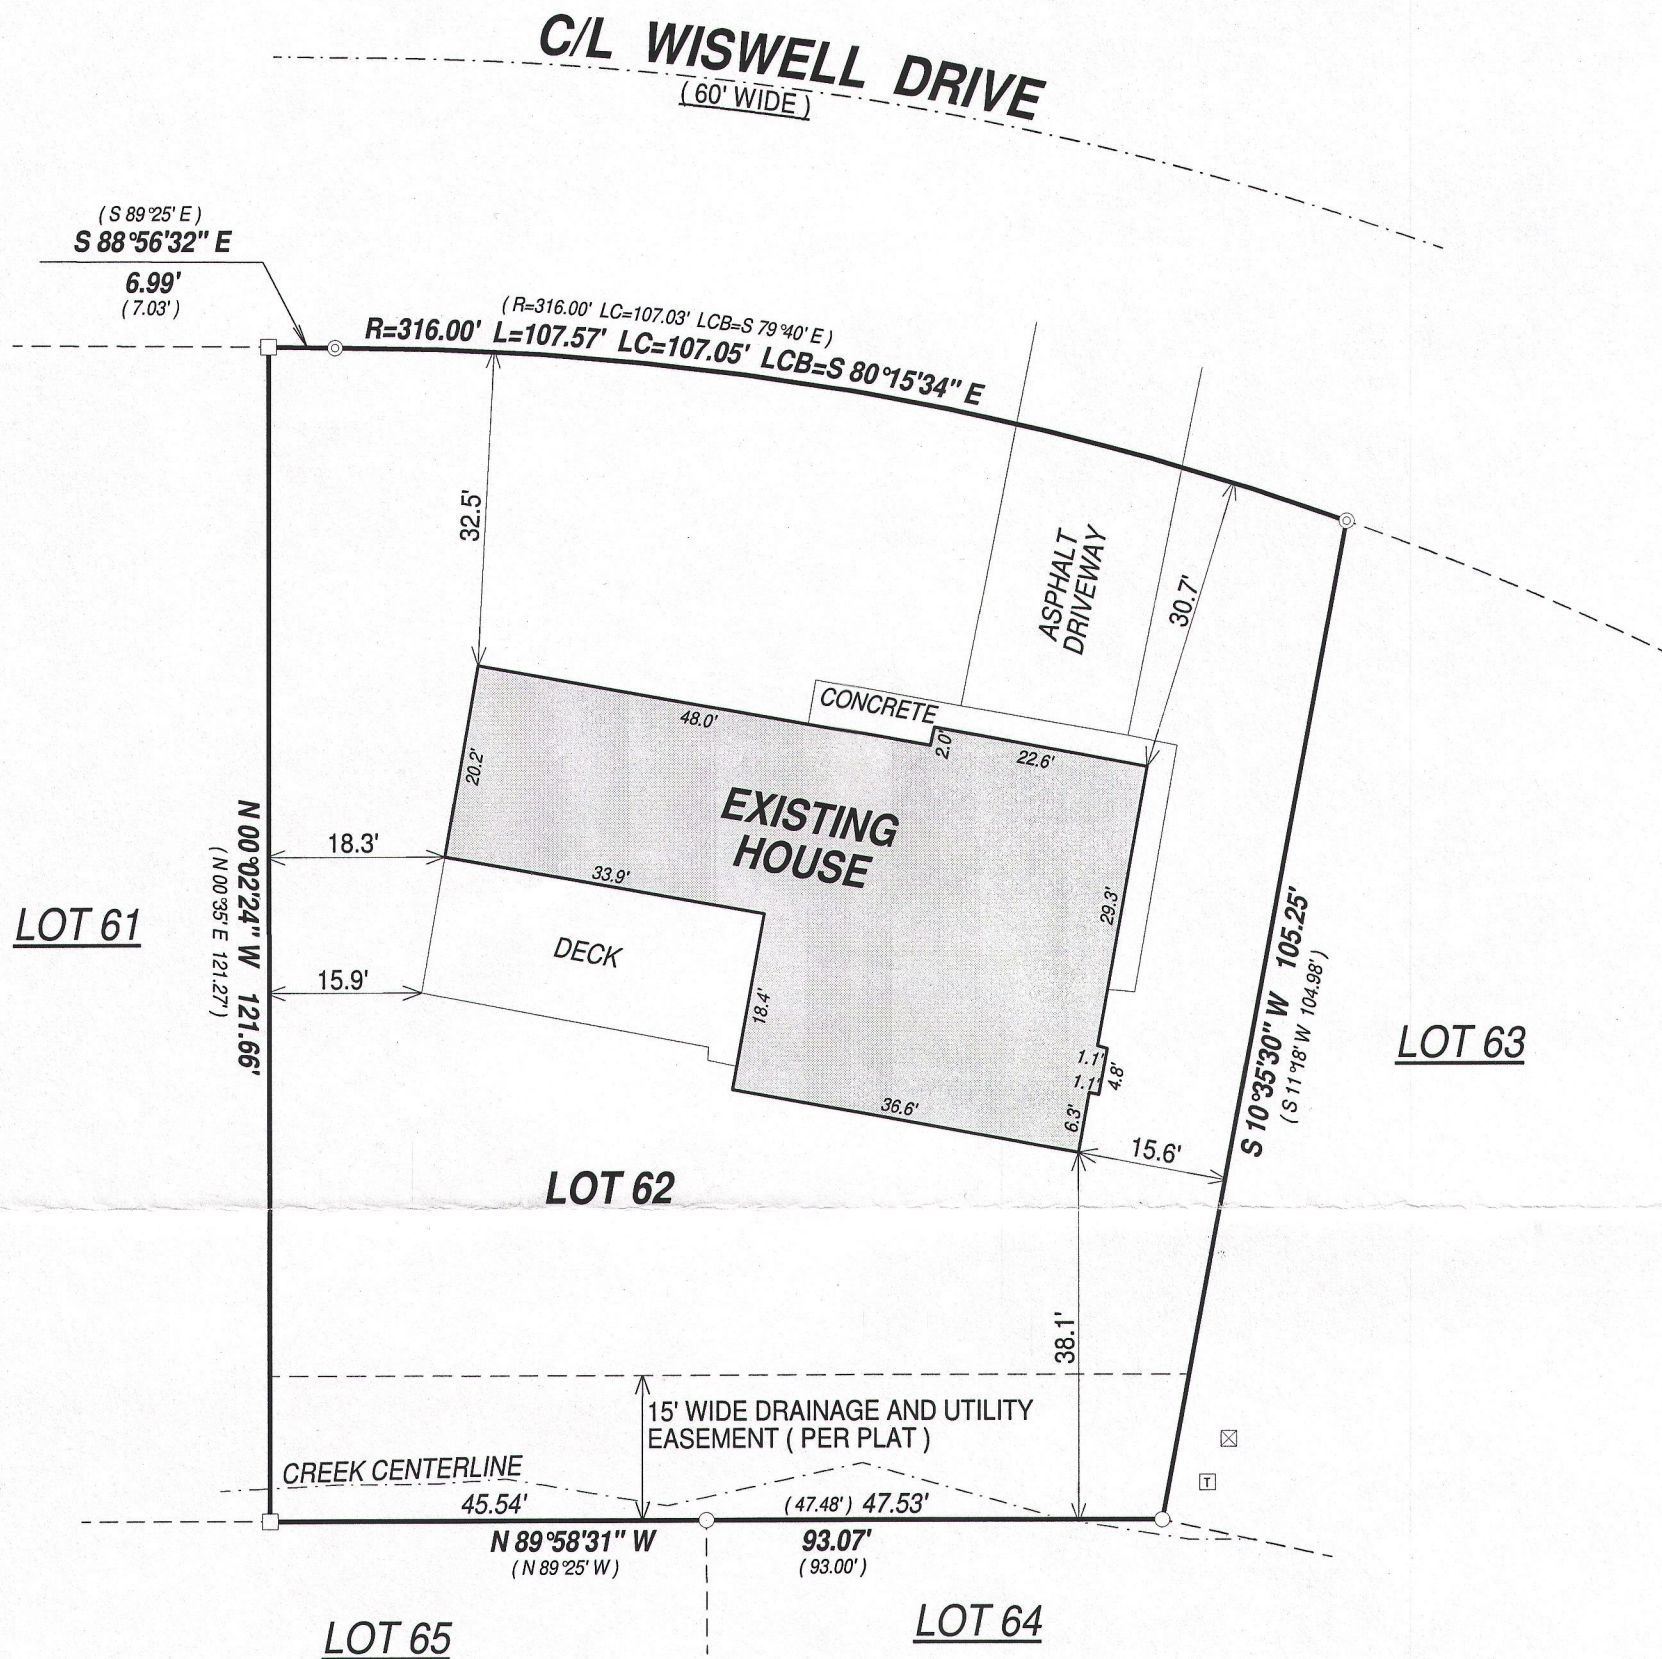

LEGEND

- FOUND 1" IRON PIPE
- ⊙ FOUND 2" IRON PIPE
- FOUND 5/8" IRON BAR
- (XX) RECORDED AS
- ⊠ UTILITY PEDISTAL
- ⊞ TRANSFORMER

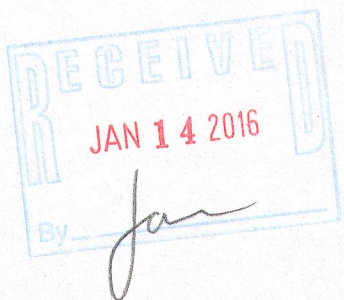

NOTE:

No title commitment or results of a title search were provided to this office pertaining to this survey. This Plat Of Survey may not reflect easements of record, encumbrances, restrictions, ownership, title evidence, or other facts that a current and accurate title search may disclose.

I have surveyed the above-described property and the above map is a true representation thereof and shows the size and location of the property, its exterior boundaries, the location and dimensions of all structures thereon, fences apparent easements and roadways and visible encroachments. if any.

This survey is made for the exclusive use of the present owners of the property, and also those who purchase, mortgage, or insure the title thereto within one (1) year from date hereof; and as to them I warrant the accuracy of said survey map.



DATED THIS 6th DAY OF AUGUST, 2015

KENNETH B. MEHRING S - 2838
Wisconsin Professional Land Surveyor
(original if signed in red)

JOB # 15-616
TAX ID # WUW 000062