


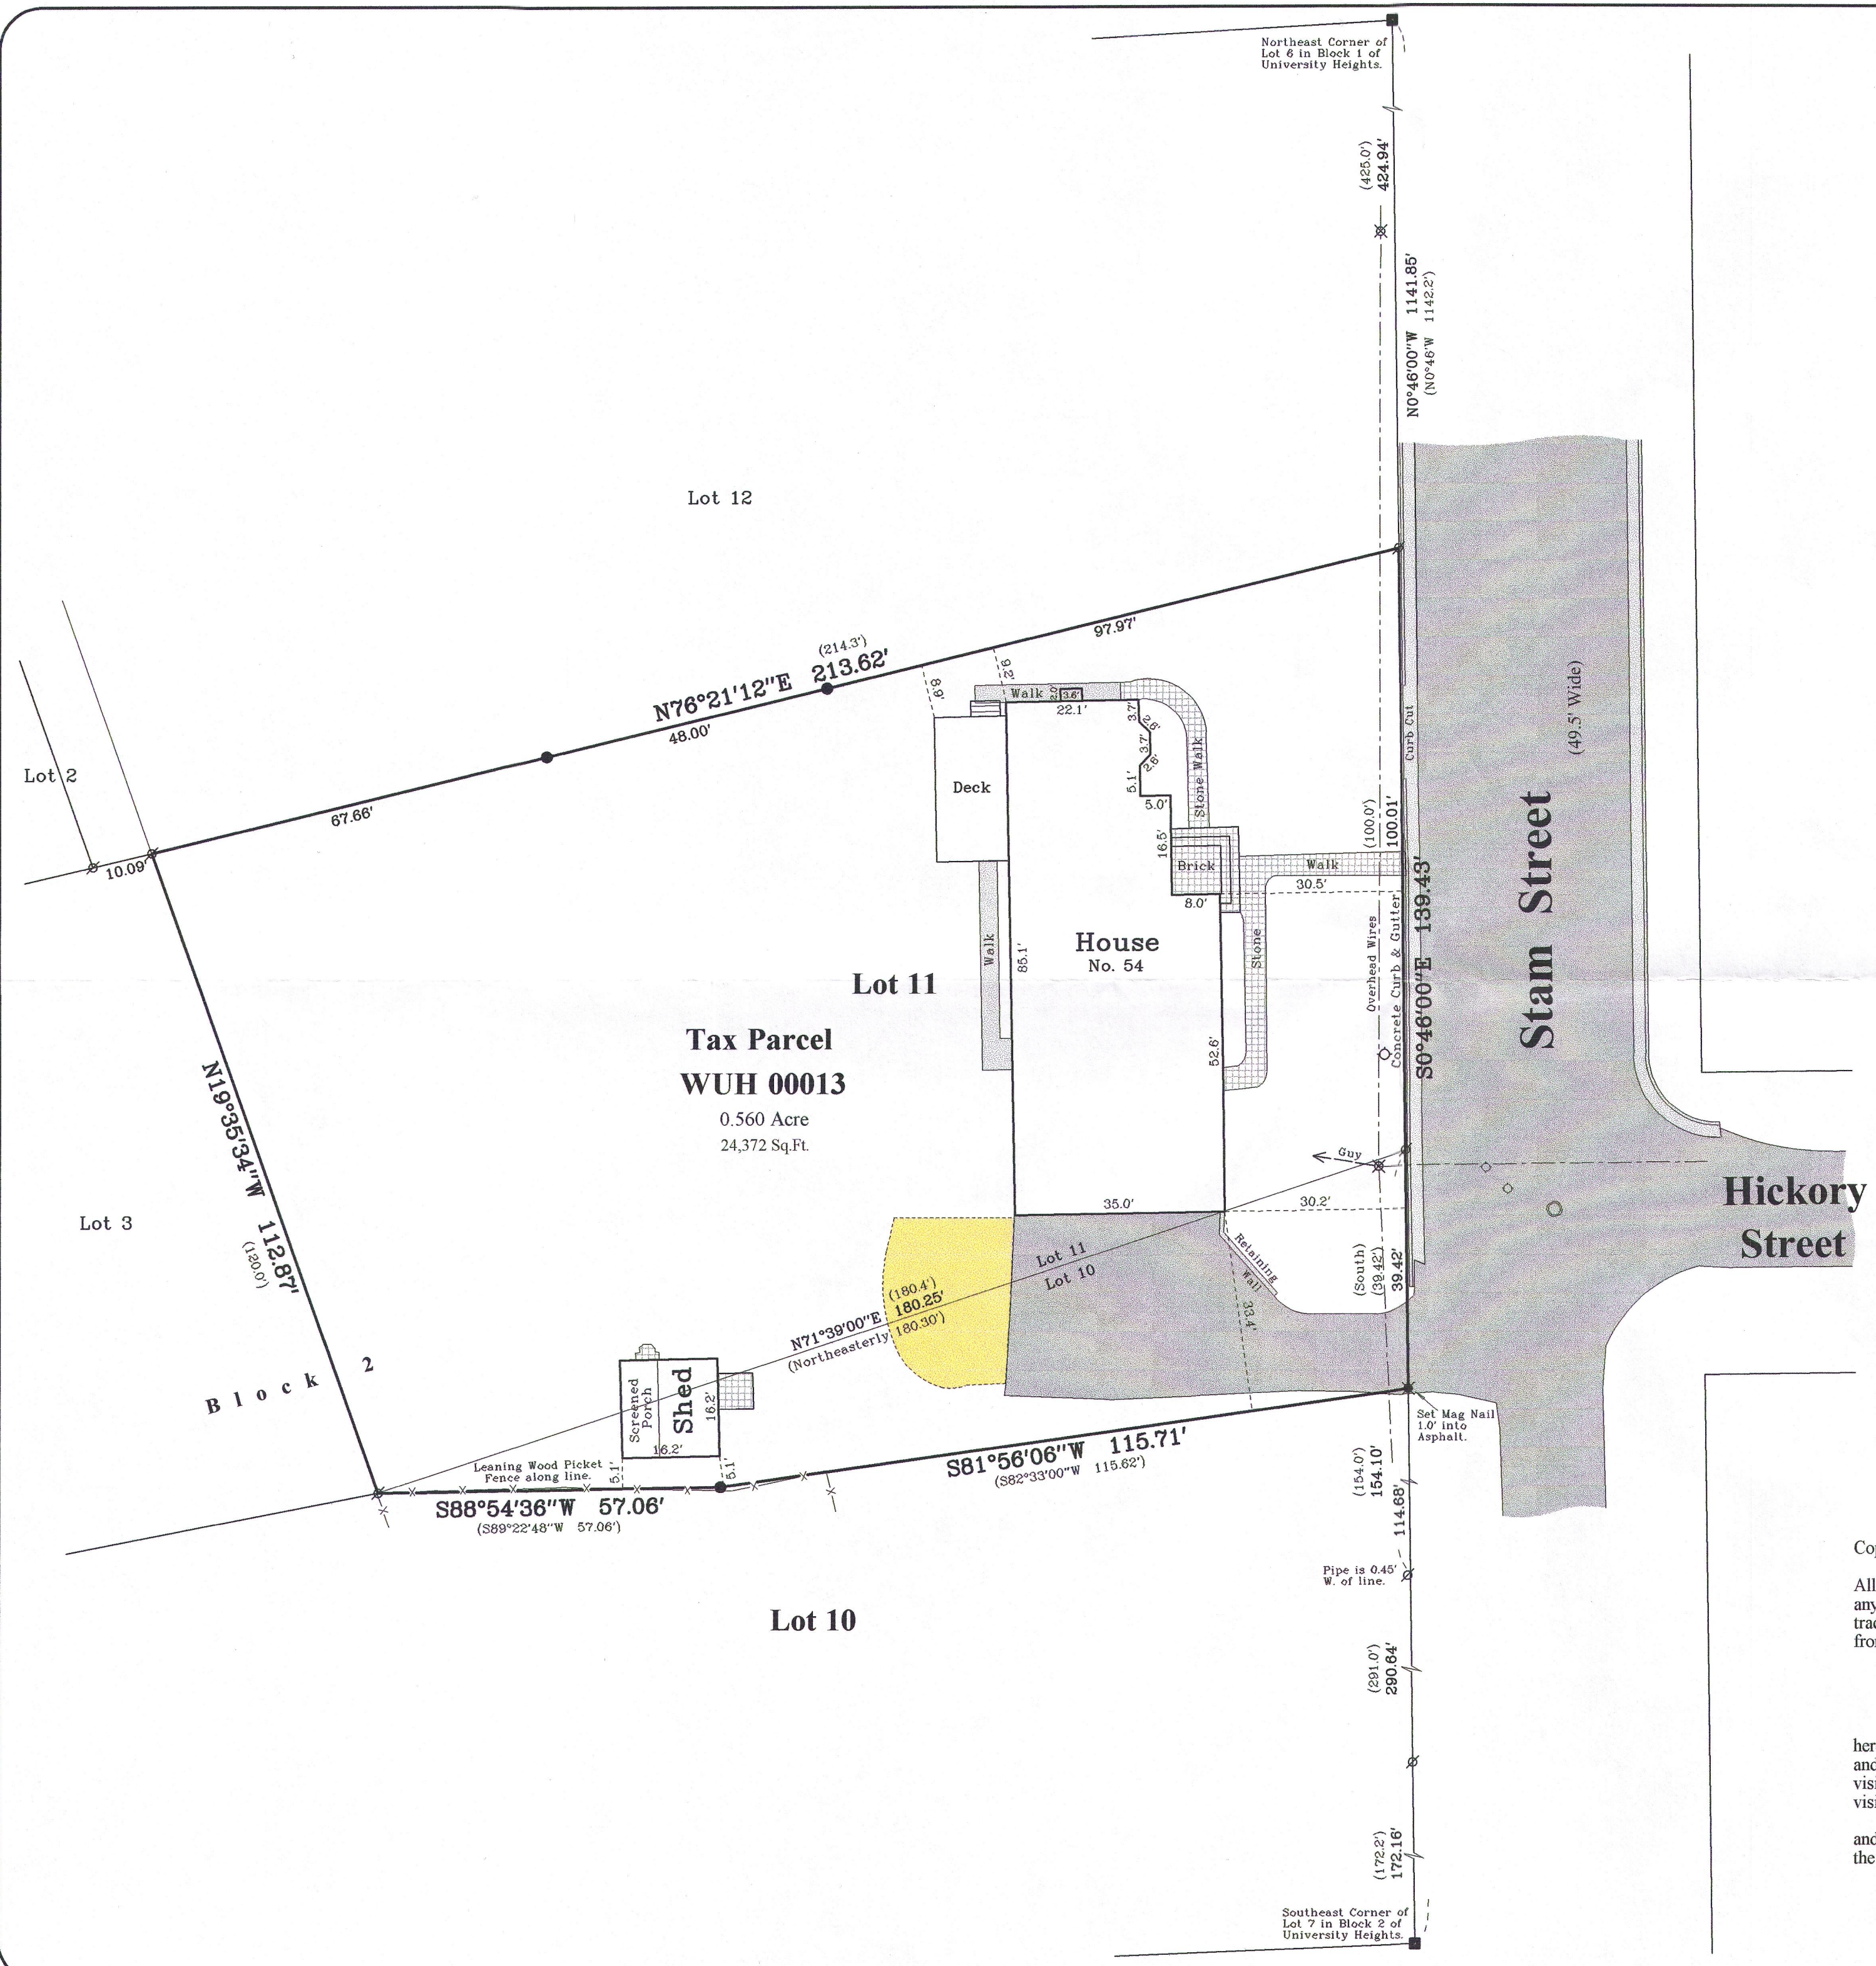




# Plat of Survey

of

Lands described in a Quit Claim Deed recorded July 18, 2005 as Document No. 646905 as shown below:

Lot 11 in Block 2 of University Heights and that part of Lot 10, in said Block 2 of University Heights described as follows: Beginning at the Northeast Corner of said Lot 10, thence South along the East line of said Lot 10, 39.42 feet; thence S 82° 33' 00" W 115.62 feet; thence S 88° 22' 48" W 57.06 feet to the Southwest Corner of Lot 11 of said Block 2; thence Northeasterly along the South line of said Lot 11, 180.30 feet to the place of beginning, all in the Village of Williams Bay, Walworth County, Wisconsin.

Surveyed for: **Linda Petracca**  
1843 West Huron  
Chicago, Illinois. 60622

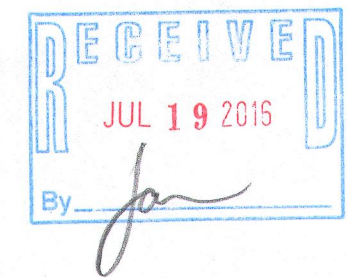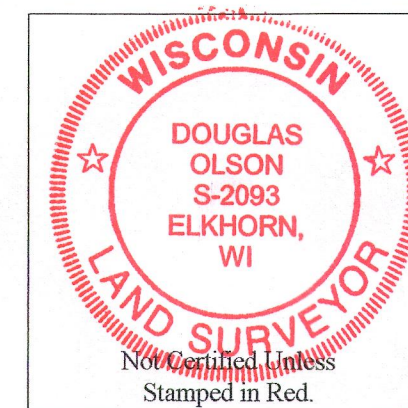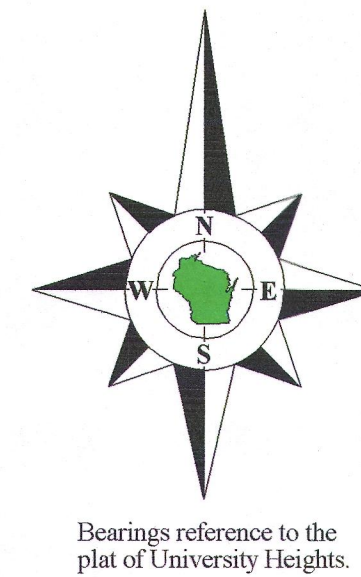

### Notes:

- 1) This survey plat is not certified unless signed and sealed in red ink.
- 2) This survey is subject to Wisconsin lien laws. This Plat of Survey is the notice of intent to file lien. Lien waiver required.

Copyright 2016 by Olson Land Surveying, LLC.


All rights reserved. No part of this survey plat may be reproduced or transmitted in any form by any means - graphic, electronic, or mechanical, including photocopying, tracing, or information storage and retrieval systems - without permission in writing from Douglas G. Olson, Olson Land Surveying, LLC.

I hereby certify that I have surveyed the above described property and the map hereon is correct to the best of my professional knowledge and belief and shows the size and location of the property, its exterior boundaries, the location and dimensions of all visible structures thereon, boundary fences, apparent easements and roadways and visible encroachments, if any.

This survey is made for the exclusive use of the present owners of the property, and also those who purchase, mortgage or guarantee title thereto, within one year from the date hereof.

Douglas G. Olson  
Wisconsin Professional Land Surveyor - 2093

Survey Date: April 5, 2016.  
Revisions:

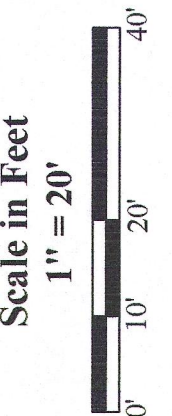

**Olson Land Surveying, LLC**



45 South Wisconsin Street \* P.O. Box 322 \* Elkhorn, Wisconsin. 53121  
Telephone: (262) 723-3434 \* Facsimile: (262) 723-8044  
Email: doug@olsonsurveying.com

| Legend                  |                  |
|-------------------------|------------------|
| Found Concrete Monument | Manhole          |
| Found Iron Pipe         | Water Valve      |
| Found Iron Rod          | Gravel           |
| Set Mag Nail            | Concrete Surface |
| Set Iron Nail           | Stone/Brick      |
| Utility Pole            |                  |
| Fire Hydrant            |                  |
| Asphalt Surface         |                  |

|                     |                      |
|---------------------|----------------------|
| Sheet 1 of 1 Sheets | Job Reference Number |
|                     | 2016-020             |

2016.020

WUH-13

011-2643