


HAROLD H. KOLB

REGISTERED PROFESSIONAL LAND SURVEYOR
LAKE GENEVA, WISCONSIN

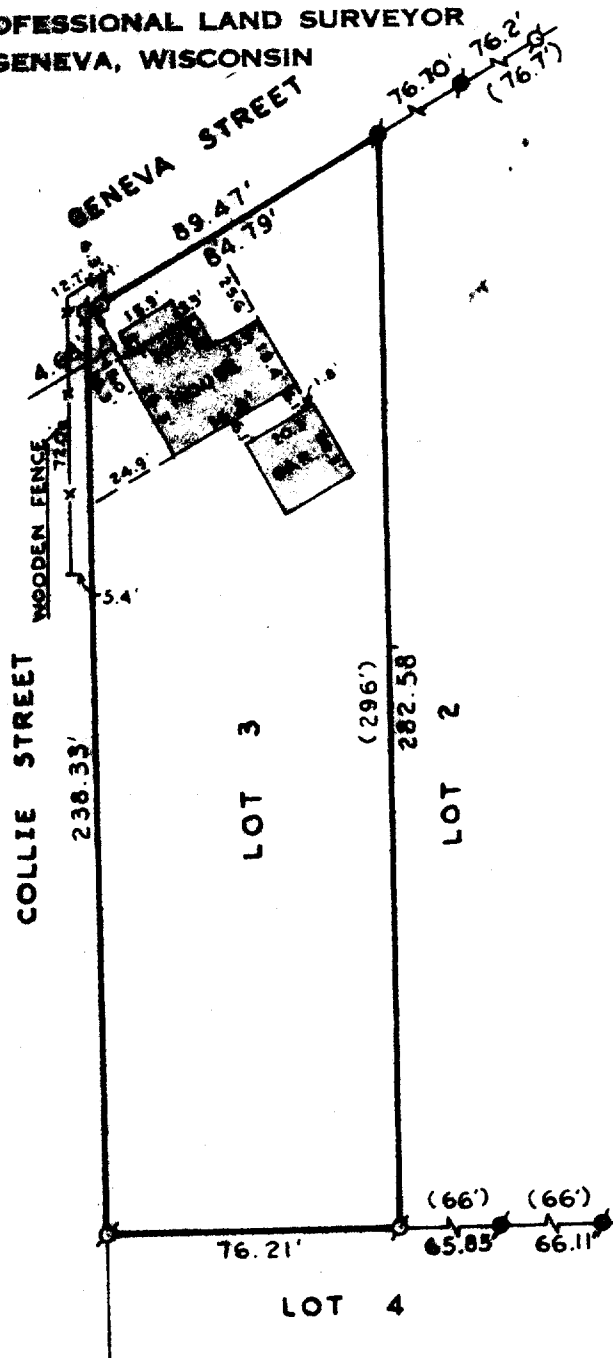

LOT 3, Dodge Street, Lake Geneva, Wisconsin.

Note: Geneva Street has been widened, as shown in the decreased length of the East line of Lot 3.


N



SCALE: 1"=50'

LEGEND

- φ — IRON PIPE FOUND
- o — IRON PIPE PLACED
- ✕ — IRON PIPE FOUND
- x — SPIKE
- () — IRON PIPE FOUND

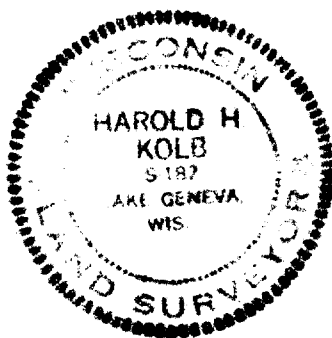

I, HAROLD H. KOLB, DO HEREBY CERTIFY THAT I HAVE SURVEYED THE PROPERTY HEREON DESCRIBED ACCORDING TO THE OFFICIAL RECORDS, AND THAT THE PLAT HEREON IS A CORRECT REPRESENTATION OF THE LOT LINES.

Harold H. Kolb

HAROLD H. KOLB
WISCONSIN REGISTERED LAND SURVEYOR, S-187
DATE 10/22, 1974